STATE OF VERMONT
AGENCY OF TRANSPORTATION

TRAFFIC SIGN SUMMARY SHEET

VAOT Metric

MILE MARKER, STATION, OR SIGN NUMBER	SIGN LEGEND	SIGN DIMENSIONS: EA	SIGN DIMENSIONS: WIDTH (mm)	SIGN DIMENSIONS: HEIGHT (mm)	NEW & SALVAGED SIGNS: "A"	NEW & SALVAGED SIGNS: "B"	NEW & SALVAGED SIGNS: SALV SIGN	NEW & SALVAGED SIGNS: SALV TIS	EXIST POST: RETAIN	EXIST POST: SALVAGE	NO. OF POSTS	NEW SIGN POSTS (OPTION ITEMS): FLANGED CHANNEL kg/m 1.7	FLANGED CHANNEL kg/m 3.0	FLANGED CHANNEL kg/m 4.5	SQUARE STEEL (mm) 44, kg/m 3.4	SQUARE STEEL 50, kg/m 3.9	SQUARE STEEL 63, kg/m 5.0	ANCHOR	SLEEVE	TUBULAR ALUMINUM Ø (mm) 75, kg/m 1.9	TUBULAR ALUMINUM 100, kg/m 2.5	TUBULAR ALUMINUM 100 MOD, kg/m 2.5	FOUNDATION	TUBULAR STEEL Ø (mm) 75, kg/m 11.3	TUBULAR STEEL 89, kg/m 13.4	TUBULAR STEEL 100, kg/m 16.1	TUBULAR STEEL 125, kg/m 21.7	W-SHAPE STEEL: FTG. SIZE 600 mm	W-SHAPE STEEL: FTG. SIZE 750 mm	W-SHAPE STEEL: MASS KG	W-SHAPE STEEL: POST SIZE	SIGN FRAME REQUIRED	REMARKS	SIGN DETAIL: DETAIL ON SHEET NUMBER	SIGN DETAIL: STD. SHEET NUMBER
INT. #16 RAMP D STA. 0+352 RT		1	750	750	0.56						1			X																			R3-2		E-143
INT. #16 RAMP D STA. 0+368 LT	ONE WAY	1	900	300	0.27						2		X																				R6-1R SIGN DAMAGED BY AN ACCIDENT WAS REPLACED		E-142
INT. #16 NORTHBOUND MM. 97.56	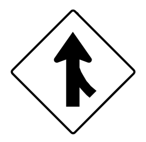	1	1200	1200	1.44						2			X																			W4-1R		E-150
INT. #16 VT. ROUTE 25 MM. 0.898 RT	JCT	1	525	375	0.20																												M2-1		E-135
	INTERSTATE 91	1	600	600	0.36						1			X																			M1-1		E-135
INT. #16 VT. ROUTE 25 MM. 0.964 RT		1	900	900	0.81						2			X																			W6-1		E-151
INT. #16 END OF MED. MM. 0.932 MM. 0.933 MM. 0.935		3	600	750	1.35																												R4-7		E-144
	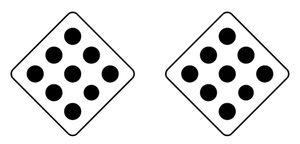	6	450	450	1.22						3			X																			OM1-1		E-150
INT. #16 VT. ROUTE 25 MM. 0.935 RT	↑ BARRE 29	1	1800	300	0.54																														E-123
	↑ WAITS RIVER 12	1	1800	300	0.54																														E-123
	← FAIRLEE 6	1	1800	300	0.54																														E-123
	← WHITE RIVER JCT. 28	1	1800	300	0.54																														E-123
	WELLS RIVER 13 →	1	1800	300	0.54																														E-123
	ST JOHNSBURY 32 →	1	1800	300	0.54						2												2	X											E-123
INT. #16 VT. ROUTE 25 MM. 0.935 LT	PIERMONT NH 2	1	1800	300	0.54																												MILEAGE WAS SHOWN INCORRECT ON SUMMARY SHEET.		E-123
	NEWBURY 4	1	1800	300	0.54																												NEW SIGNS WERE ORDERED AFTER PLAN SIGNS ERECTED		E-123
	BRADFORD 10	1	1800	300	0.54						2			X																			NEW SIGNS WERE ORDERED AFTER PLAN SIGNS ERECTED		E-123
												m	m 4.0	m 44.0	m	m	m		EA	kg	kg	kg		kg 90.4	kg	kg	kg								
TOTALS					m² 11.07	m²	EA.	m²				m 48.0			m					kg			EA. 2	kg 90.4				EA.	EA.	kg					

FINAL POST LENGTHS ARE TO BE DETERMINED IN THE FIELD. POST SIZES ARE COMPUTED BASED ON INFORMATION FURNISHED ON THE STANDARD SHEETS AND THE TRAFFIC & SAFETY DIVISION'S "SIGN POST DESIGN GUIDELINE."

PROJECT NAME: HARTFORD-NEWBURY
PROJECT NUMBER: IM 091-2(69)

FILE NAME: M:\Projects\99a046\Construct... PLOT DATE: 05-JUN-2013 16:0
PROJECT LEADER: J.W TUCKER
DRAWN BY: S.J BIJOLLE
DESIGNED BY:
CHECKED BY: J.D. AUSTIN
SHEET 160 OF 180