EXIT 5 – RAMP B
SOUTHBOUND OFF RAMP

TEMPORARY AND DURABLE 150 mm YELLOW LINE

EXIT 5
SOUTHBOUND OFF RAMP 196 SOLID LT
POLY UREA - LPM 1200

TEMPORARY AND DURABLE 150 mm WHITE LINE

EXIT 5
SOUTHBOUND OFF RAMP 204 SOLID RT POLY UREA - LPM 1200
INTERSTATE 91 38 ~~75~~ DASHED RT THERMOPLASTIC - DOBCO
INTERSTATE 91 113 ~~150~~ DOTTED RT THERMOPLASTIC - DOBCO

TEMPORARY AND DURABLE 300 mm WHITE LINE

EXIT 5
SOUTHBOUND OFF RAMP 52 SOLID LT THERMOPLASTIC - DOBCO
INTERSTATE 91 37 SOLID RT THERMOPLASTIC - DOBCO

TEMPORARY AND DURABLE LETTER OR SYMBOL

EXIT 5
SOUTHBOUND OFF RAMP "STOP"
SOUTHBOUND OFF RAMP "AHEAD"
SOUTHBOUND OFF RAMP "STOP"

TEMPORARY & DURABLE 600 mm STOP BAR

EXIT 5
SOUTHBOUND OFF RAMP THERMOPLASTIC - DOBCO

REMOVING SIGNS

AS SHOWN - 9

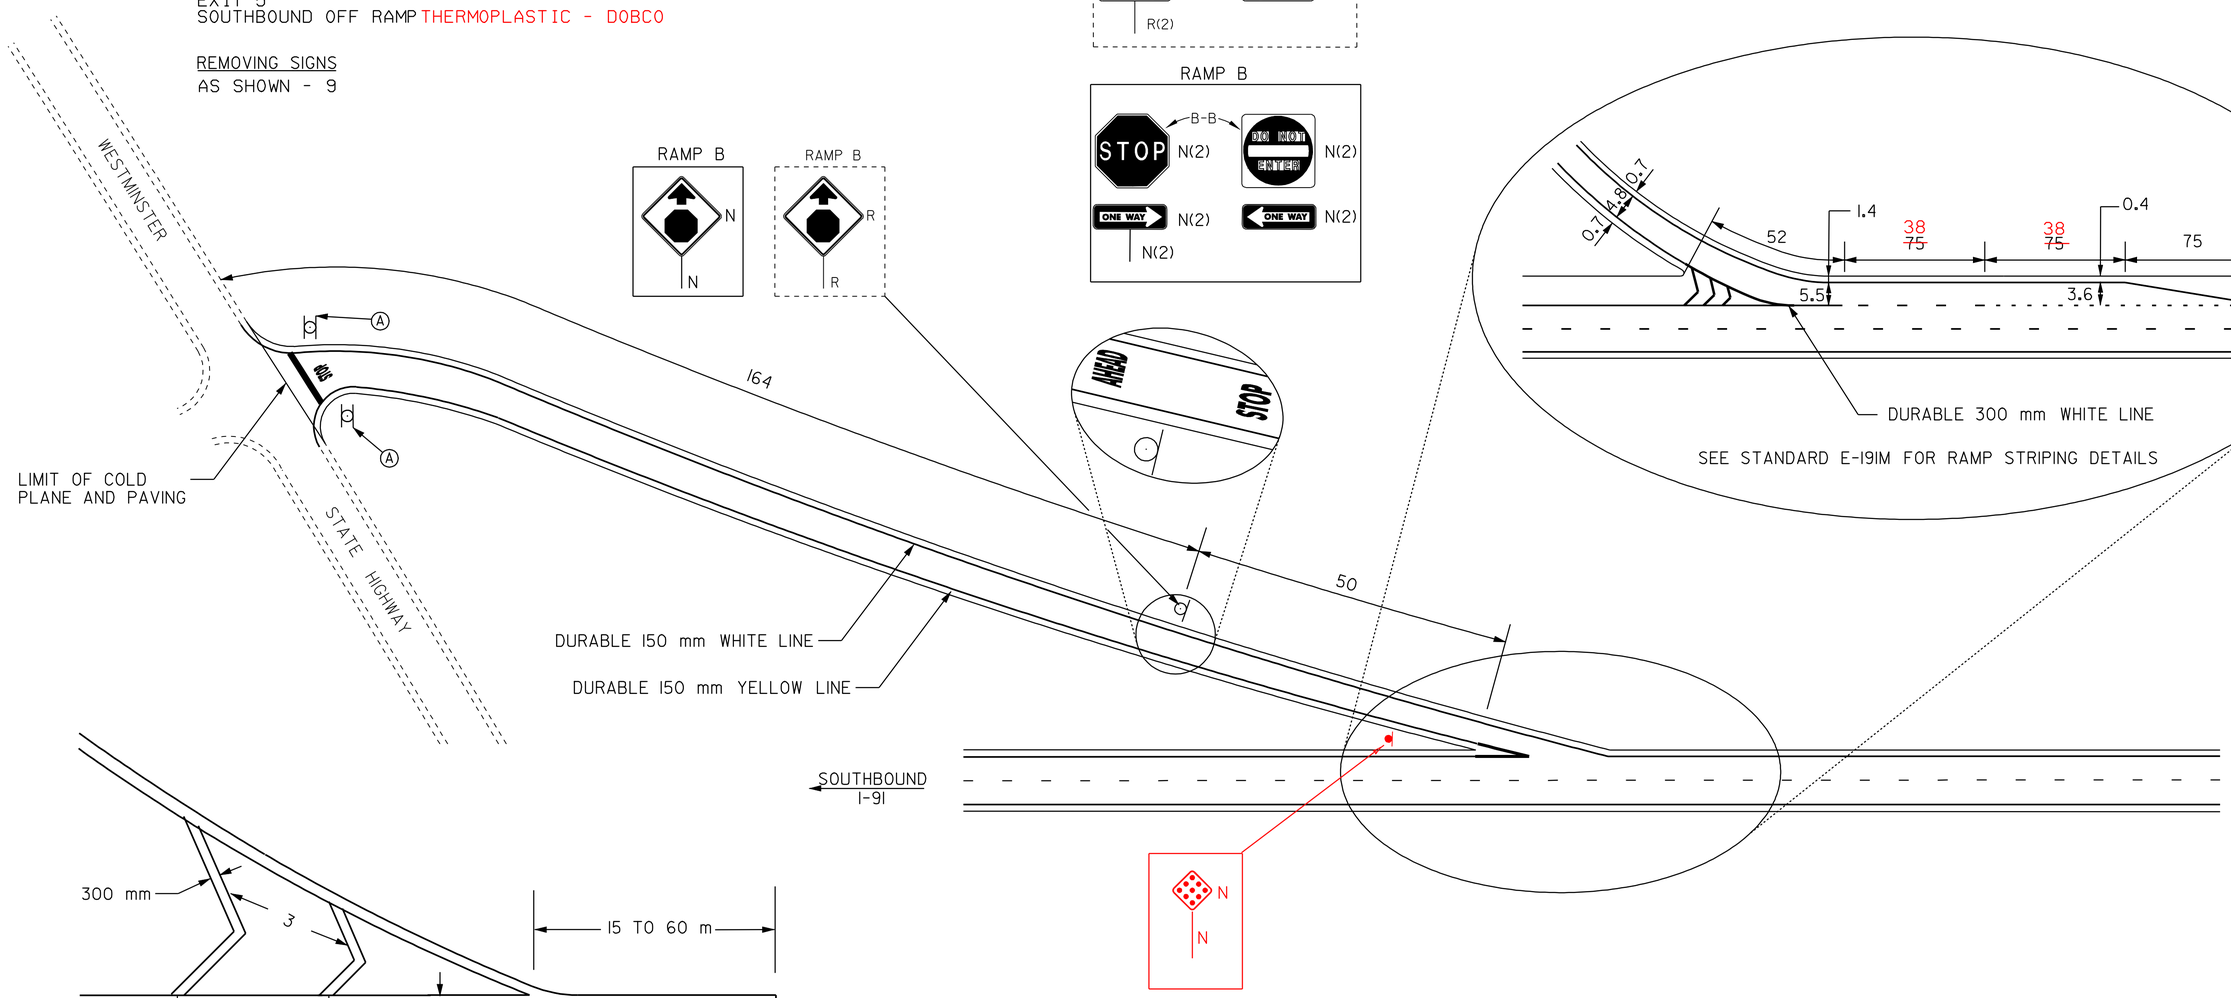

GORE MARKING DETAIL

NOT TO SCALE

LEGEND

R	=	REMOVE EXISTING
S	=	SALVAGE
R&S	=	REMOVE AND SALVAGE
N	=	NEW
RET	=	RETAIN
B-B	=	BACK TO BACK
	=	NEW RAIL
	=	EXISTING RAIL
⊗	=	BORING LOCATION

NOTE: ALL DIMENSIONS IN METERS EXCEPT AS INDICATED

DATUM
VERTICAL
HORIZONTAL

RAMP DETAIL #3

PROJECT: BRATTLEBORO-ROCKINGHAM
PROJECT NO.: IM 091-1(39)
DESIGN FILE NAME: /pave/99a202/pa202.dgn
IPARM FILE NAME: pa202dt03.I
PLOT DATE: 02-JUN-2005
SURVEYED BY: CLD ENGINEERS INC
SURVEY DATE: 10/00
SQUAD LEADER: WRH
DRAWN BY: HJC
SHEET: 19 OF 37