| B. P. R. DIV. NO. | STATE | PROJECT NO. | SHEET NO. | TOTAL SHEETS |
|---|---|---|---|---|
| 1 | VT. | I-89-2 (7) | 72 | 137 |




PLAN
Scale: 3/32" = 1'-0"

CHORD DEFINITION
CURVE DATA (INTERSTATE)

Δ 7°-22'-00" Left
D 0°-36'-00"
R 9549.34'
T 614.7'
L 1227.8
E 19.8'
Bank 1/4" Per F.T.

NOTE: For Notes & References see Sheet No. 71

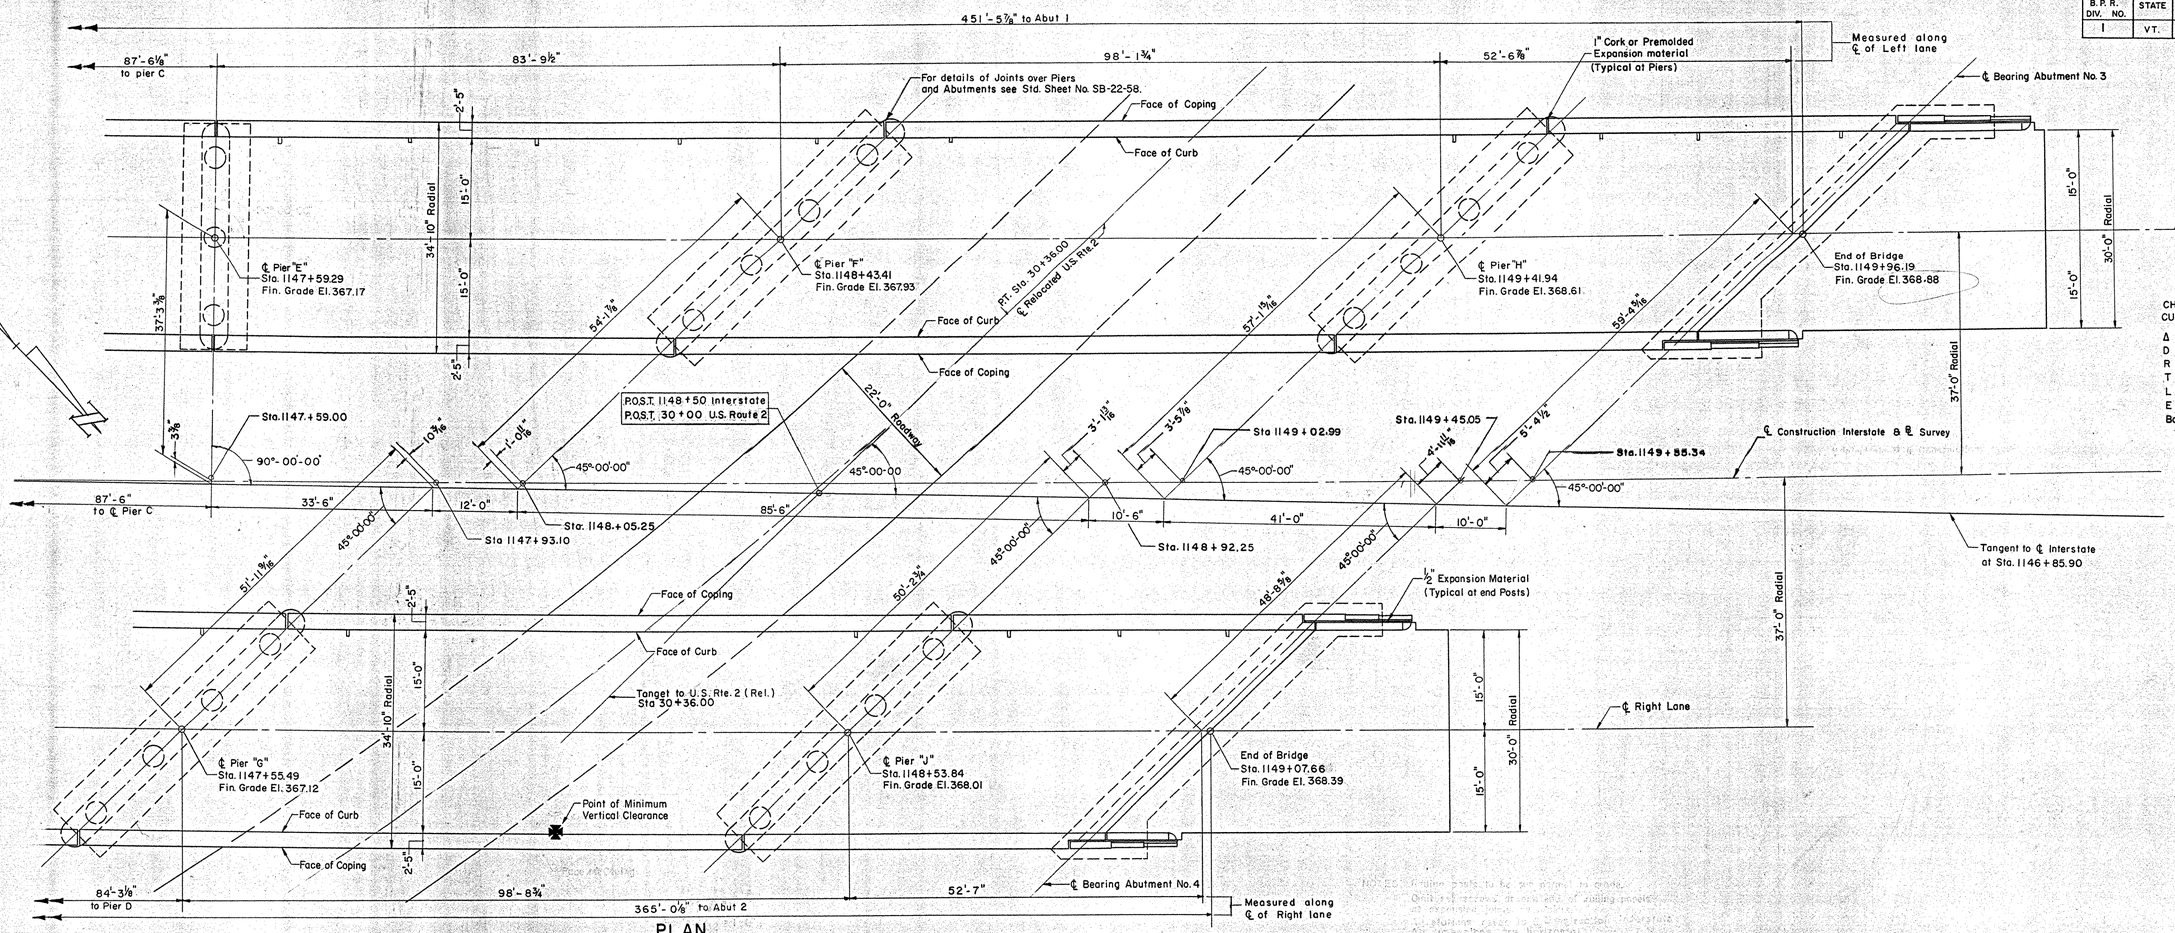


NORTHERLY ELEVATION (RIGHT LANE)
Scale: 3/32" = 1'-0"

## ESTIMATED QUANTITIES

| ITEM NO. | DESCRIPTION | UNIT | NET | OVER-RUN | TOTAL | FINAL |
|---|---|---|---|---|---|---|
| 102 | Borrow | C.Y. | 8000 | ~~880~~ | ~~8800~~ | 8,000 |
| 521 | Stone Fill (Heavy Type) | C.Y. | ~~3100~~ | ~~460~~ | ~~3560~~ | 3,365 |
| 556-C | Granite Bridge Curb Type I | L.F. | ~~1709~~ | — | ~~1709~~ | 1,729 |
| 572 | Bridge Railing (Sup. Agr. 11-3-60) | L.F. | ~~1583~~ | — | ~~1583~~ | 1,610 |

BOLTON IM 089-2(29)
BRIDGES 51 N&S
THIS SHEET FOR REFERENCE ONLY.

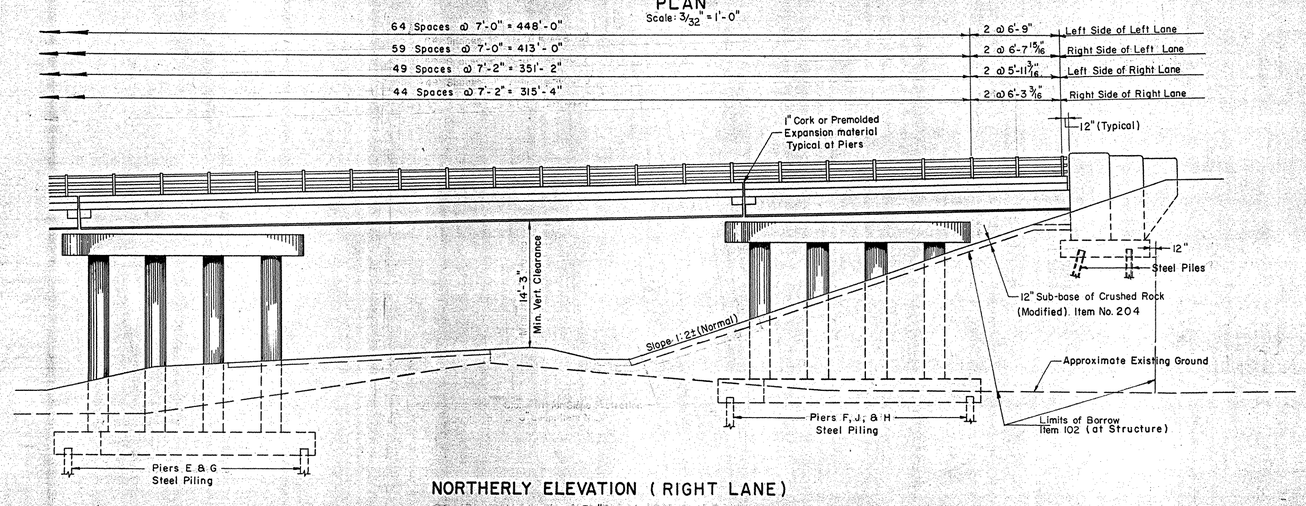CONTRACT NO. 3

# PLAN AND ELEVATION

STATE OF VERMONT
DEPARTMENT OF HIGHWAYS

INTERSTATE PROJECT in the towns of
WATERBURY BOLTON

INTERSTATE STA. 1148+50
OVER
U.S. ROUTE 2 (REL.) STA. 30+00

THE CLARKESON ENGINEERING CO. INC.
CONSULTING ENGINEERS
BOSTON MASSACHUSETTS

| SURVEYED BY | CHECKED BY D.S. & H.M. | SCALE AS NOTED |
|---|---|---|
| DRAWN BY H.B.C. | IN CHARGE J.V.B. | DATE 7-7-58 |

PROJECT NO. I-89-2(7) SHEET 264 OF 307