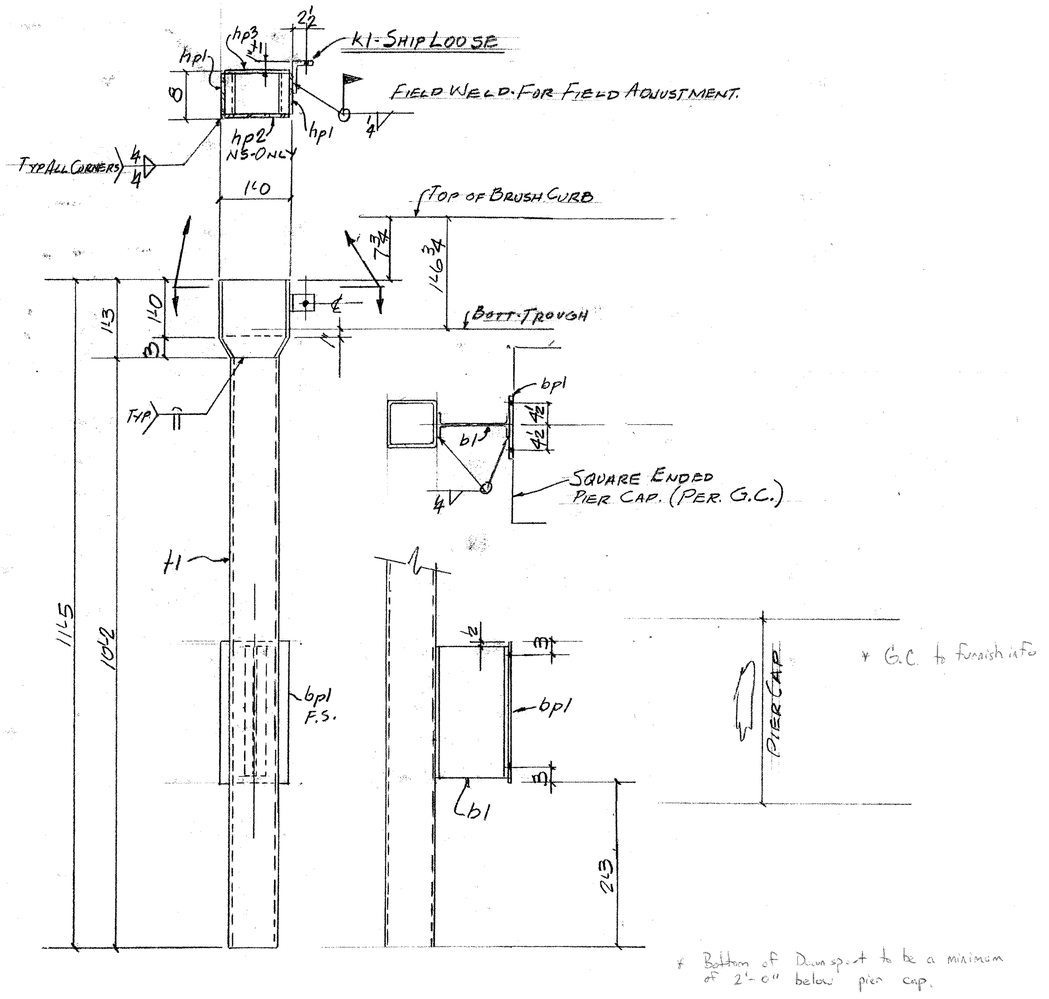

DS1-S - ONE REQ'D. (@ BRIDGE-S1S)

DS1-N - ONE REQ'D (@ BRIDGE-S1N)

SHOP BILL

JOB NO. 253 | DRG. NO. DS1

ABM INFO PAGE	ABM INFO LINE	NO.	DESCRIPTION	FT	IN	ASSEM. MARK	SHIPPING MARK	REMARKS	WEIGHT
		1	DOWNSPOUT	11	5		DS1-S		—
		1	DO	11	5		DS1-N		—
		2	TS 8x8x3/8	10	2	H1		ASTM A500 OR A501	
		4	PL 3/8 x 7 1/4	1	3 5/8	hp1		BEND.	
		2	PL 3/8 x 11 1/4	1	3	hp2			
		2	PL 3/8 x 3		11 1/4	hp3			
		2	L 6x4x1/2		6		K1		
		2	W 12x14	1	11	bl			
		2	PL 3/8 x 12	2	0	bpl			
		10	3/8" ANC. BOLTS HILTI, INC. HIT HY-150 SYSTEM OR EQUAL	1	0		FIELD	PER SUBSECT-14.08	

PAY ITEM 506.60

REV.	REMARKS	DATE	DWN	CHK	APP	Q.A.	NO.	DIA.	LGT	TYPE	WASHER
	OUT FOR APPROVAL	2 16 05									
	OUT FOR APPROVAL	6 15 05									
	ISSUED TO SHOP										
	FIELD & OFFICE										
1	FIELD DIM'S.	6-15	JPF								

PROJECT NO. IM-089-2(29) STATE PROJECT NO.

MATERIAL: M270-G250 | ELECTRODES: PER PROC. | HOLES: 13/16" Ø | SHOP BOLTS:

SURFACE PREP. & PAINT:

GALANIZED AFTER FAB (ASTM-A123)

DESCRIPTION: DOWNSPOUTS - PIER 1

JOB: BRIDGE S1S & S1N

I 89 OVER U.S. ROUTE 2

BOLTON, VT.

CUSTOMER: WINTERSET INC.

	DRAWN BY	DATE
	JPF	1-05
	CHKD BY	
	EJ	
	APPROV BY	
	Q.A.	
	JOB NO.	DRG. NO.
	253	DS1
	83419	REV.

CASCO BAY STEEL STRUCTURES, INC.

75 SPRING HILL ROAD SACO, MAINE 04072

PHONE (207) 282-7360 FAX. (207) 282-1179

TVGA CONSULTANTS

☐ NO EXCEPTIONS TAKEN ☐ REJECTED

☒ FURNISH AS CORRECTED

☐ REVISE AND RESUBMIT

ENGINEER has reviewed Shop Drawings and Samples and other data which Contractor is required to submit, only for conformance with the information given in the Contract Documents and compatibility with the design concept of the completed Project as a functioning whole as indicated in the Contract Documents. Such reviews do not extend to means, methods, techniques, sequences or procedures of construction or to safety precautions and programs incident thereto. Contractor is responsible for dimensions to be confirmed and correlated at the job site; for information that pertains solely to the fabrication processes or to techniques of construction; and for coordination of the work of all trades.

BY: RJC

DATE: 7-21-05