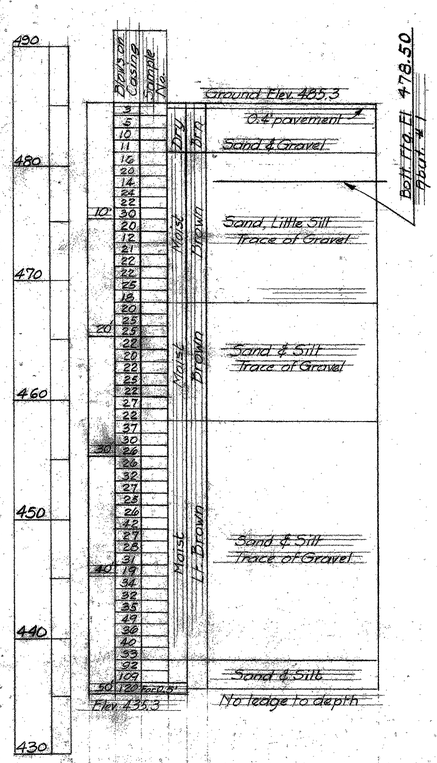

B-2

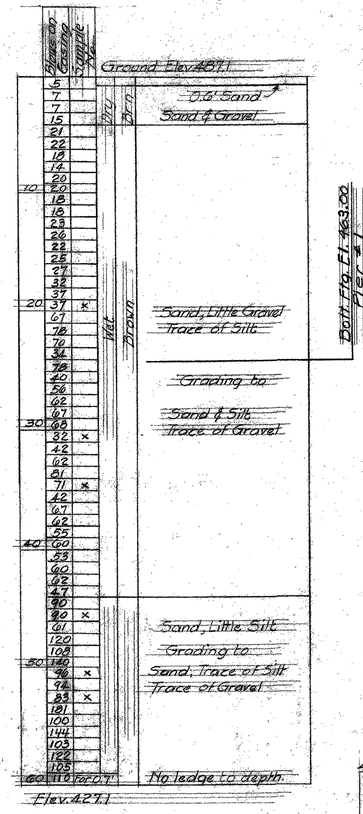

B-5

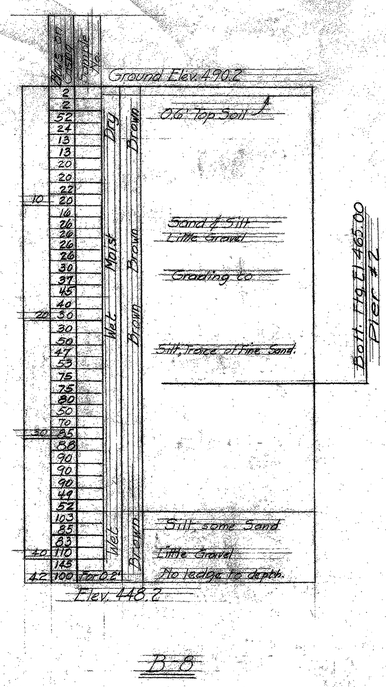

B-8

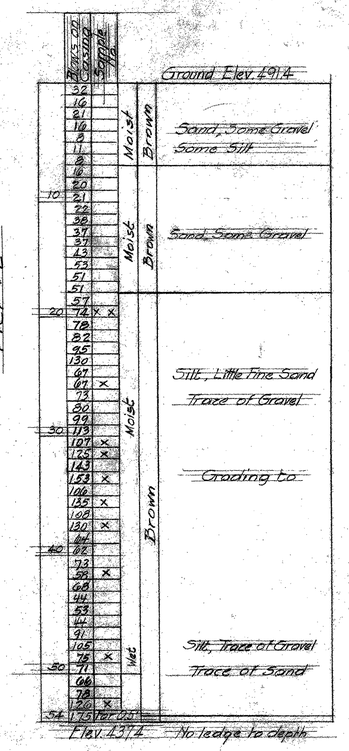

B-17

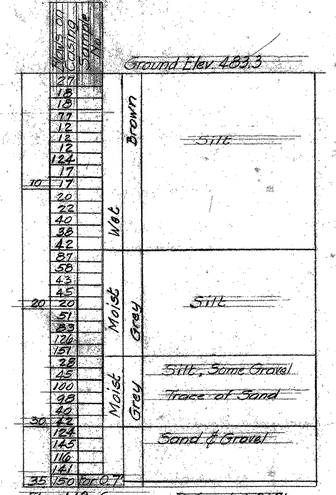

B-18

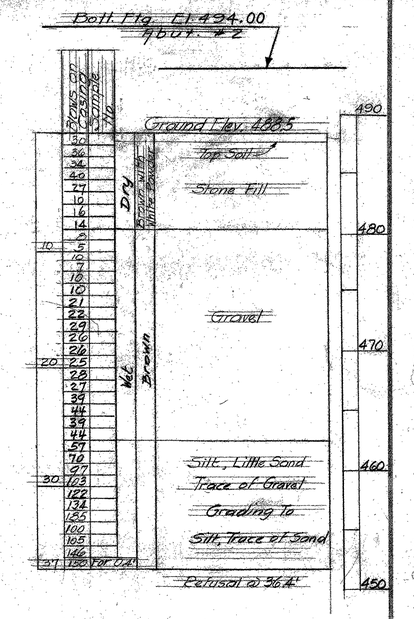

B-20

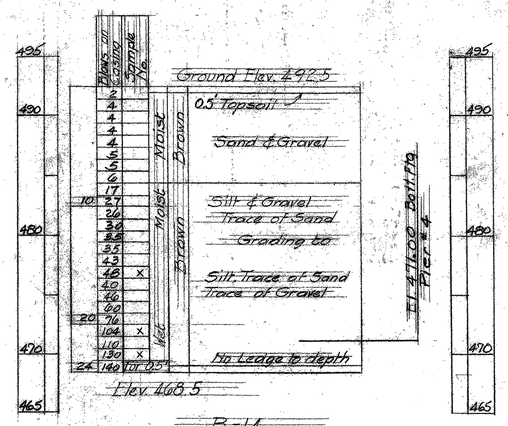

B-14

Note: X Indicated sample taken - No blow Counts

THIS SHEET FOR REFERANCE ONLY
HARTLAND IM 091-1(36)
I-91 BRIDGE 38

SHEET 50 OF 85

Stage I Construction

ITEM NO.	ITEM	UNIT	NET	OVERRUN	TOTAL	FINAL
106-A	CHAN. EXCAV. OF EARTH	C. Y.				
106-B	CHAN. EXCAV. OF ROCK	C. Y.				
106-C	UNCLASS. CHAN. EXCAV.	C. Y.				
107	STRUCT. EXCAV.	C. Y.				
401-B	CONC. CLASS B (MOD.)	C. Y.				
402	REINF. STEEL	LBS.				
407	ASPHALTIC-ASB. COATING	S. Y.				
502-B	TREATED TIMBER PILING	L. F.				
503	SPLICES FOR STEEL PILING	EA.				
504	STEEL PILING	L. F.				
502-A	UNTREATED TIMBER PILING	L. F.				

STATE OF VERMONT
DEPARTMENT OF HIGHWAYS

TOWN OF HARTLAND - HARTFORD
ROUTE No. U.S. 5 OVER INTERSTATE
CASING BORINGS

SCALE 1" = 6'
SURVEYED BY
DRAWN BY D.K.P. CHECKED BY G.Y.K.
G.V.K.
PROJECT No. I-91-1(22) CONT. #2
SHEET 47 OF 220

BR-105

K+E PRINTING IN USA
B. L. M. INC. 05112