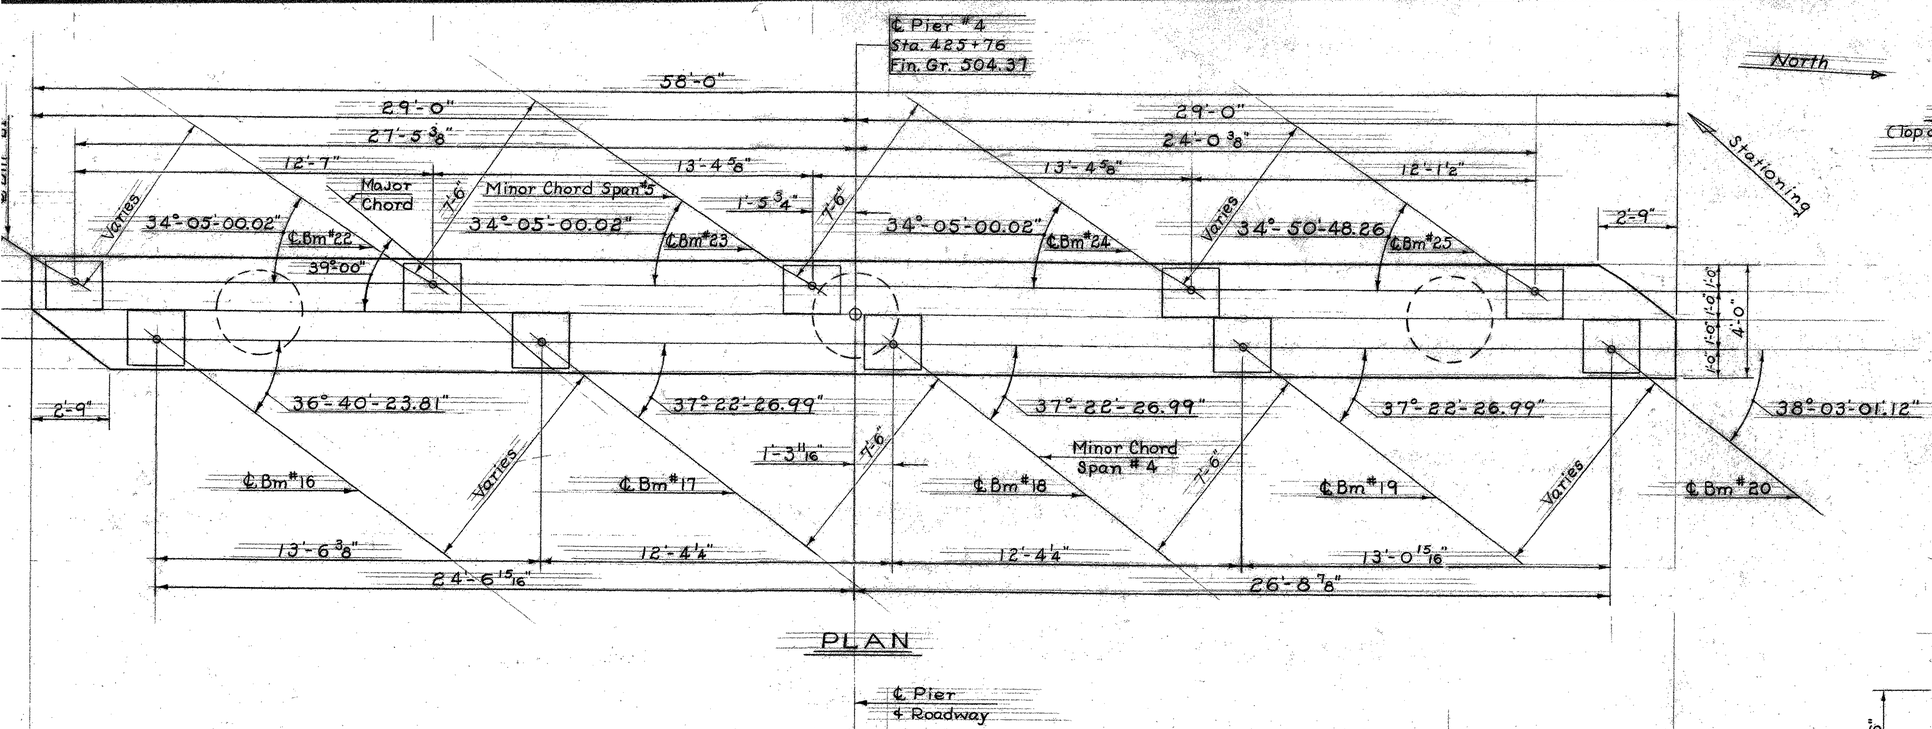

PLAN

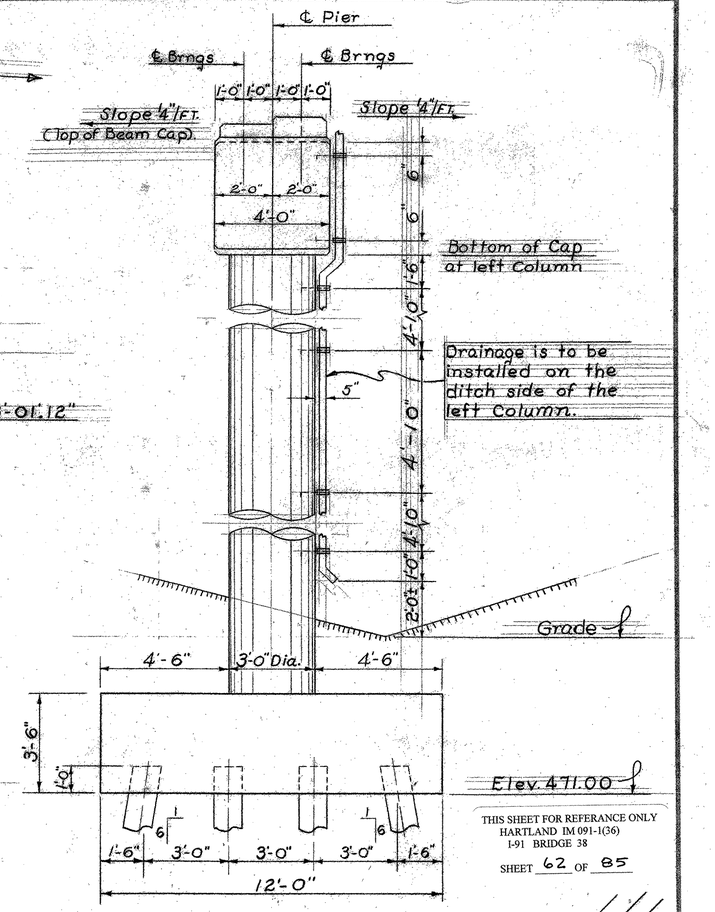

END ELEVATION

THIS SHEET FOR REFERANCE ONLY
HARTLAND IM 091-1(36)
I-91 BRIDGE 38
SHEET 62 OF 85

ELEVATION

Estimated Length of Piles 20'

For Notes see Pier No.1 Layout Details Sheet BR-111

For Estimated Quantities See Pier No.4 Reinforcing Steel, Sheet BR-118

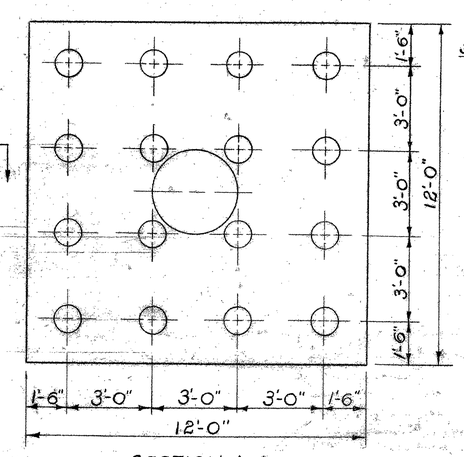

SECTION A-A

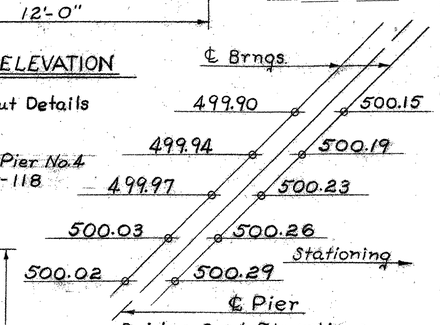

Bridge Seat Elevations
"No Scale

STATE OF VERMONT
DEPARTMENT OF HIGHWAYS

TOWN OF HARTLAND-HARTFORD
ROAD NO. I91 BRIDGE NO.
Pier No. 4 Layout Details
U.S. 5 Over I 91
SCALE 3/8" = 1'-0"
SURVEYED BY
DRAWN BY J.J.C. CHECKED BY AER
PROJECT NO. I 91-1(22) Cont. 2
SHEET 61 OF 220

Stage I Construction

BR-117