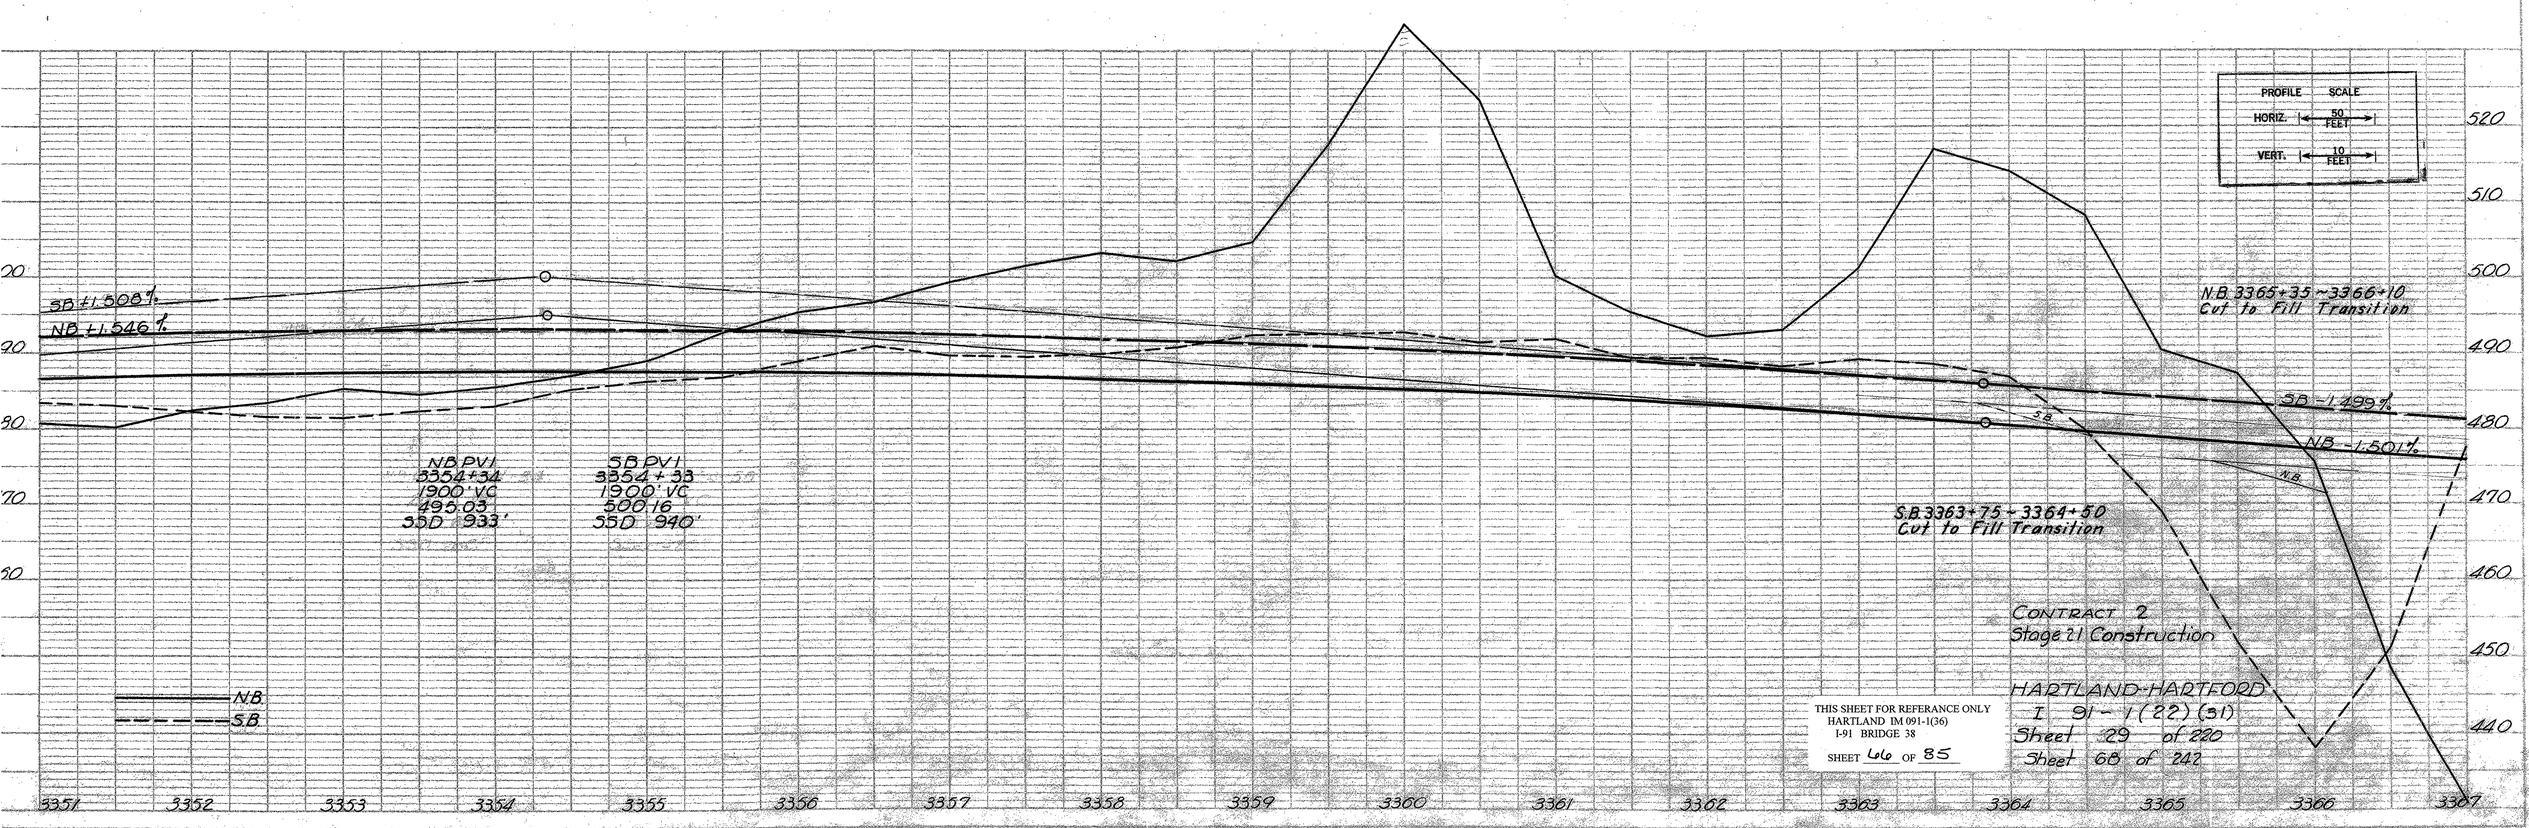

THIS SHEET FOR REFERANCE ONLY
HARTLAND IM 091-1(36)
I-91 BRIDGE 38

SHEET 66 OF 85

PLATE 3 PROFILE C.P.R. & R.S. STANDARD
MORRILL & SIBLEY CO., NEW YORK