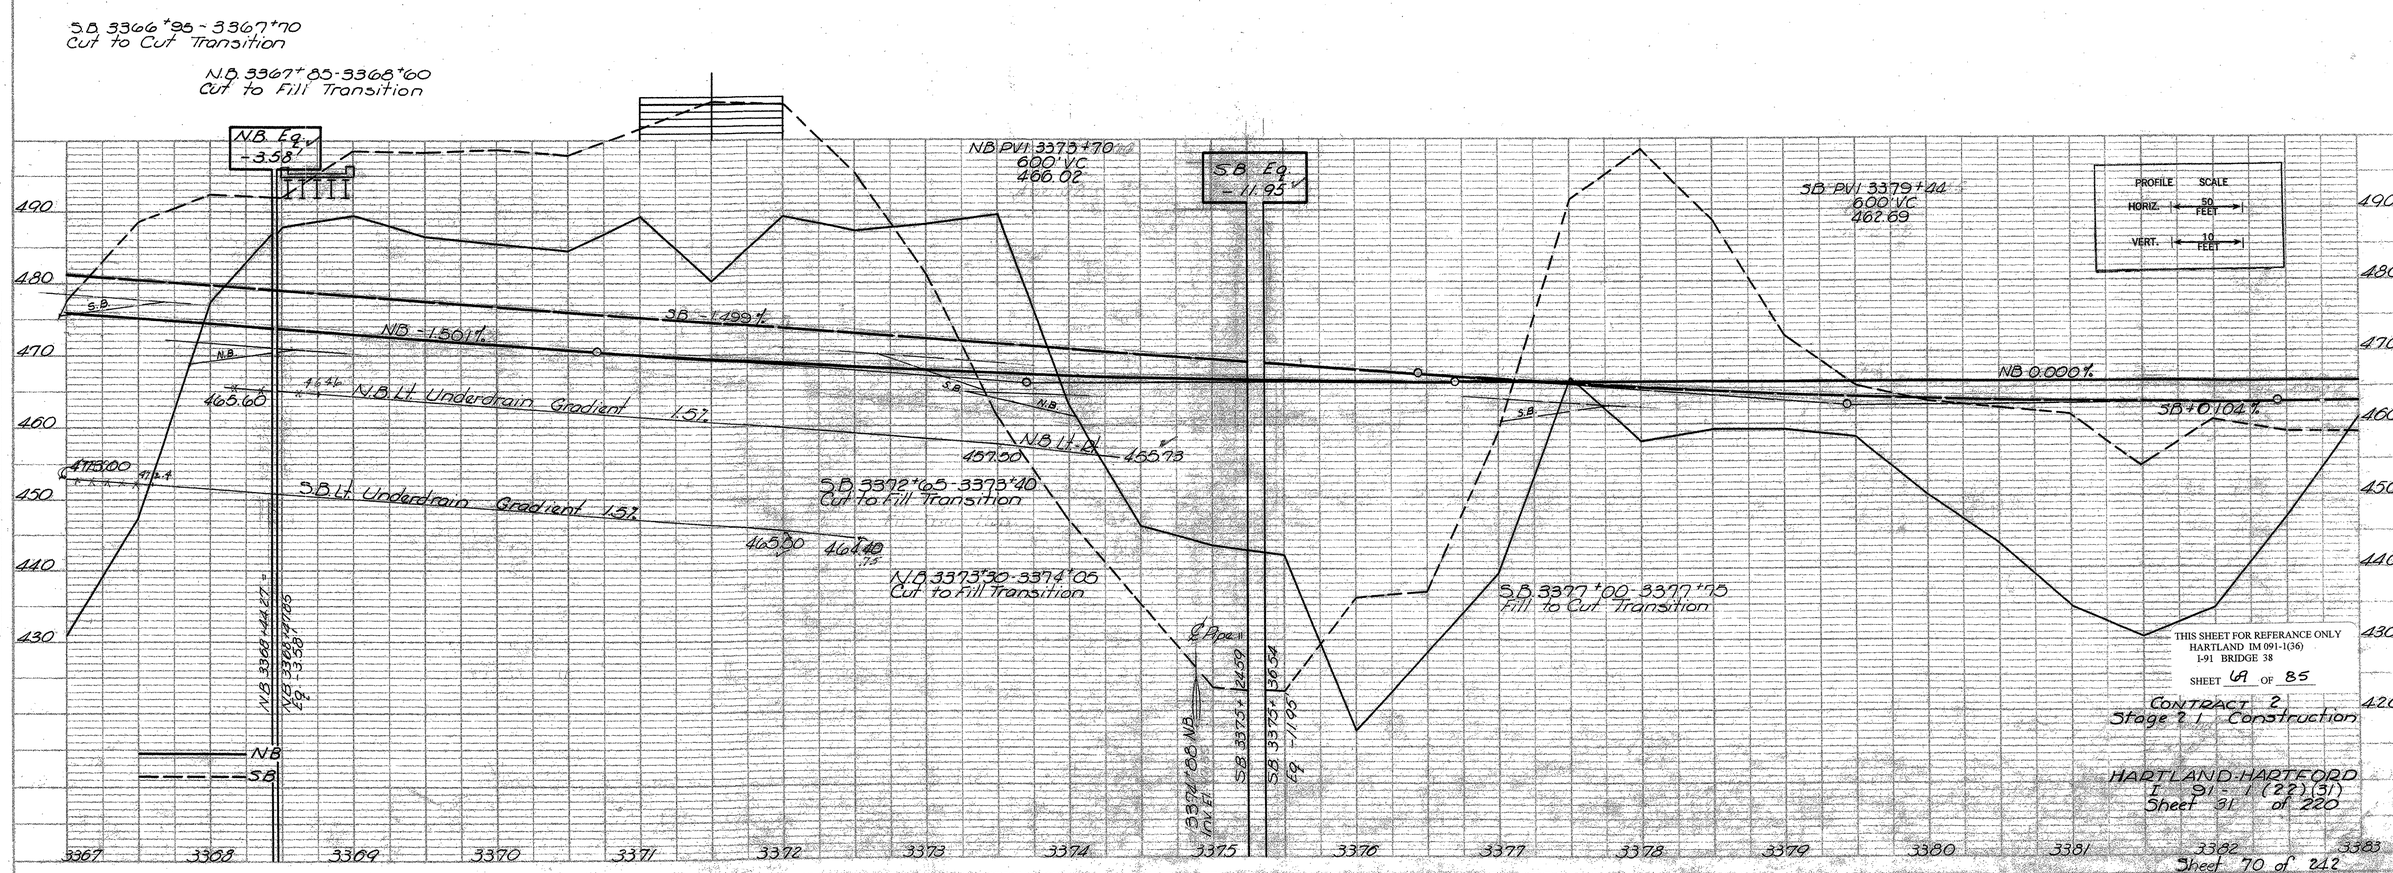


THIS SHEET FOR REFERANCE ONLY
HARTLAND IM 091-1(36)
I-91 BRIDGE 38

SHEET 6A OF 85

CONTRACT 2
Stage 2 1 Construction

HARTLAND-HARTFORD
I 91 - 1 (22)(31)
Sheet 31 of 220

Sheet 70 of 242

PLAN
SURVEYED
PLOTTED
ALIGNMENT CHECKED
RT. OF WAY CHECKED
NOTE BOOK
NO.
BY
DATE

PROFILE
SURVEYED
PLOTTED
GRADES CHECKED
B.M. ADJUSTED
STRUCTURE NOTATIONS CHKD.
NOTE BOOK
NO.
BY
DATE

PLATE 1 - PROFILE 4 X 5 - 4 X 5 - 5 X 5 HORIZ.
KEUFFEL & ESSER CO. NEW YORK