ABM INFO		SHOP BILL						JOB NO. 198	DRG. NO. M12
PAGE	LINE	NO.	DESCRIPTION	FT	IN	ASSEM. MARK	SHIPPING MARK	REMARKS	WEIGHT
		1	PL 4x10 3/8	2	0 3/8		PB1		
		1	DO	2	3 1/2		PB2	BEND	
		1	DO	2	3 1/2		PB3		
		1	PL 4x10	2	3 1/2		PB4		
		1	DO	2	3 7/16		PB5		
		1	PL 4x11 3/8	2	4 3/8		PB46		
		1	PL 4x10	2	4 3/8		PB47		
		1	PL 4x10 3/8	2	4 3/8		PB48		
		1	PL 4x9 3/4	2	4 3/8		PB49	BEND.	
		1	PL 4x9 3/8	1	10 3/16		PB50		
			PAY ITEM 506.60						

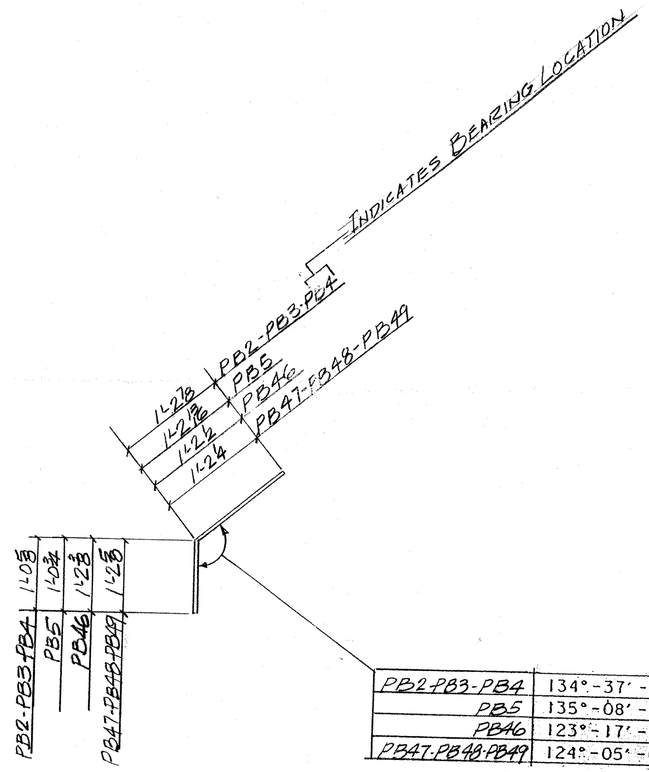

PB2-PB3-PB4	134°-37'-04.45"
PB5	135°-08'-37.22"
PB46	123°-17'-23.52"
PB47-PB48-PB49	124°-05'-00.02"

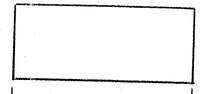

PB1	PL 4 x 10 3/8 x 2'-0 3/8
PB50	PL 4 x 9 3/8 x 1'-10 3/16

VENDOR SUBMITTAL REVIEW

REVIEW STATUS		CONTRACTOR ACTION	
APPROVED	✓	NONE	
APPROVED AS REVISED		CONFIRM	
REJECTED		RESUBMIT	✓

REVIEW IS FOR GENERAL CONFORMANCE WITH THE DESIGN CONCEPT AND CONTRACT DOCUMENTS. NOTATIONS OR COMMENTS SHALL NOT BE CONSTRUED AS RELIEVING THE CONTRACTOR FROM COMPLIANCE WITH THE PROJECT PLANS AND SPECIFICATIONS NOR REPARTING THE RESPONSIBILITY THE CONTRACTOR REMAINS RESPONSIBLE FOR DETAILS AND QUANTITIES AND FOR SAFE, SATISFACTORY AND EFFICIENT FABRICATION PROCESSES FOR TERMINATING THE WORK IN A SAFE MANNER.

BY: [illegible] DATE: 12 Aug 03

OUT FOR APPROVAL	10-21-03										
OUT FOR APPROVAL	11-28-03										
ISSUED TO SHOP											
FIELD & OFFICE											
REV.	REMARKS	DATE	DWN	CHK	APP	Q.A.	NO.	DIA.	LGT	TYPE	WASHER

PROJECT NO. IM-091-1 (36) STATE BRIDGE NO. 38

MATERIAL: AASHTO M270 Gr36 ELECTRODES: — HOLES: — SHOP BOLTS: —

SURFACE PREP. & PAINT:

GALV. AFTER FAB (ASTM-A123)
Rec'd 8-14-03

DESCRIPTION: BEAM END PL'S - ABUTS. 1 & 2

JOB: US ROUTE 5 OVER I-91 HARTLAND, VT.

CUSTOMER: F.W. WHITCOMB

DRAWN BY	JPF
DATE	6-03
CHKD BY	EJ
APPROV BY	
Q.A.	

CASCO BAY STEEL STRUCTURES, INC.
75 SPRING HILL ROAD SACO, MAINE 04072
PHONE (207) 282-7360 FAX. (207) 282-1179

JOB NO.	DRG. NO.
198	M12
096	REV. △