FINAL SURVEY
SURVEYED
PLOTTED
NOTE BOOK TEMPLATE
NO. AREAS
AREAS CHECKED
BY DATE

ORIGINAL SURVEY
SURVEYED BY
PLOTTED
NOTE BOOK AREAS
NO. AREAS CHECKED
BY DATE

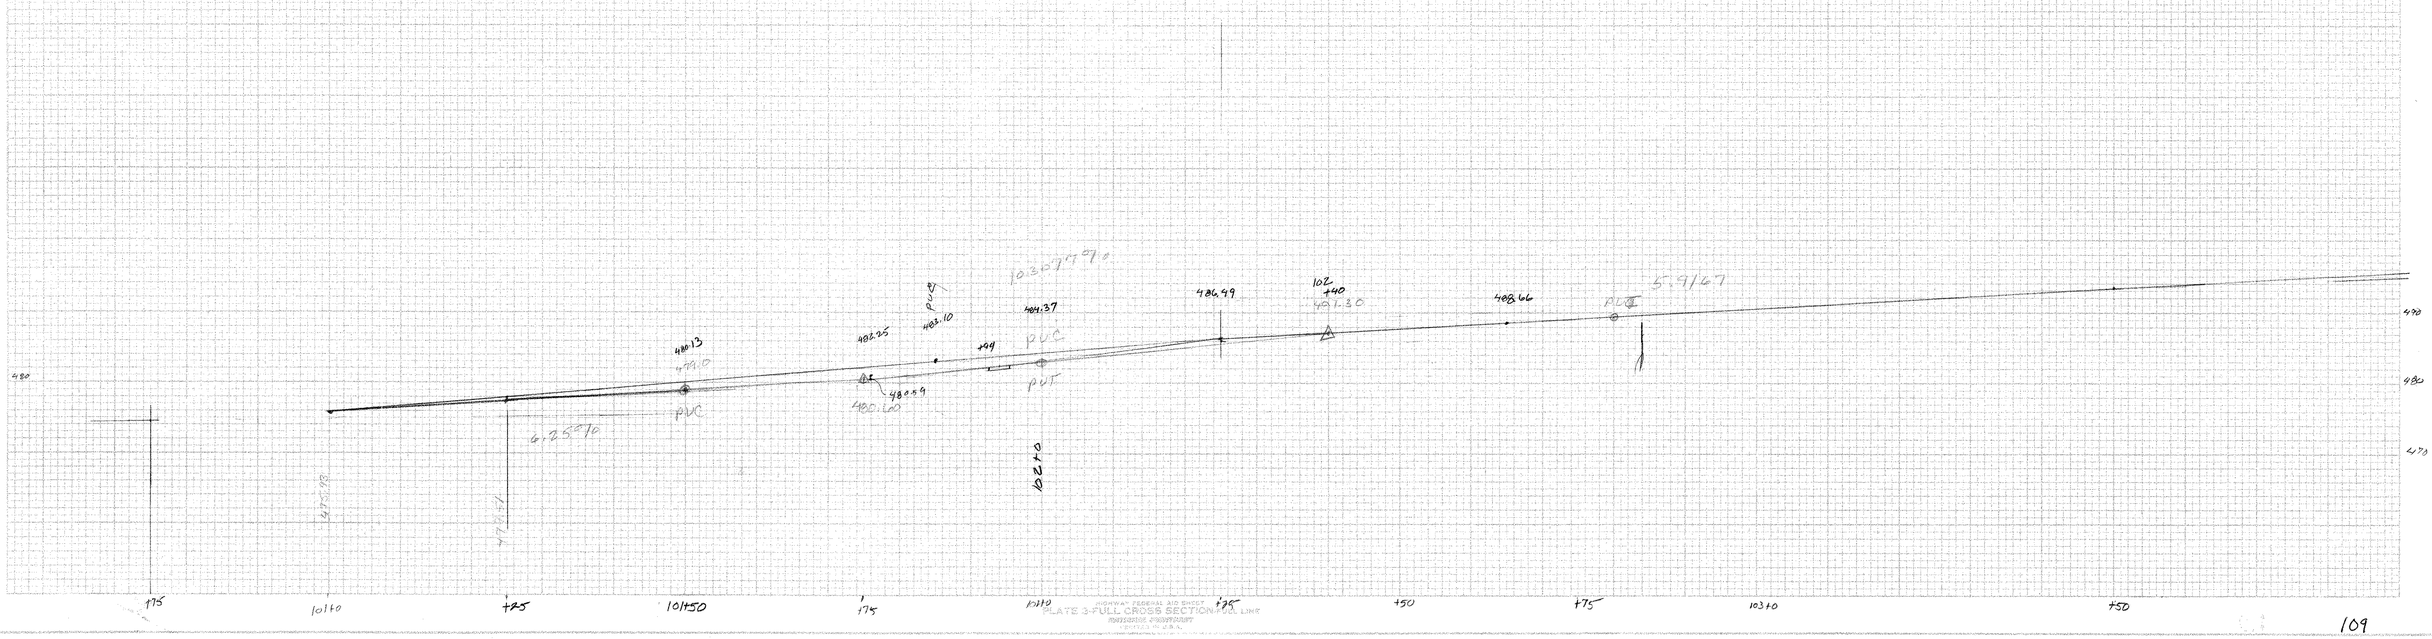

HIGHWAY FEDERAL AID PROJECT
PLATE 3-FULL CROSS SECTIONS ON L. LINE
DATE 1-1-64