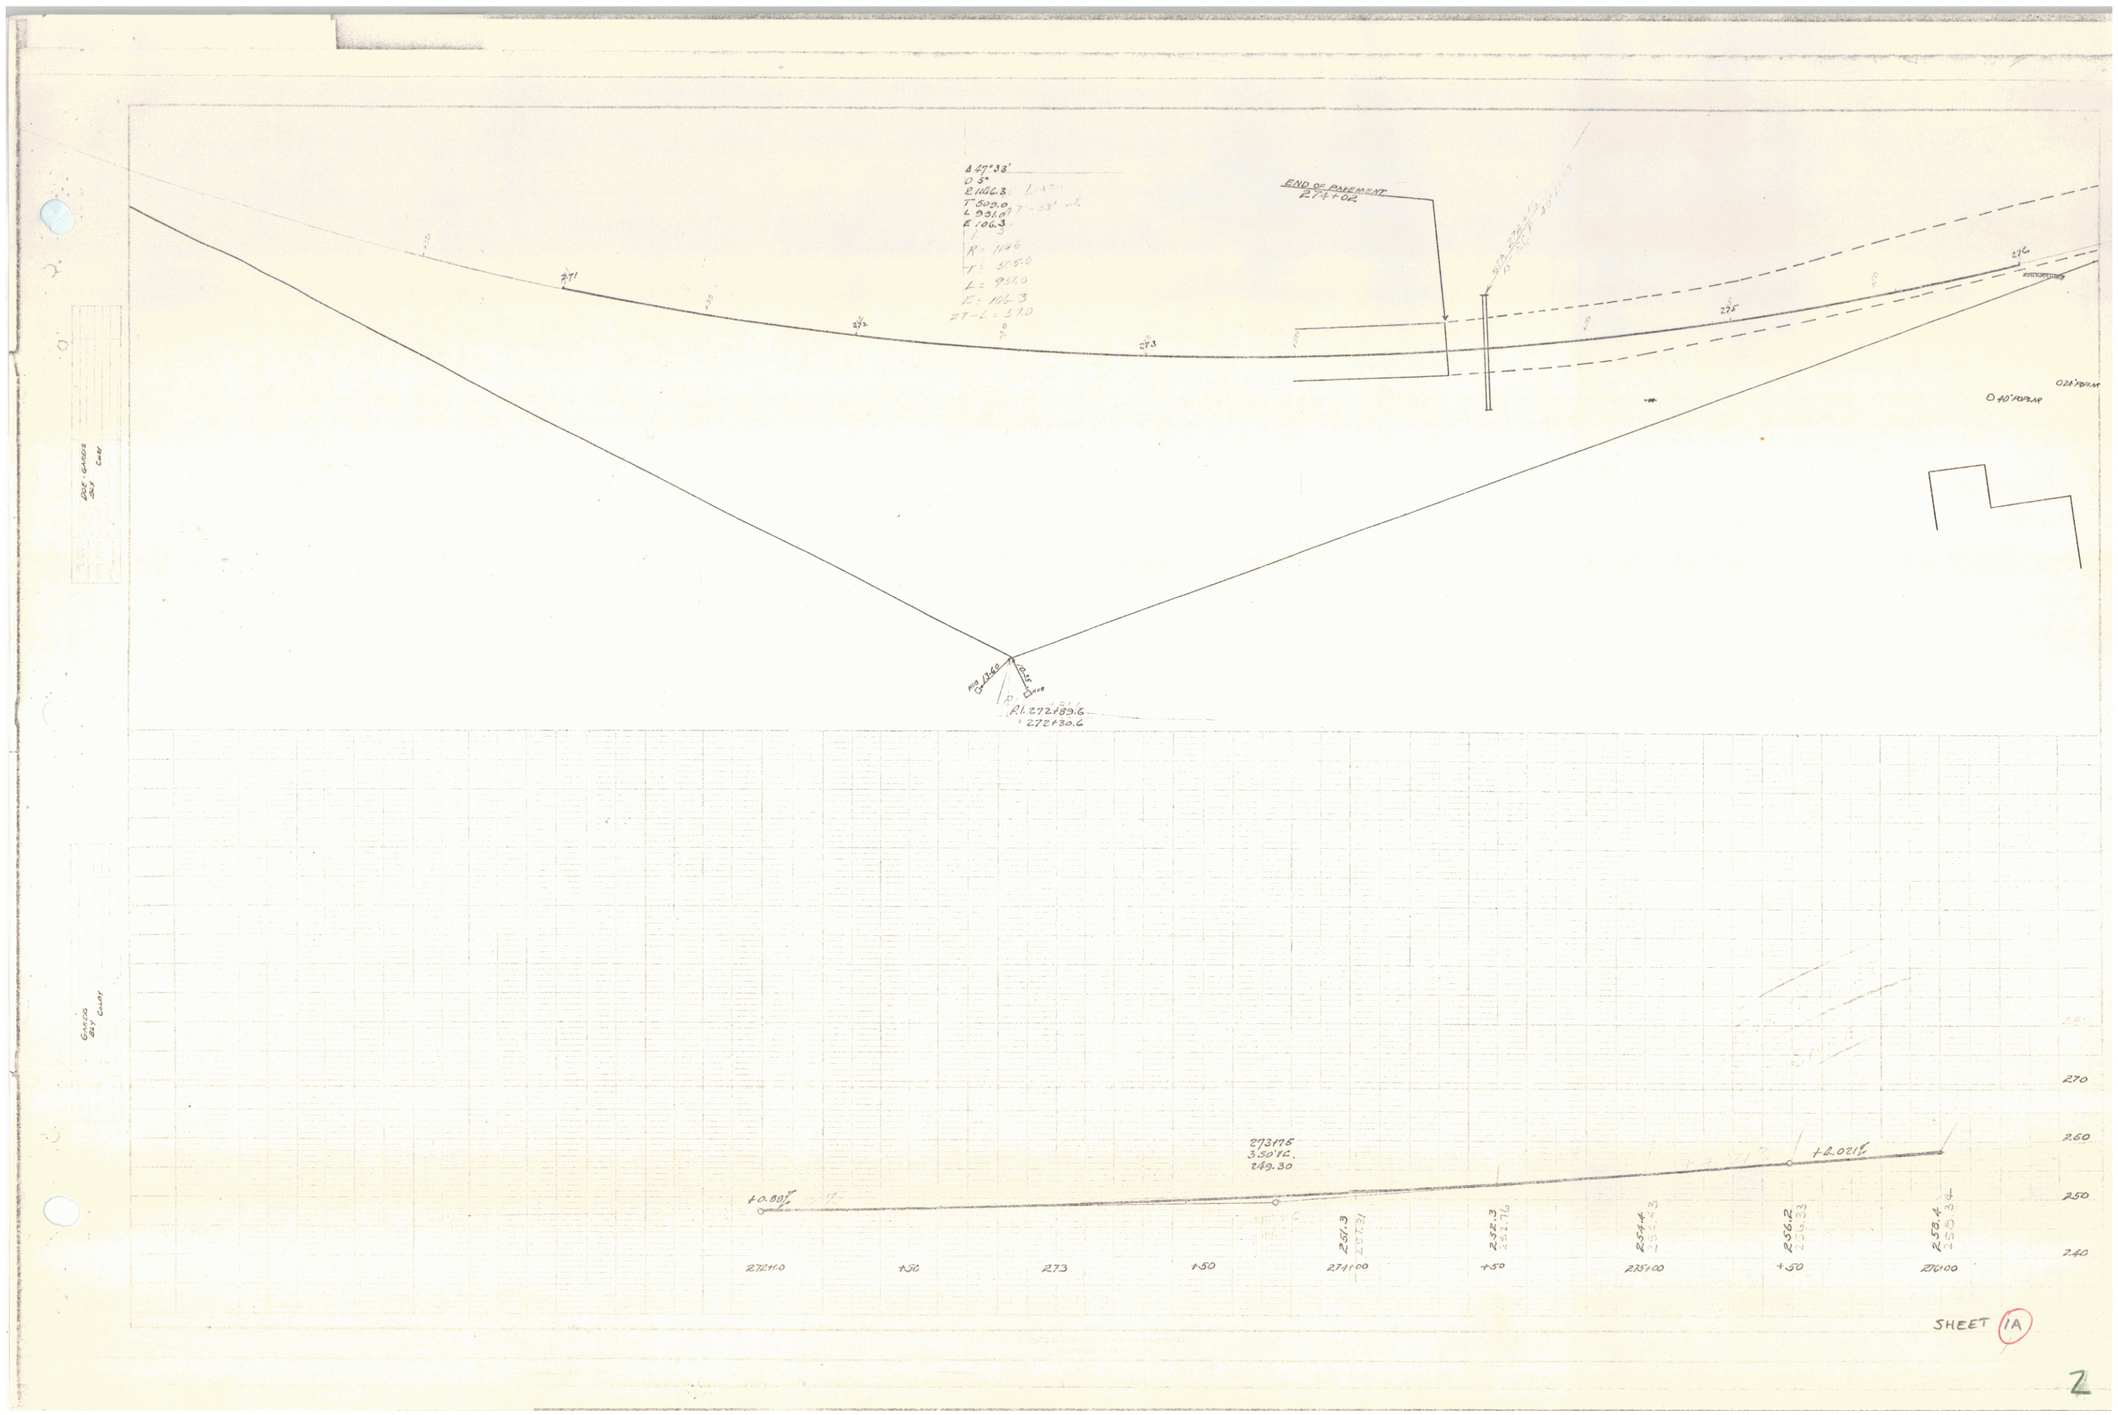
Δ 47°38'
D 5°
R 1146.3
T 505.0
L 951.0
E 106.3
R = 1146
T = 505.0
L = 951.0
E = 106.3
27T - L = 57.0
END OF PAVEMENT
271
272
273
275
276
D 40' REVERSE
PI 272+89.6
272+30.6
273+75
3.50% VC.
249.30
+0.80%
+2.02%
251.3
252.3
254.4
256.2
258.4
272+00
+50
273
+50
274+00
+50
275+00
+50
276+00
270
260
250
240
SHEET 1A
2