POOR ORIGINAL COPY

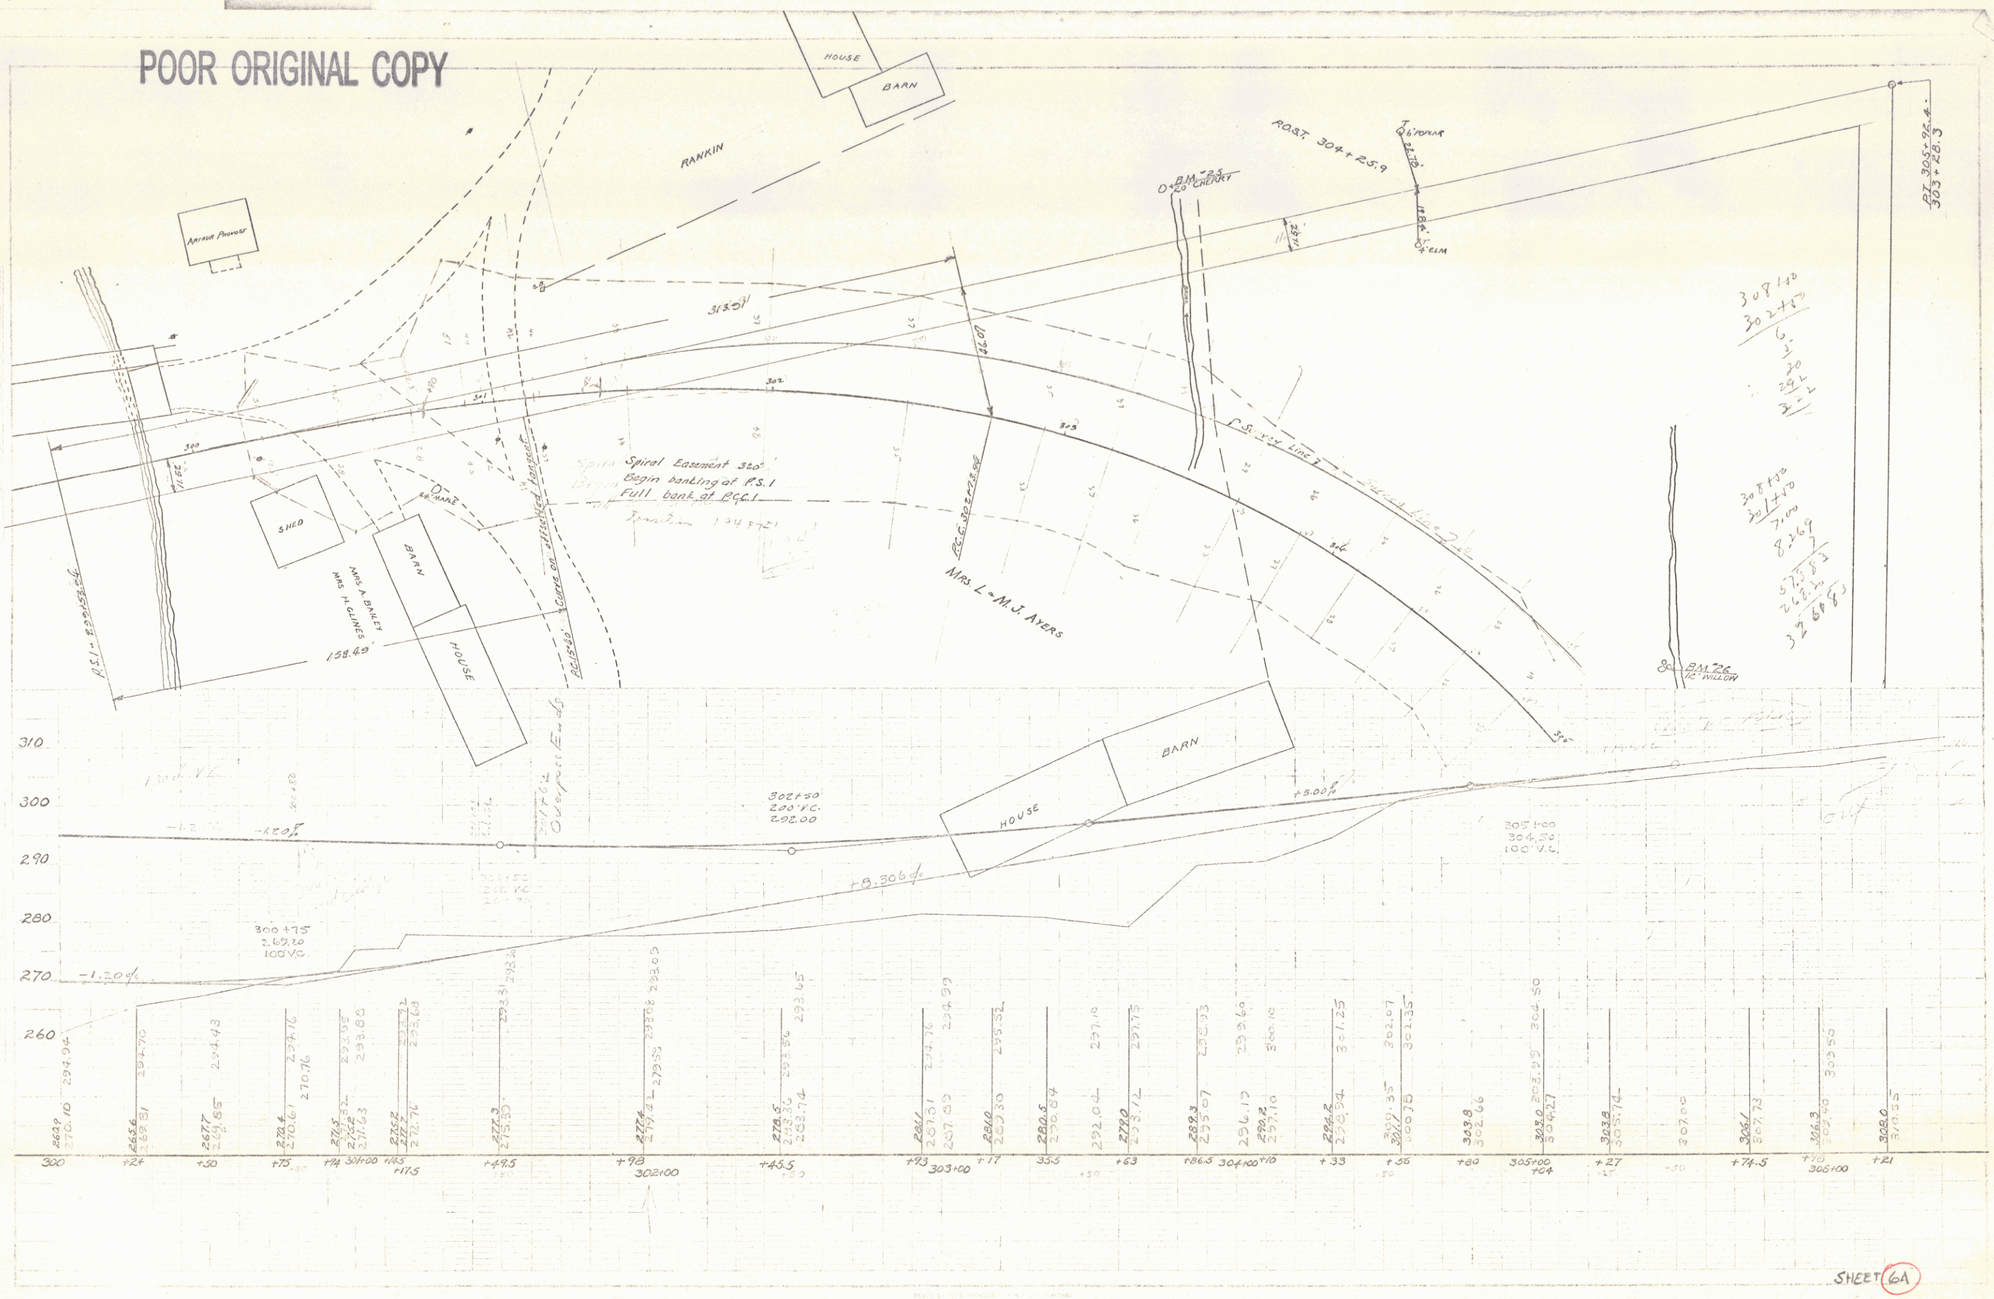

SHEET 6A

12