POOR ORIGINAL COPY

F.D. ROAD DIST. NO.	STATE	F.D. AID PROJ. NO.	FISCAL YEAR	SHEET NO.	TOTAL SHEETS
2		101-H	1934	9	50

(1933)

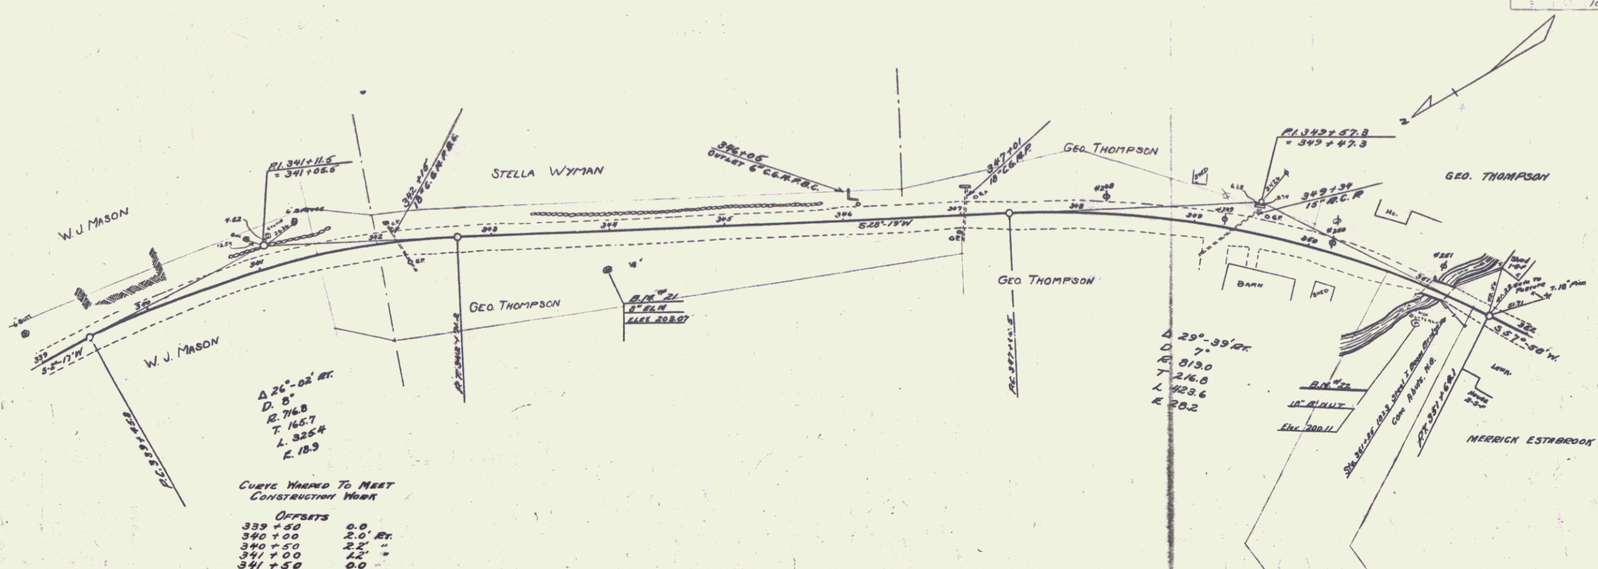

SERIES No. 101-H (1933)
SHEET 9 OF 50

8