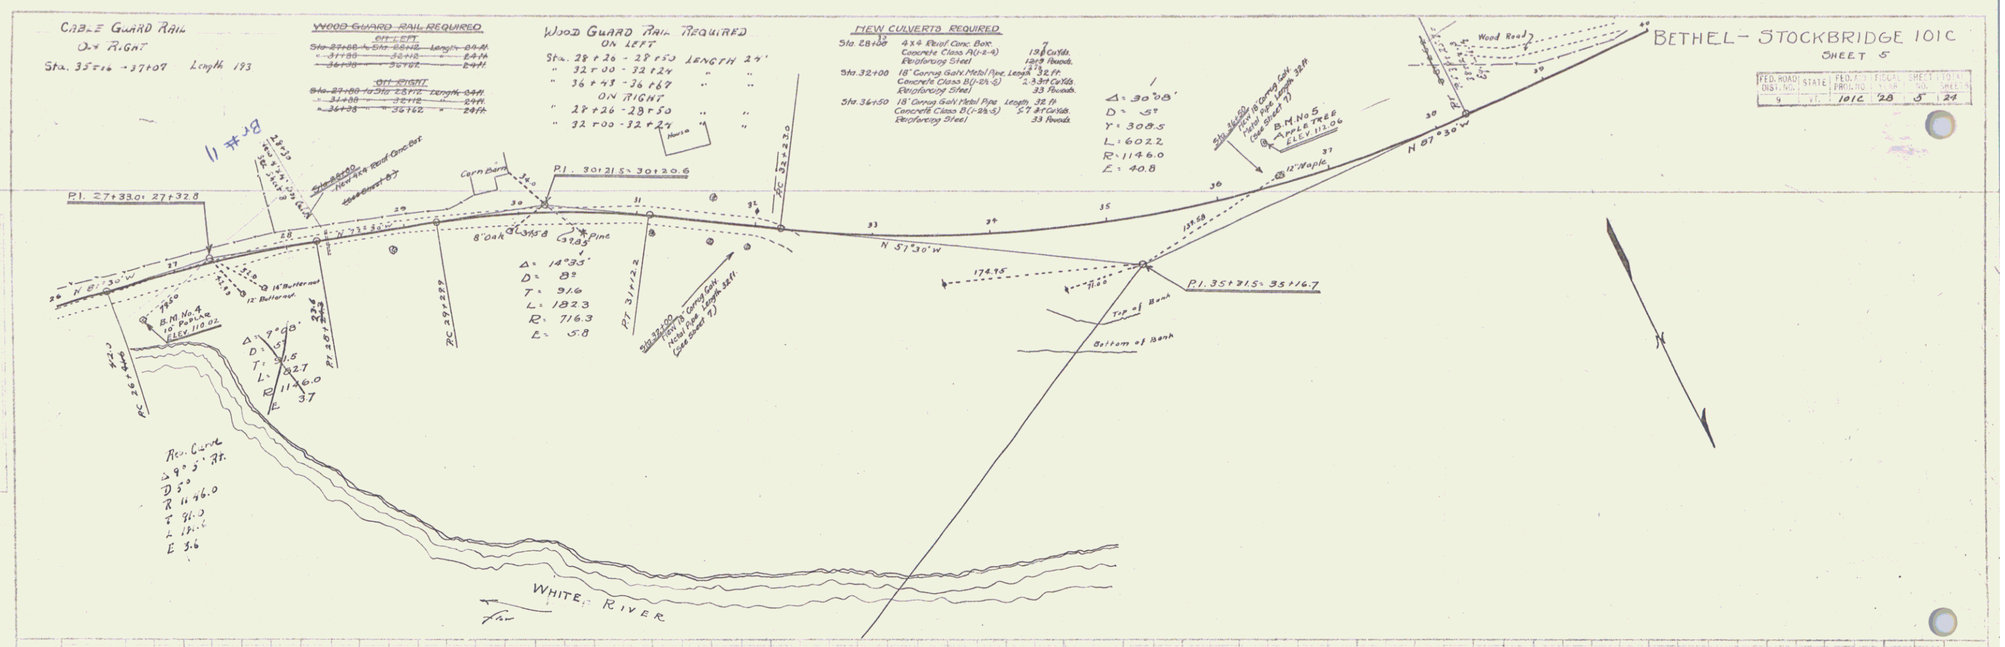

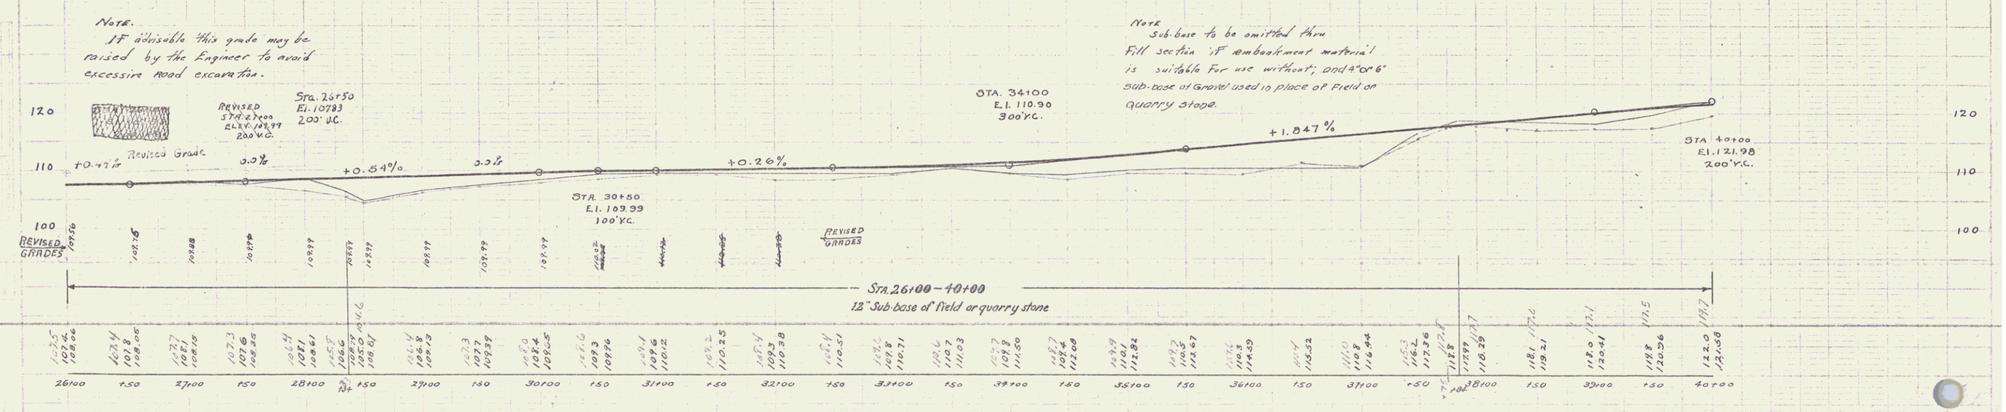

B.M. No. 4 Spike in Poplar, Right of Sta. 26+60 Elev. 110.02
B.M. No. 5 Spike in Apple Tree, Left of Sta. 36+50 Elev. 112.06

Series F 101 C
Sheet 5 of 24