BETHEL — STOCKBRIDGE 101 C

SHEET 6

FED. RD. AID DIST. NO.	STATE	FED. AID PROJ. NO.	FISCAL YEAR	SHEET NO.	TOTAL SHEETS
9	VT.	101C	28	6	

WOOD GUARD RAIL REQUIRED

ON LEFT

~~Sta. 41+03 to Sta. 41+87 Length 24 ft.~~
~~52+38 — 52+62 — 24 ft.~~

ON RIGHT

~~Sta. 41+03 to Sta. 41+87 Length 24 ft.~~
~~52+38 — 52+62 — 24 ft.~~

ON LEFT

Sta. 41+63 - 41+92	Length	29'
" 45+11 - 45+55	"	29'
" 47+85 - 48+38	"	29'
" 51+95 - 52+19	"	29'
" 53+79 - 54+18	"	29'

ON RIGHT

Sta. 41+08 - 41+92	"	29'
" 44+90 - 45+19	"	29'
" 47+90 - 48+89	"	29'
" 51+85 - 52+18	"	29'

CABLE GUARD RAIL REQUIRED

ON RIGHT

~~Sta. 53+64 to Sta. 55+00 Length 136 ft.~~
Sta. 53+64 → 55+17 " 131'

NEW CULVERTS REQUIRED

Sta. 41+75	18" Corrug. Galv. Metal Pipe	Length	34 ft.
	Concrete Class B (1-2½-3)		2.7 Bags
	Reinforcing Steel		33 Pounds
Sta. ~~52+60~~ 52+10	20" Corrug. Galv. Metal Pipe	Length	32 ft.
	Concrete Class B (1-2½-3)		2.4 Bags
	Reinforcing Steel		33 Pounds
Sta. 45+00	18" CGMP	Length	32'
	Conc. Class B (1-2½-3)		3.2 C.Y.
	Reinforcing Steel		33 lbs.
Sta. 48+00	18" CGMP	Length	36'
	Conc. Class B (1-2½-3)		2.3 C.Y.
	Reinforcing Steel		33 lbs.
Sta. 54+10	18" CGMP	Length	32'
	Conc. Class B (1-2½-3)		6.2 C.Y.
	Reinforcing Steel		58 lbs.

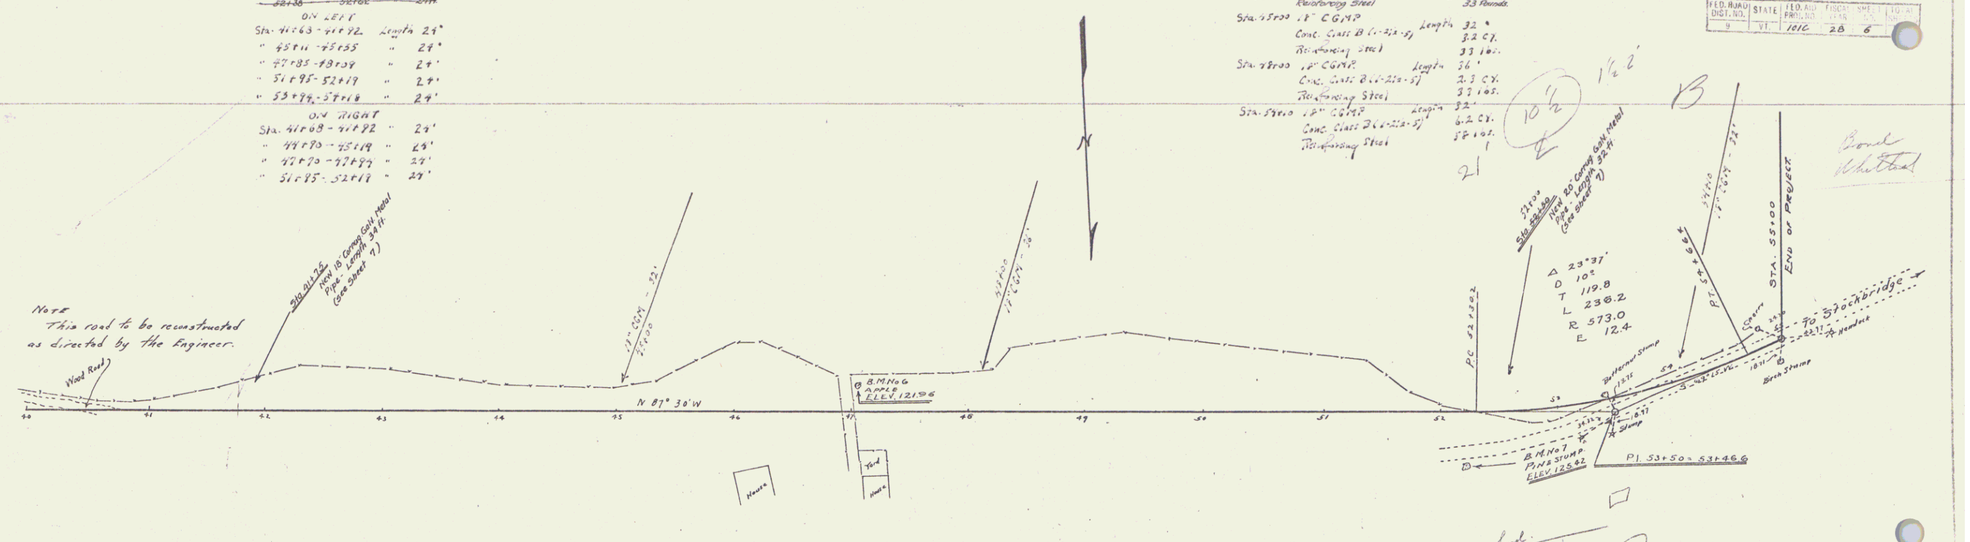

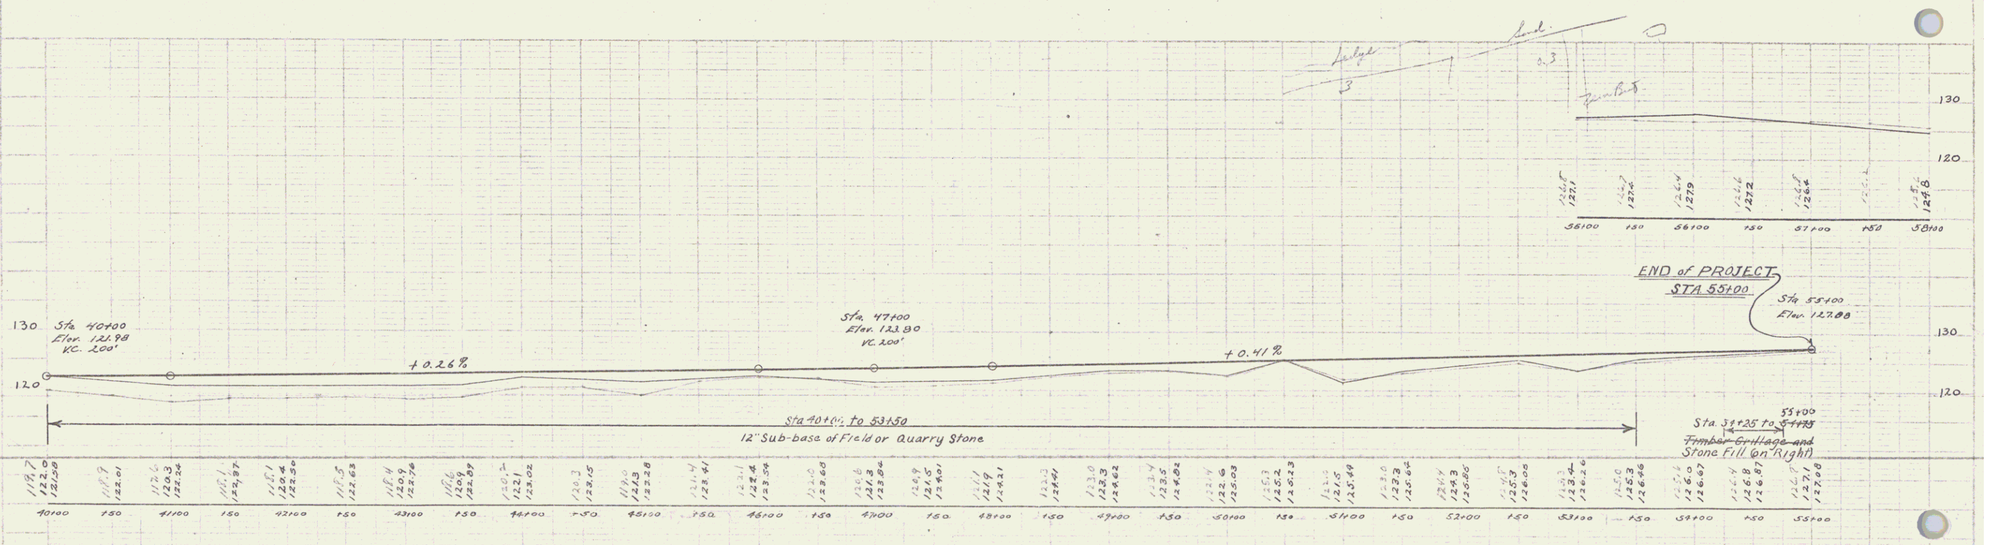

B.M. No. 6 Spike in Apple Tree, Left of Sta. 47+05, Elev. 121.96
B.M. No. 7 Spike in Top of Pine Stump, Right of Sta. 52+20, Elev. 125.42

Series F No. 101.C
Sheet 6 of 24

5