POOR ORIGINAL COPY

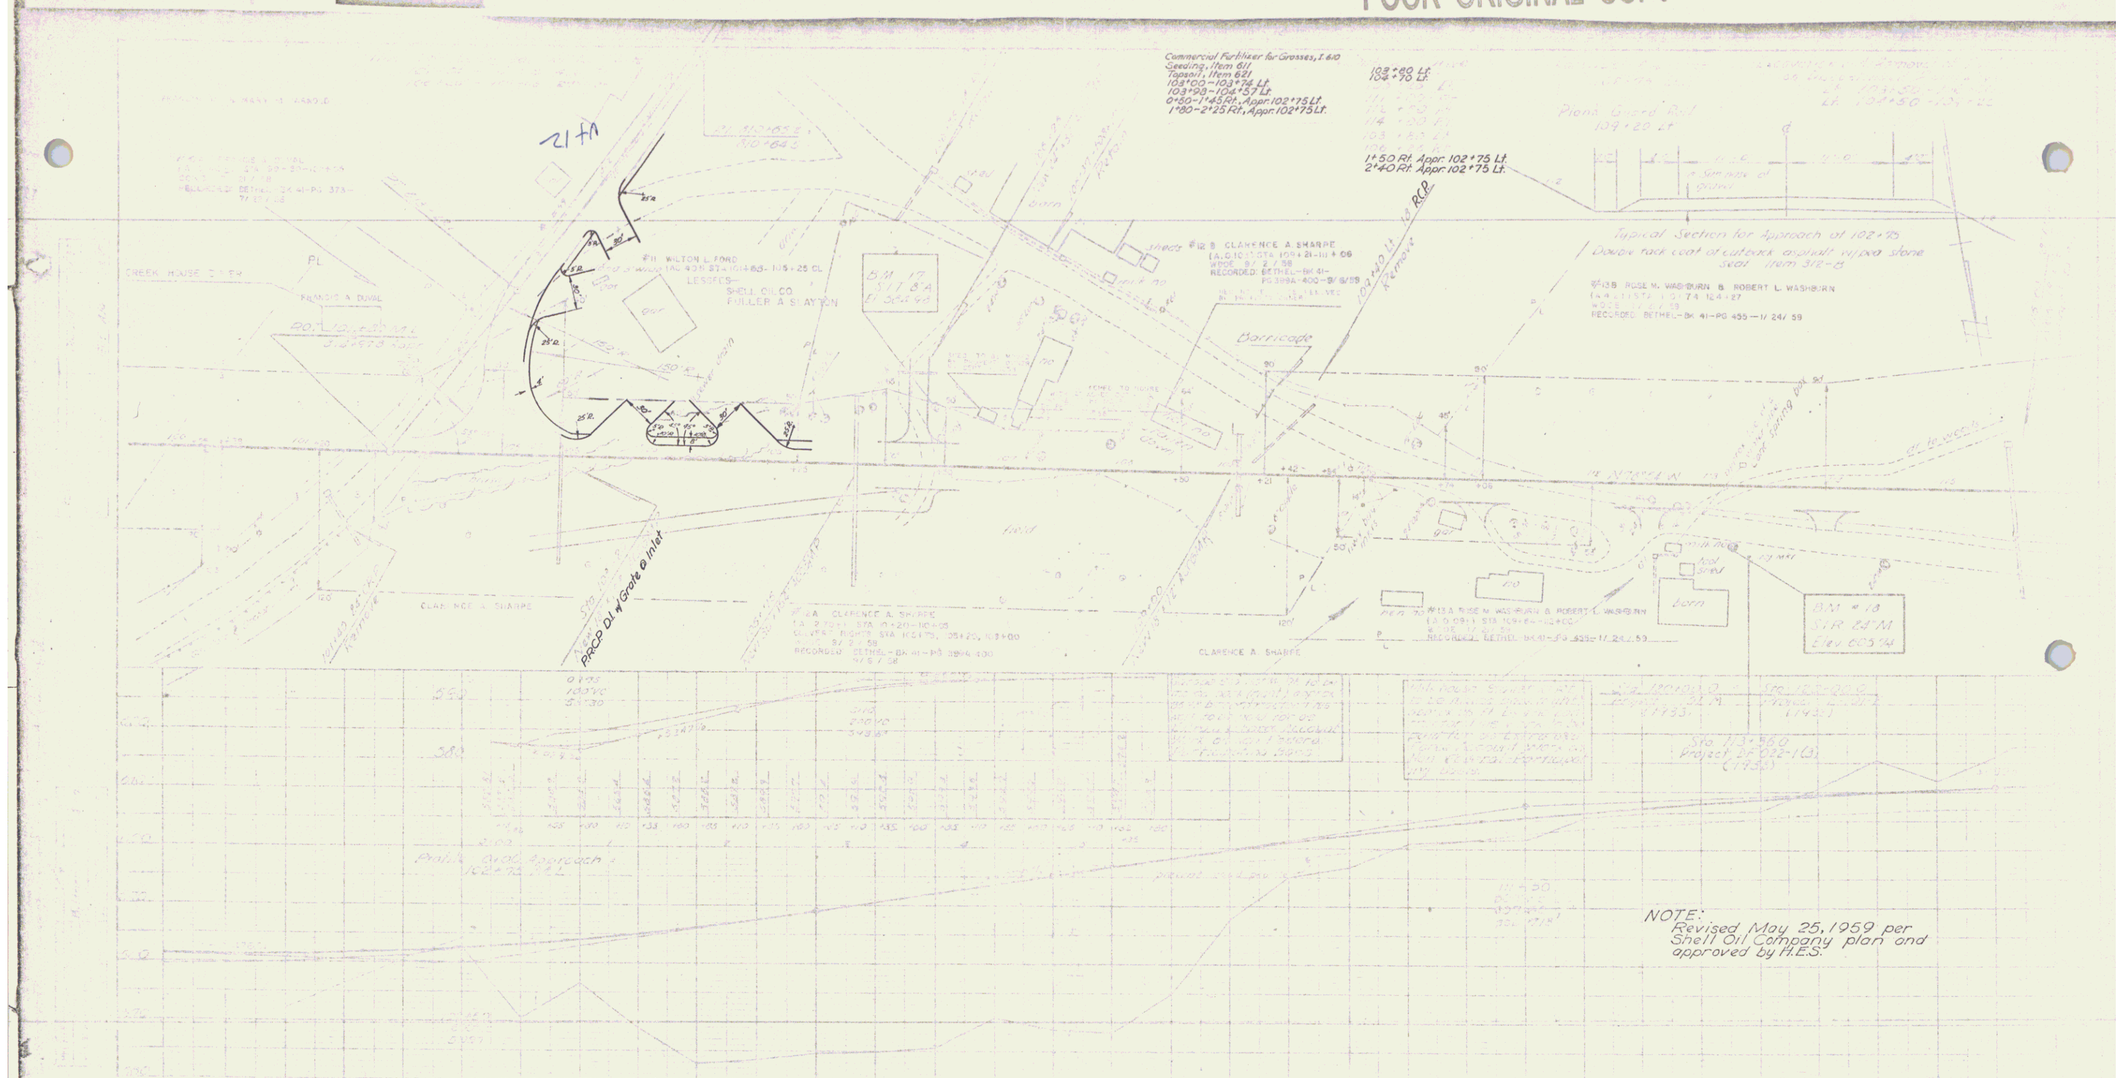

SHEET 11A

6