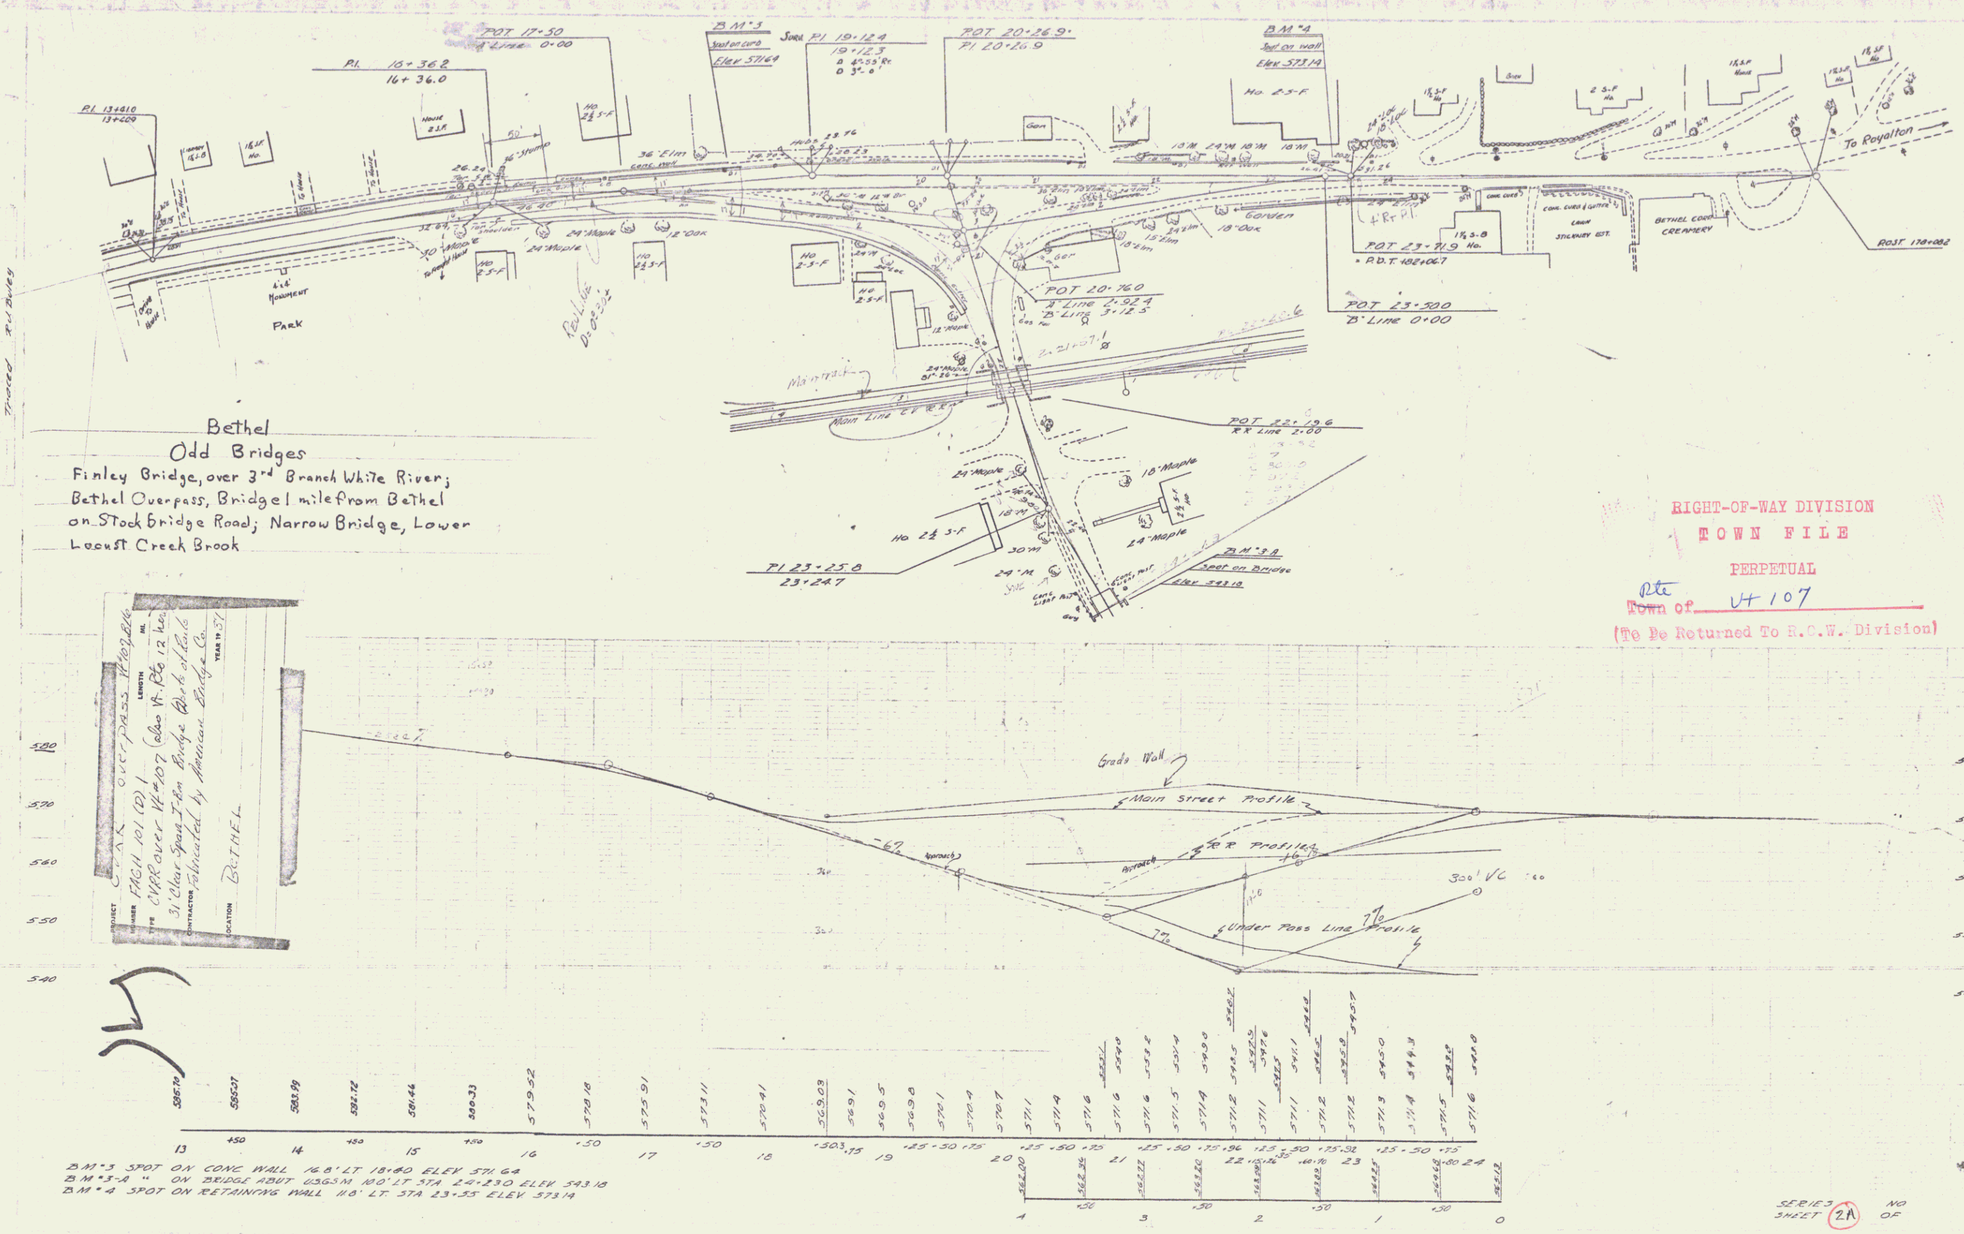

Bethel
Odd Bridges
Finley Bridge, over 3rd Branch White River;
Bethel Overpass, Bridge 1 mile from Bethel
on Stockbridge Road; Narrow Bridge, Lower
Locust Creek Brook

RIGHT-OF-WAY DIVISION
TOWN FILE
PERPETUAL
Rte
Town of VT 107
(To Be Returned To R.O.W. Division)

SERIES
SHEET 2A NO OF

Bethel Underpass 3