


No. 10
 8-54
 Jones
 8-54
 PLAN
 DATE BOOK PLANNING CHECKED
 DATE BOOK PLANNING CHECKED
 DATE BOOK PLANNING CHECKED

11/24
 6-54
 Jones
 6-54
 PROFILE
 DATE BOOK PLANNING CHECKED
 DATE BOOK PLANNING CHECKED
 DATE BOOK PLANNING CHECKED

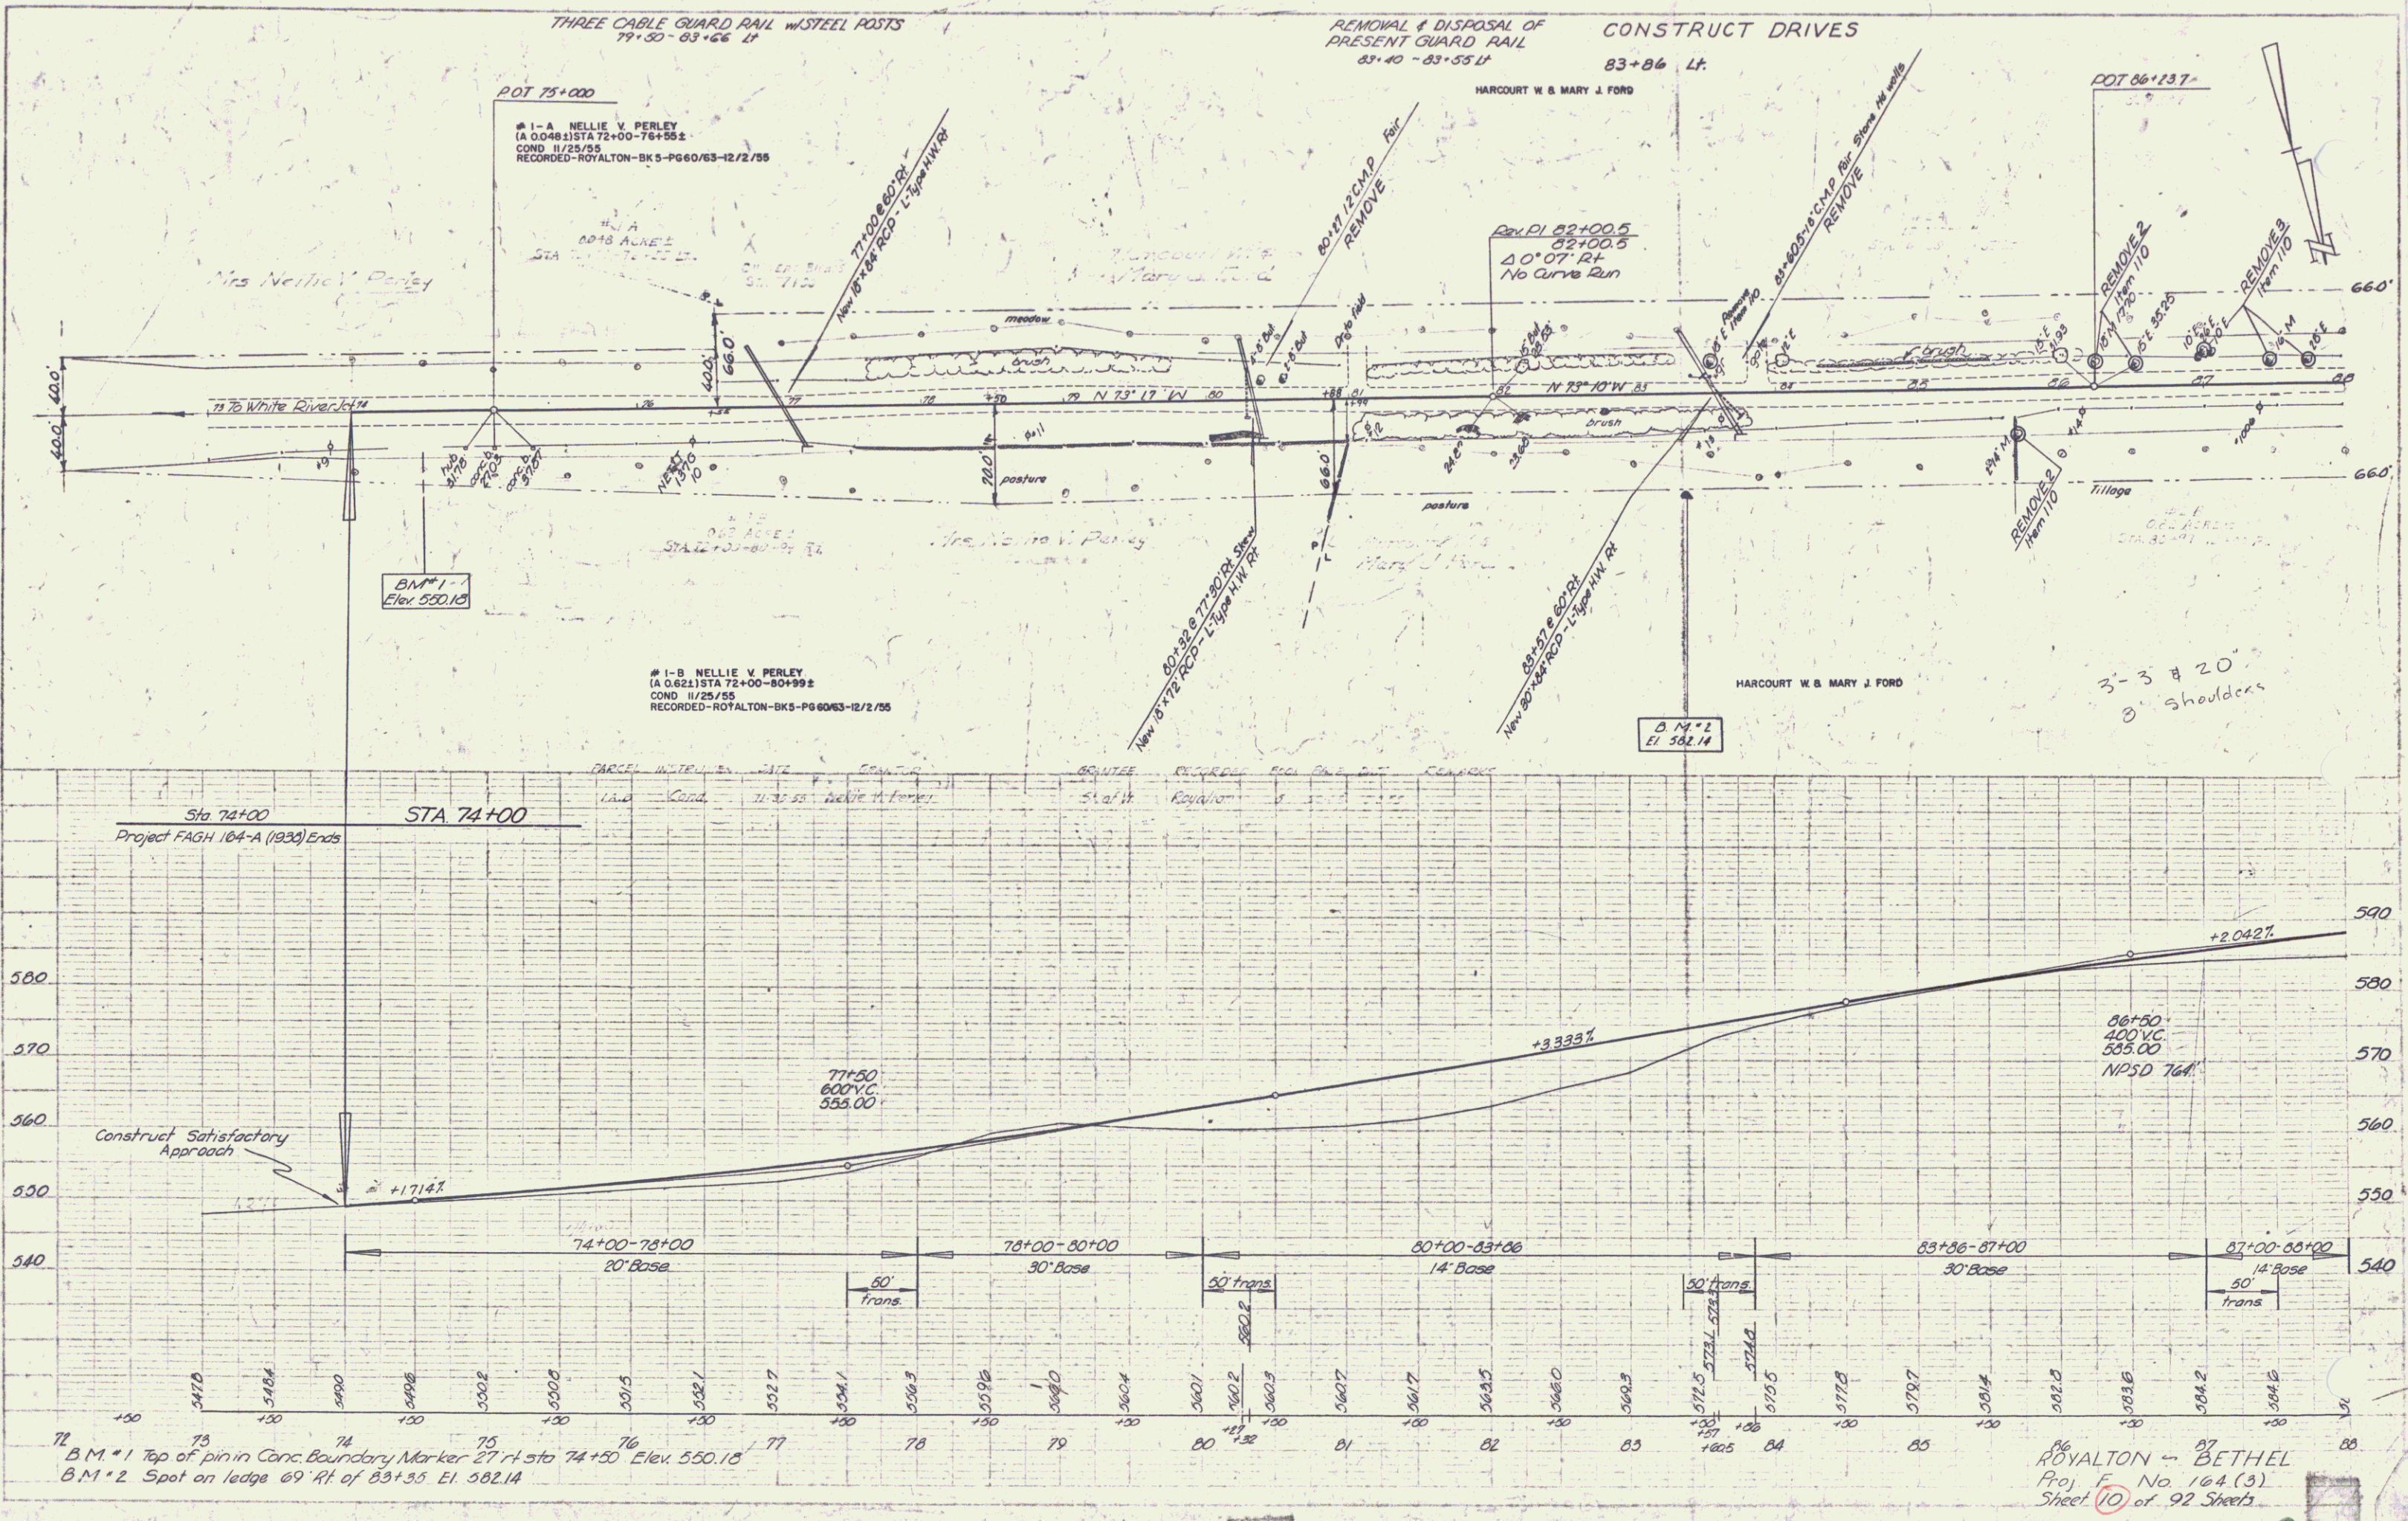

B.M. #1 Top of pin in Conc. Boundary Marker 27 ft Sta 74+50 Elev. 550.15
 B.M. #2 Spot on ledge @ 9' Rt of 83+35 El. 582.14

86 ROYALTON - 87 BETHEL
 Proj. No. 164 (3)
 Sheet 10 of 92 Sheets