FED. ROAD DIST. NO.	STATE	FAGM PROJ. NO.	FISCAL YEAR	SHEET NO.	TOTAL SHEETS
3	VT.	164 A	1938	B	46

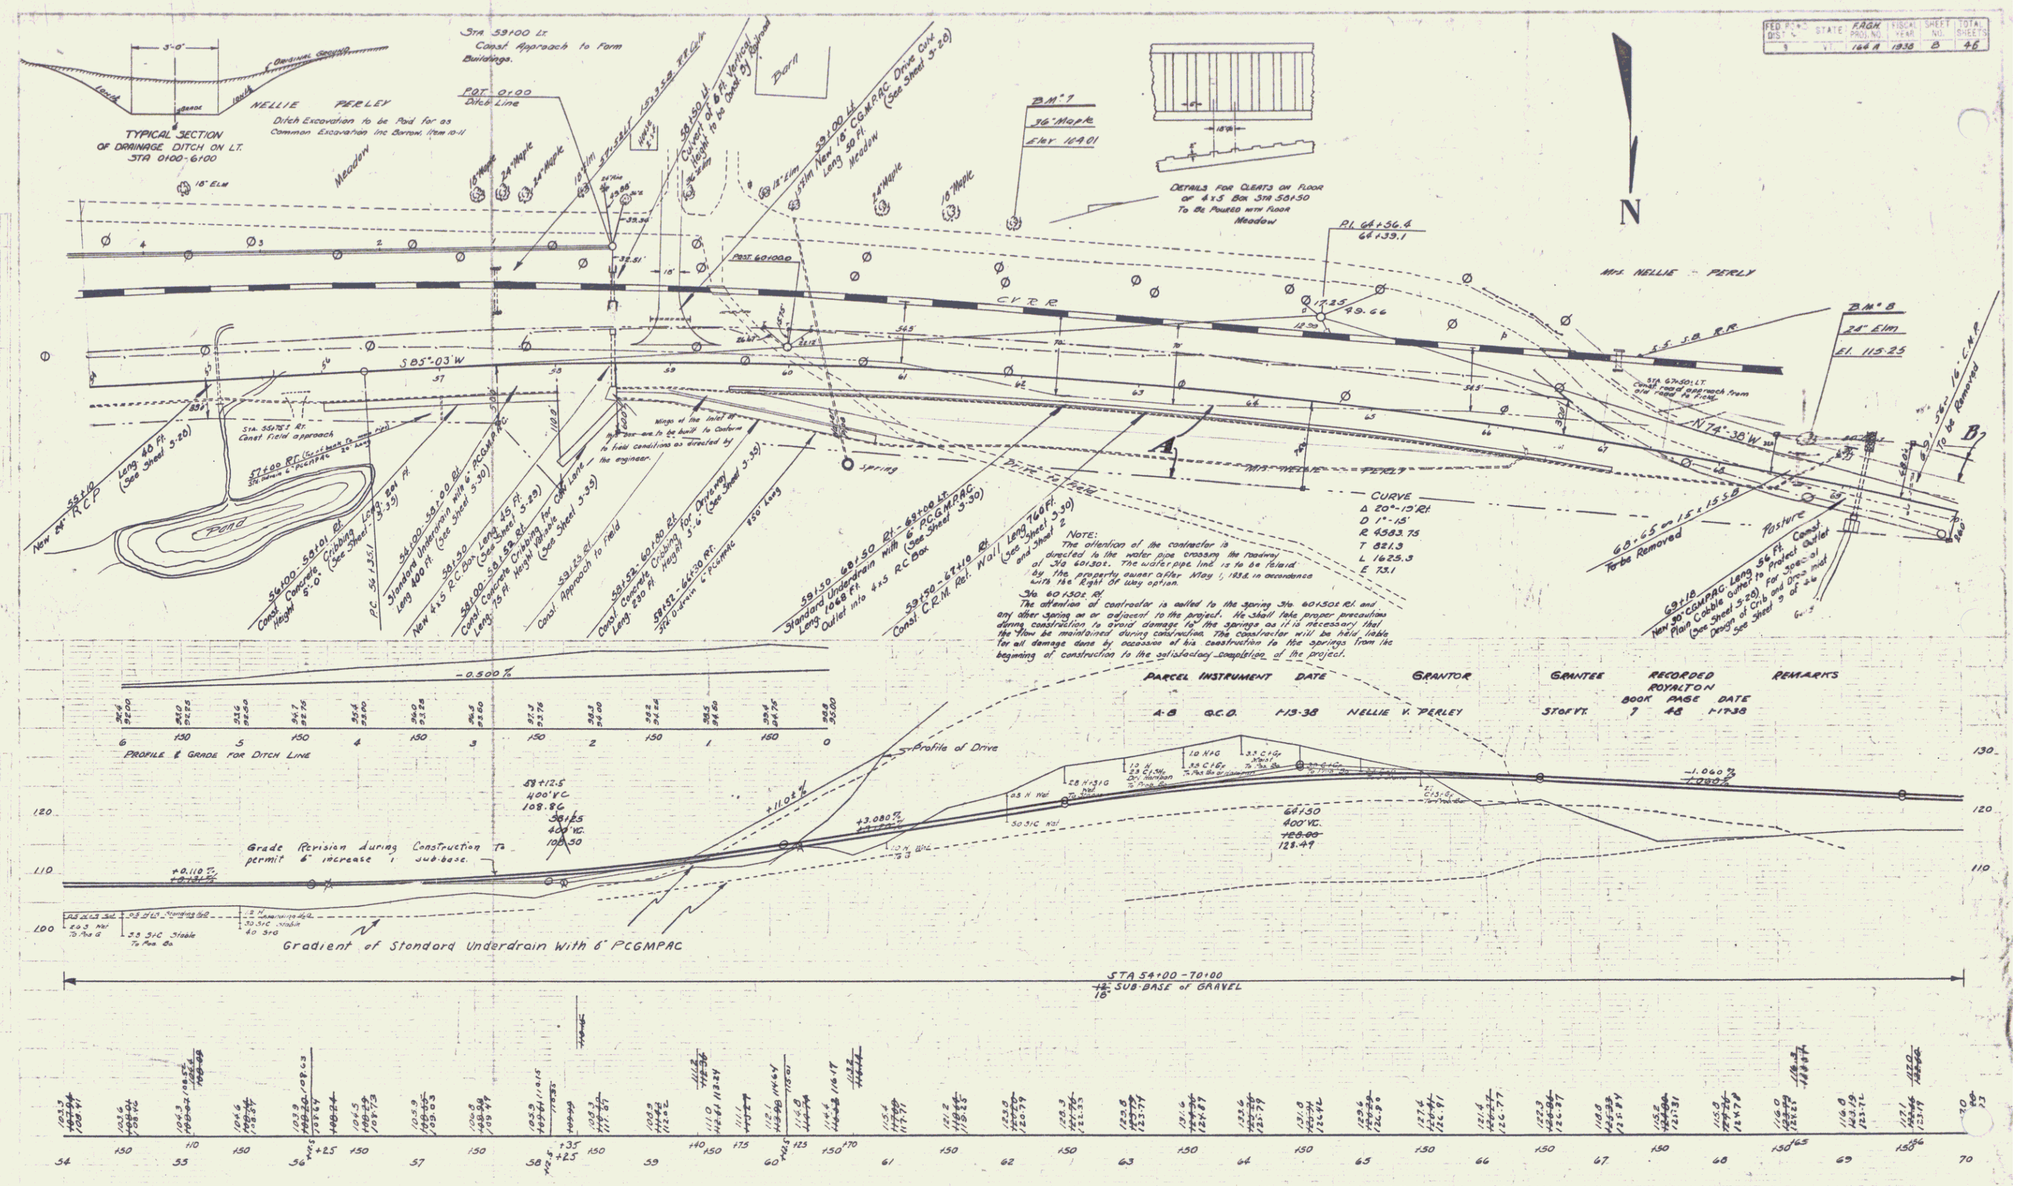

PARCEL	INSTRUMENT	DATE	GRANTOR	GRANTEE	RECORDED ROYALTON BOOK	PAGE	DATE	REMARKS
A-8	Q.C.D.	1-13-38	NELLIE V. PERLEY	STOFVT.	7	48	1-17-38	

6