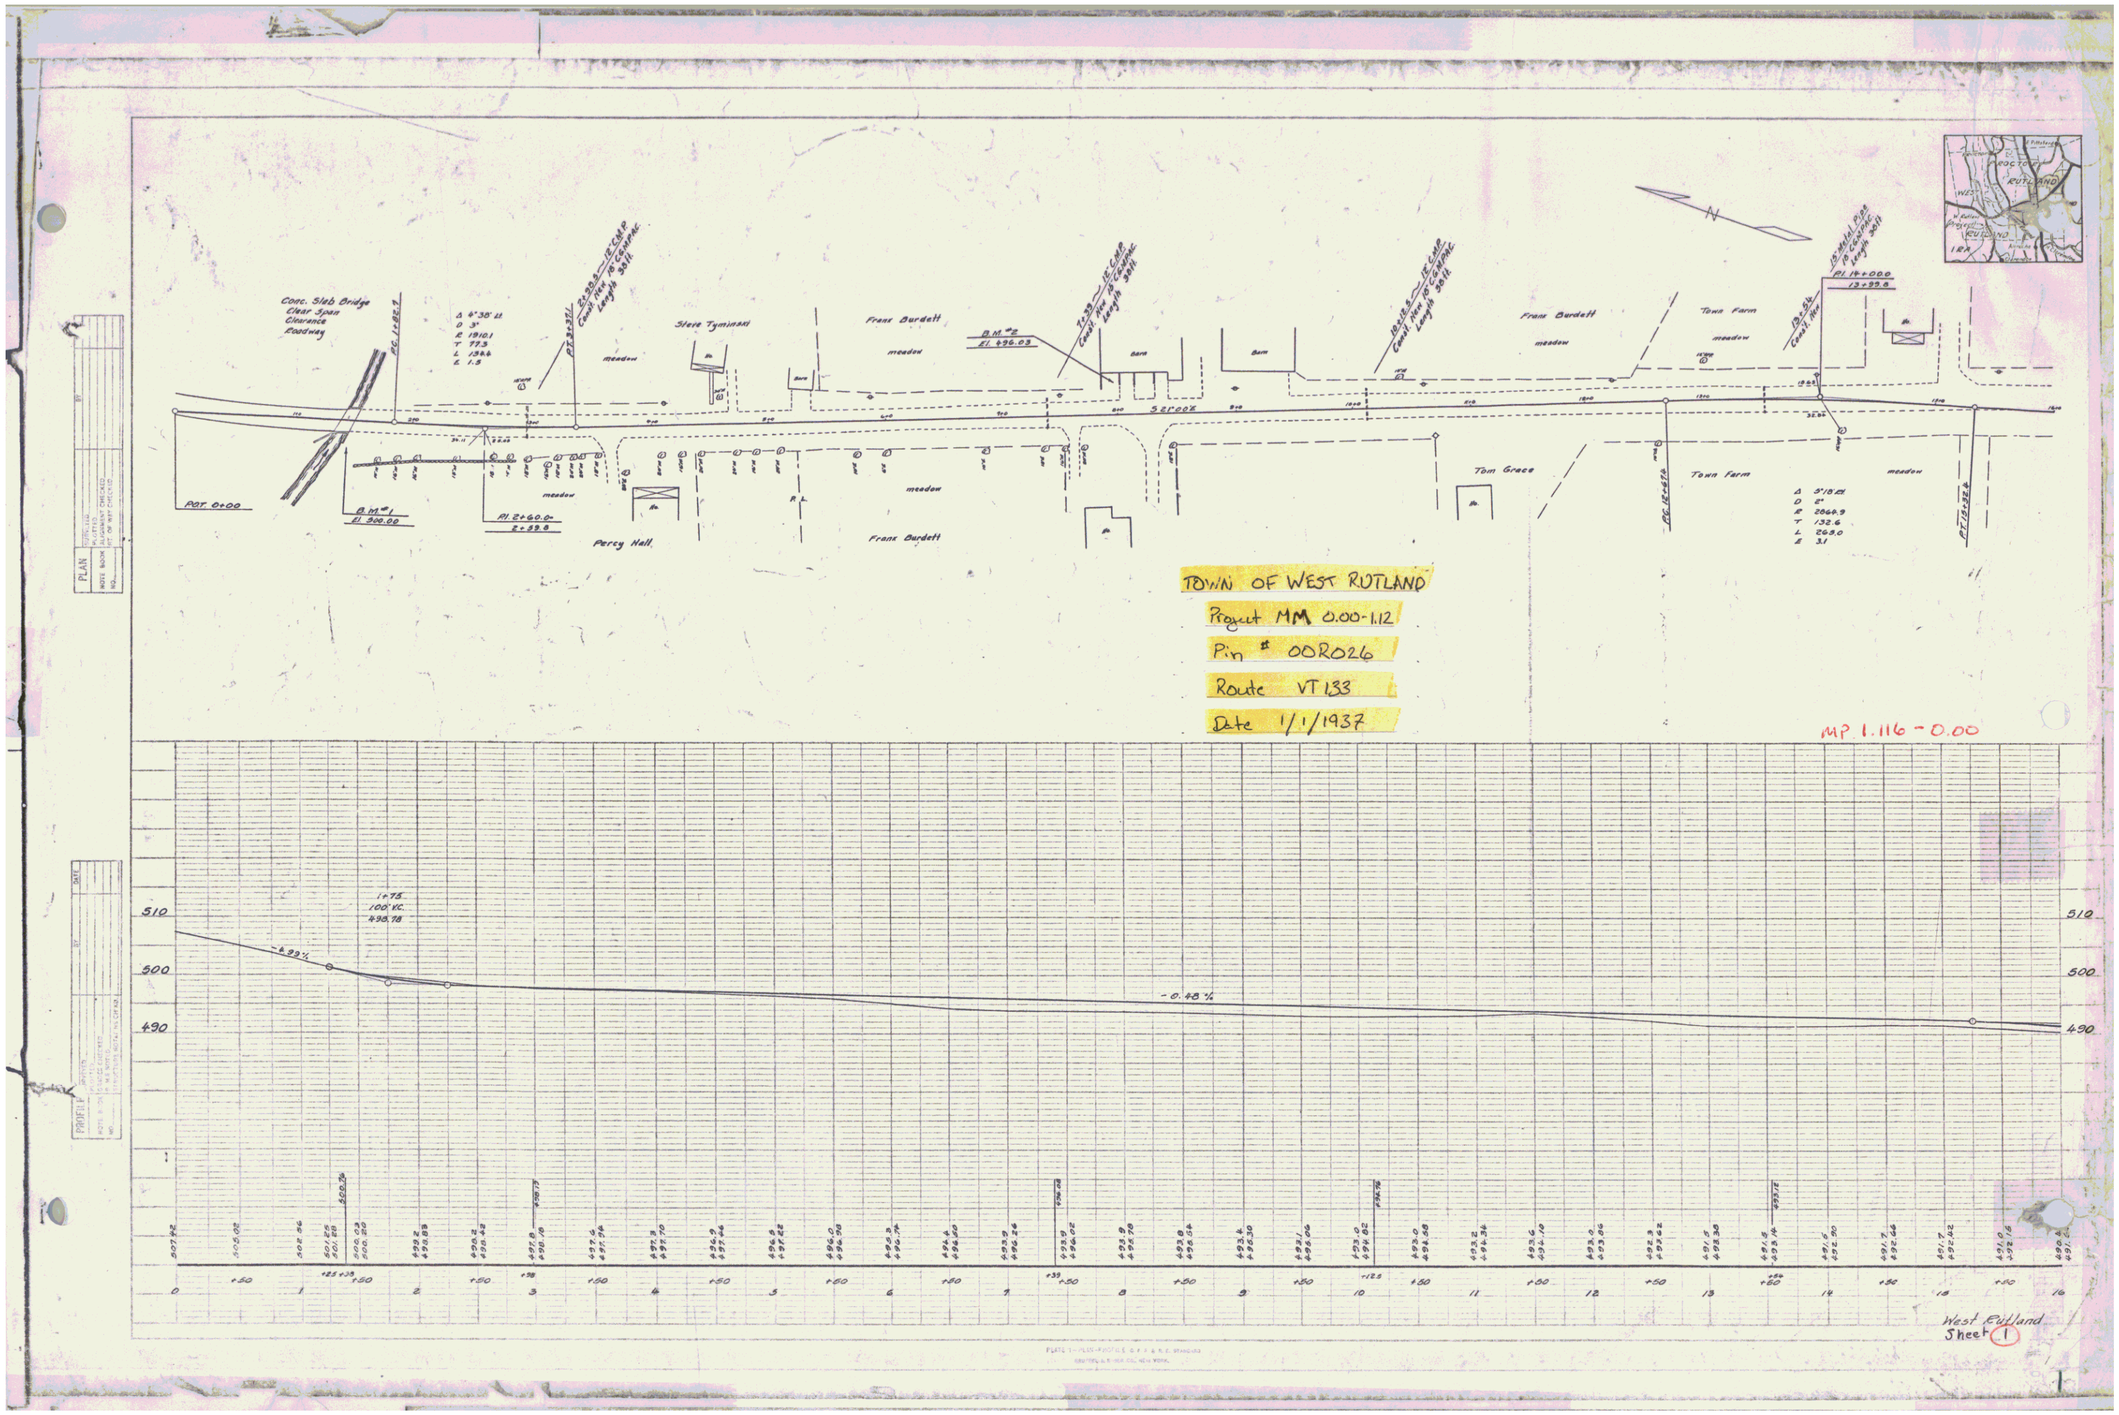
Conc. Slab Bridge
Clear Span
Clearance
Roadway
Steve Tyminski
Frank Burdett
meadow
barn
Percy Hall
Tom Grace
Town Farm
POT 0+00
TOWN OF WEST RUTLAND
Project MM 0.00-1.12
Pin # 00R026
Route VT 133
Date 1/1/1937
MP 1.116 - 0.00
-4.99%
-0.48%
510
500
490
West Rutland
Sheet 1