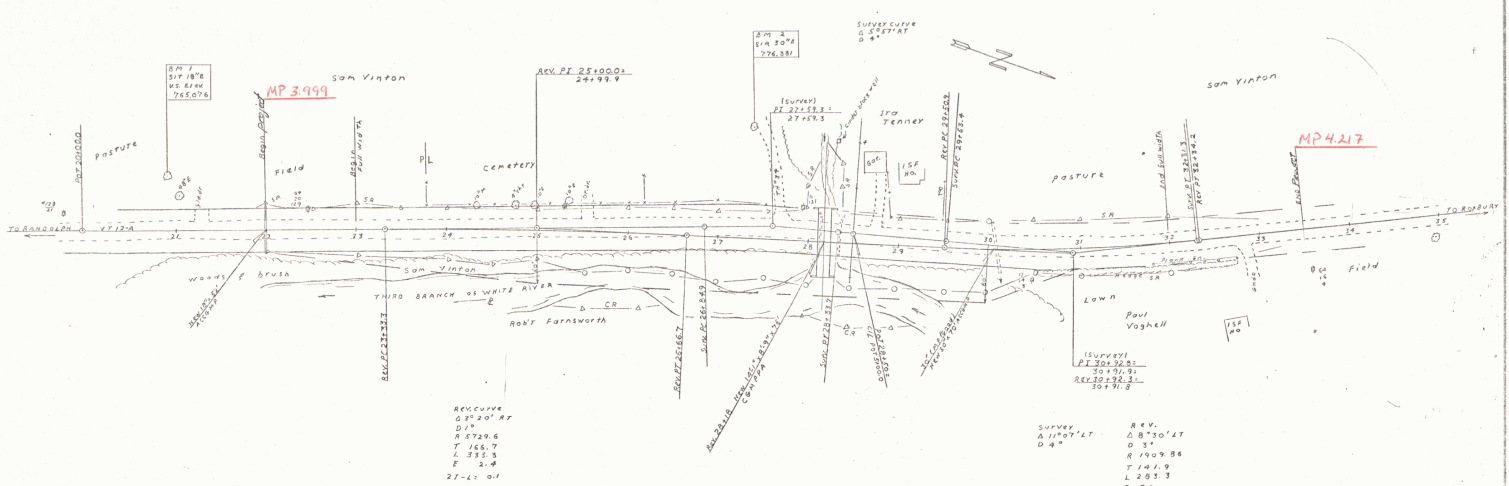

TOWN OF BRAINTREE

COUNTY OF ORANGE

VT ROUTE 12A

RANDOLPH-ROXBURY ROAD

BEGINNING AT A POINT 0.11 MILES SOUTHERLY OF THE JCT. WITH T.H. #39, AND EXTENDING NORTHERLY 1150 FEET.

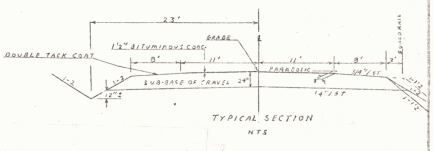

Pin # 00K027

APPROVED R.O.W. DIRECTOR	APPROVED DISTRICT ENGINEER	APPROVED HIGHWAY ENGINEER	APPROVED ASST. CHIEF ENGINEER	APPROVED CHIEF ENGINEER	TOWN BRAINTREE PROJECT BMA-670-2-67 BRIDGE No. 7 NEW 19'-1" x 8'-9" x 76" CGMPPA
DATE	DATE Feb 29, 1968	DATE	DATE	DATE	SHEET 1 OF 1

VT12A