PROFILE		BY	DATE
NOTE BOOK	SURVEYED		
	PLOTTED		
NO.	GRADES CHECKED		
	B. M. & NOTES		
	STRUCTURE NOTATIONS CH'KD		

PLAN		BY	DATE
NOTE BOOK	SURVEYED		
	PLOTTED		
NO.	ALIGNMENT CHECKED		
	RT. OF WAY CHECKED		

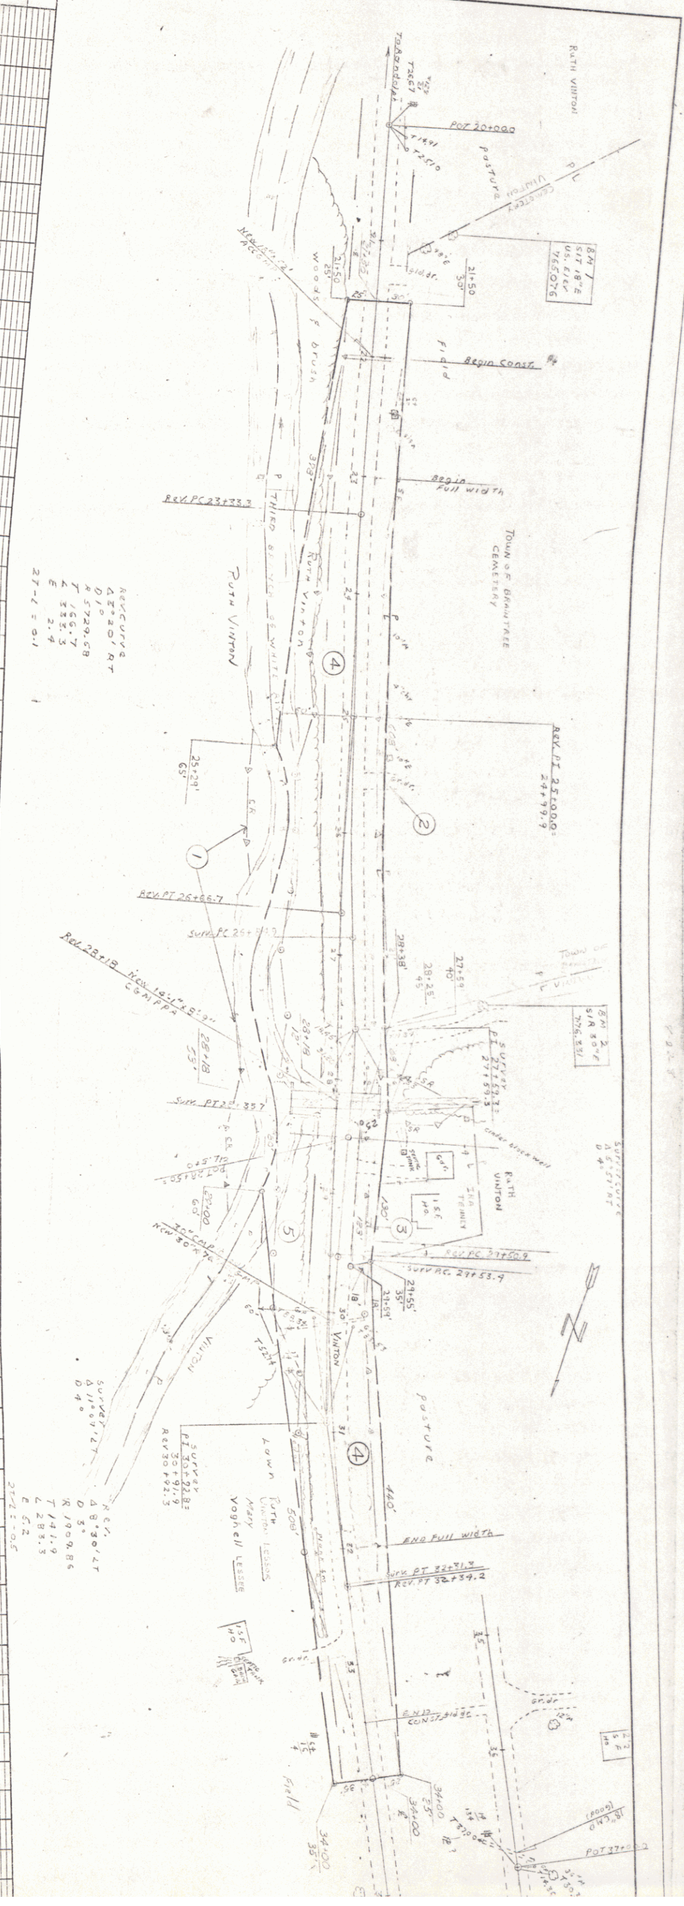
Begin Full width
End Full width
Pasture
Lawn
Fill
Rev. PC 23+33.3
Rev. PT 25+00.0
24+99.9
Rev. PT 26+66.7
Surv. PT 26+49.2
Surv. PT 32+71.4
Rev. PT 32+34.2
Surv. PC 27+60.9
Surv. PC 27+53.9
Surv. PT 35.7
Rev. PT 30+22.3
Rev. 28+19
28+18
28+38
29+55
30+00
30+90
31+50
32+00
34+00
Rev. Curve
Surv. Curve
Δ = 8°30'47"
D = 5°
R = 1009.86
T = 141.9
L = 283.3
E = 5.2
C = 282.9
27+-1 = 10+
Ruth Vinton
Town Line
Begin Curve
Begin Spiral
Pot 30+000
Ruth Vinton
Vinton
Mary Vogrell Estate
Ruth Vinton Estate
