STATE			
234-L	1941	7	46

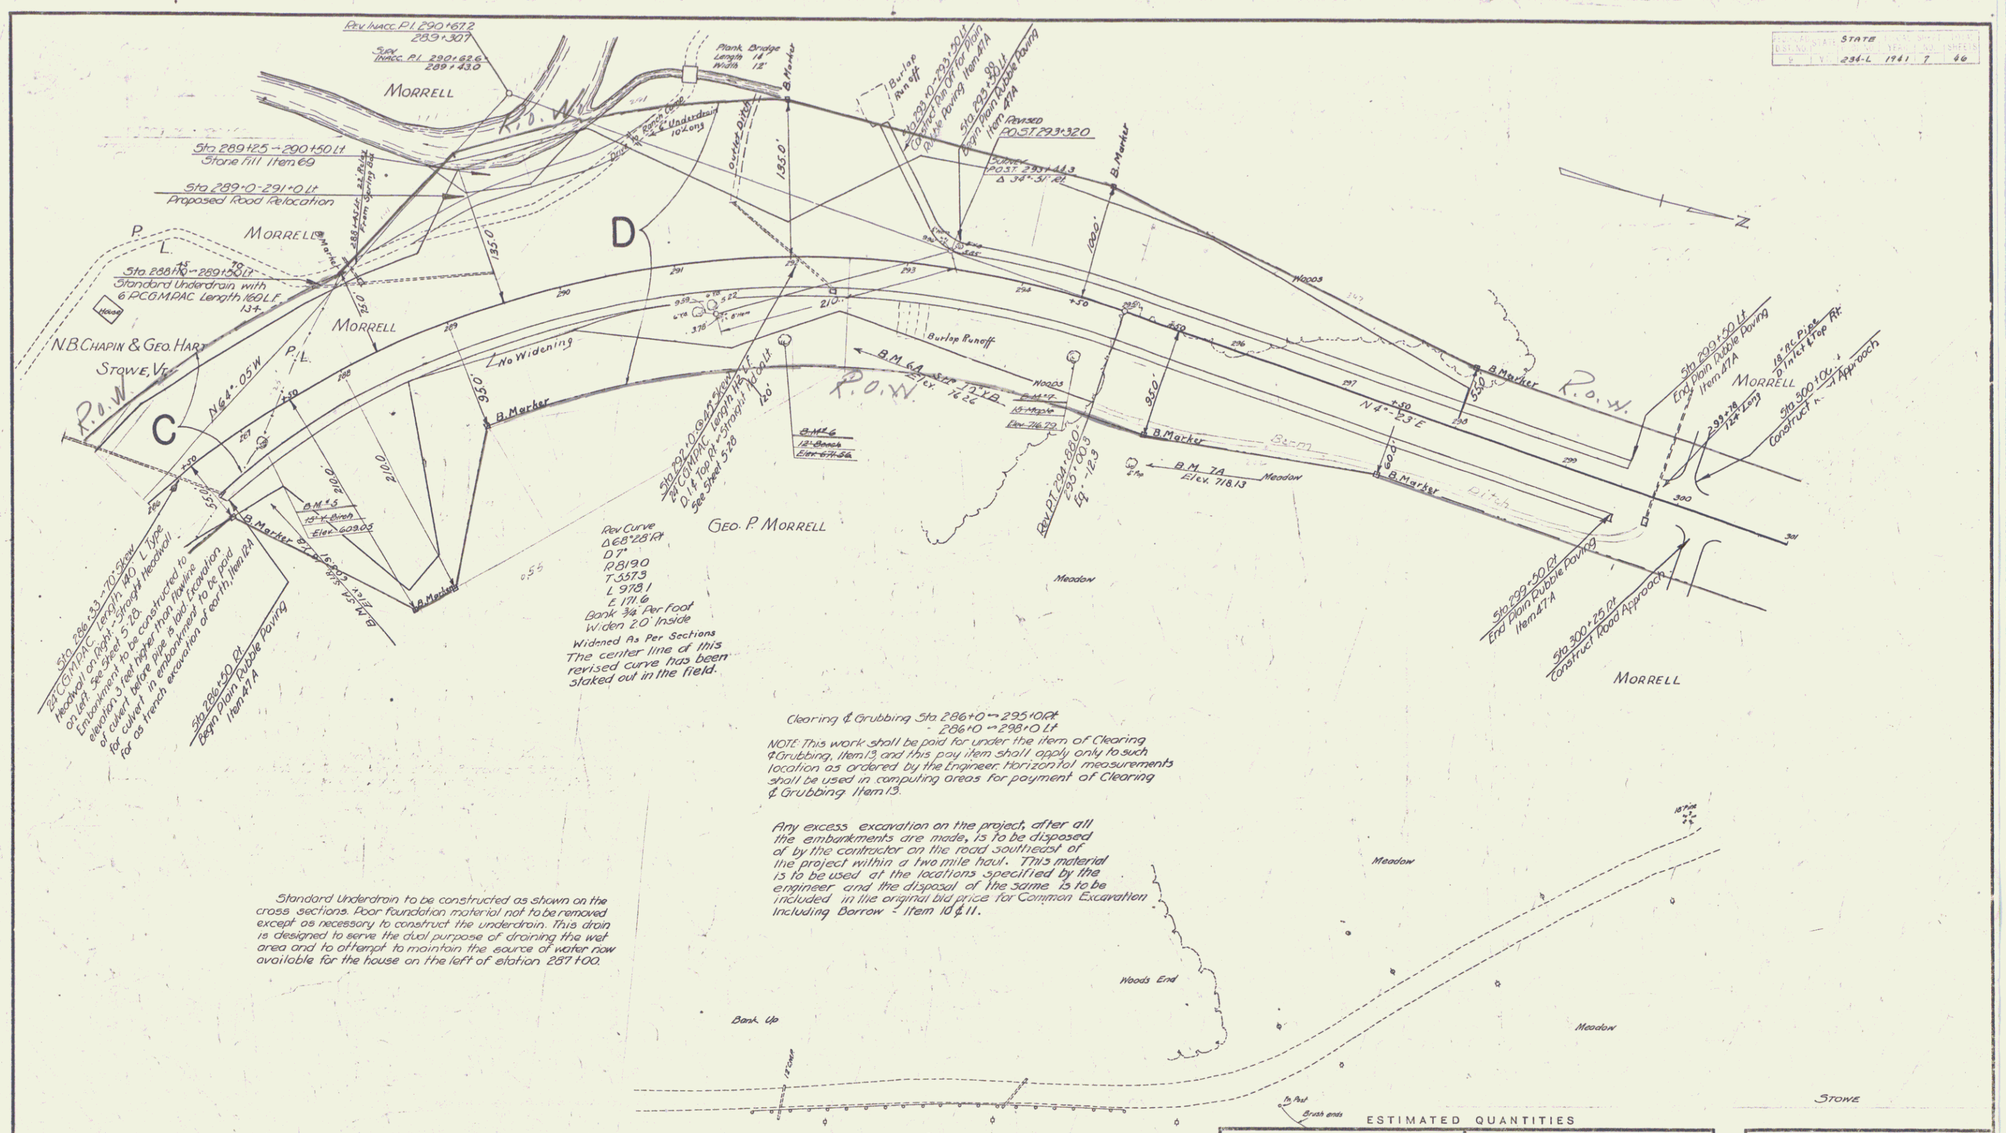

Surveyed by C.E. Putnam
Designed by A.J. Runnals
Drawn by W.J. Brock
Traced by " "
Checked by
Series STATE No. 234-L Filed
Sheet 7 of 66 Sheets

4