FED. ROAD DIST. NO.	STATE	PROJECT NO.	SHEET NO.	TOTAL SHEETS
9	VT.	234-L 1941	9	46

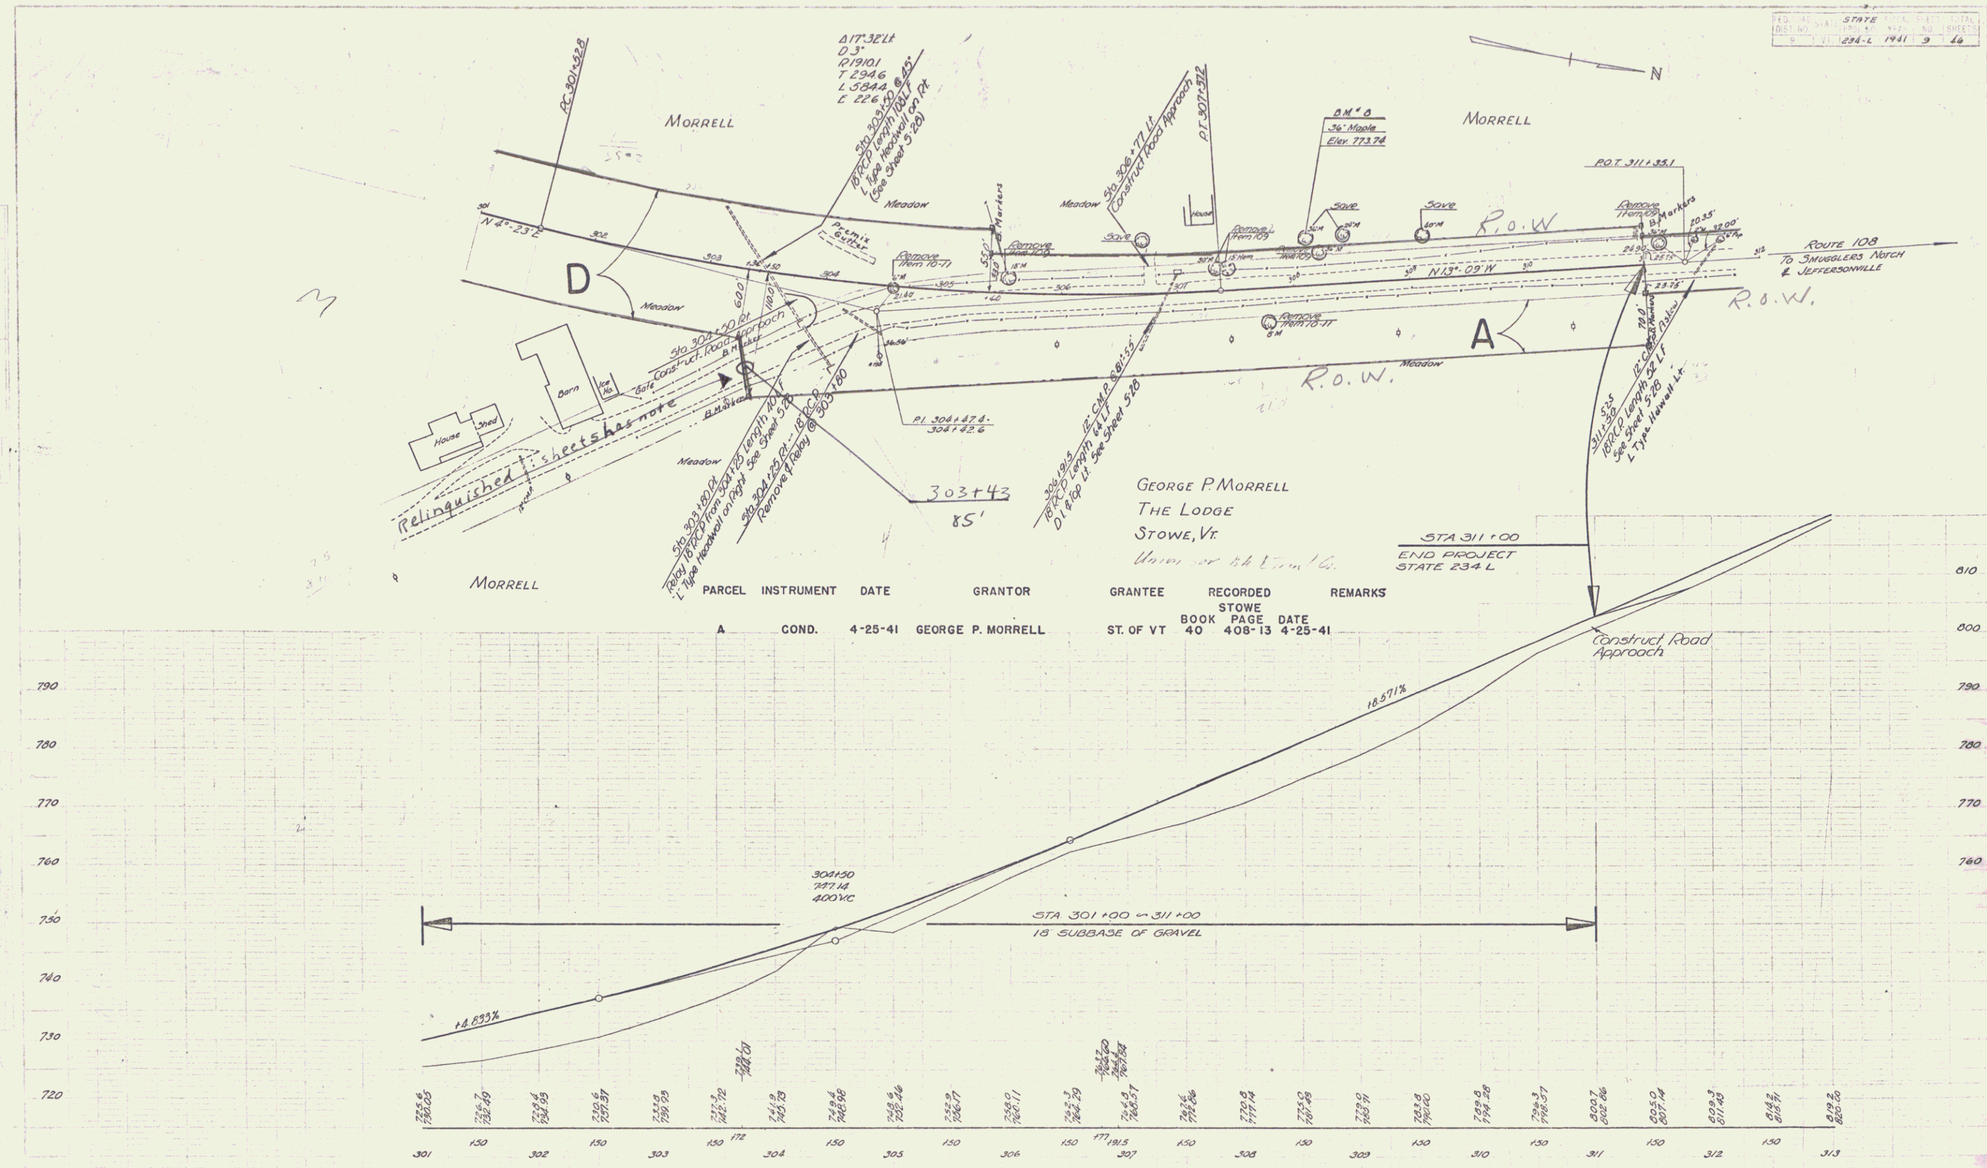

PARCEL	INSTRUMENT	DATE	GRANTOR	GRANTEE	RECORDED STOWE BOOK	PAGE	DATE	REMARKS
A	COND.	4-25-41	GEORGE P. MORRELL	ST. OF VT	40	408-13	4-25-41	

STOWE
SERIES STATE NO. 234-L
SHEET 9 OF 46

57