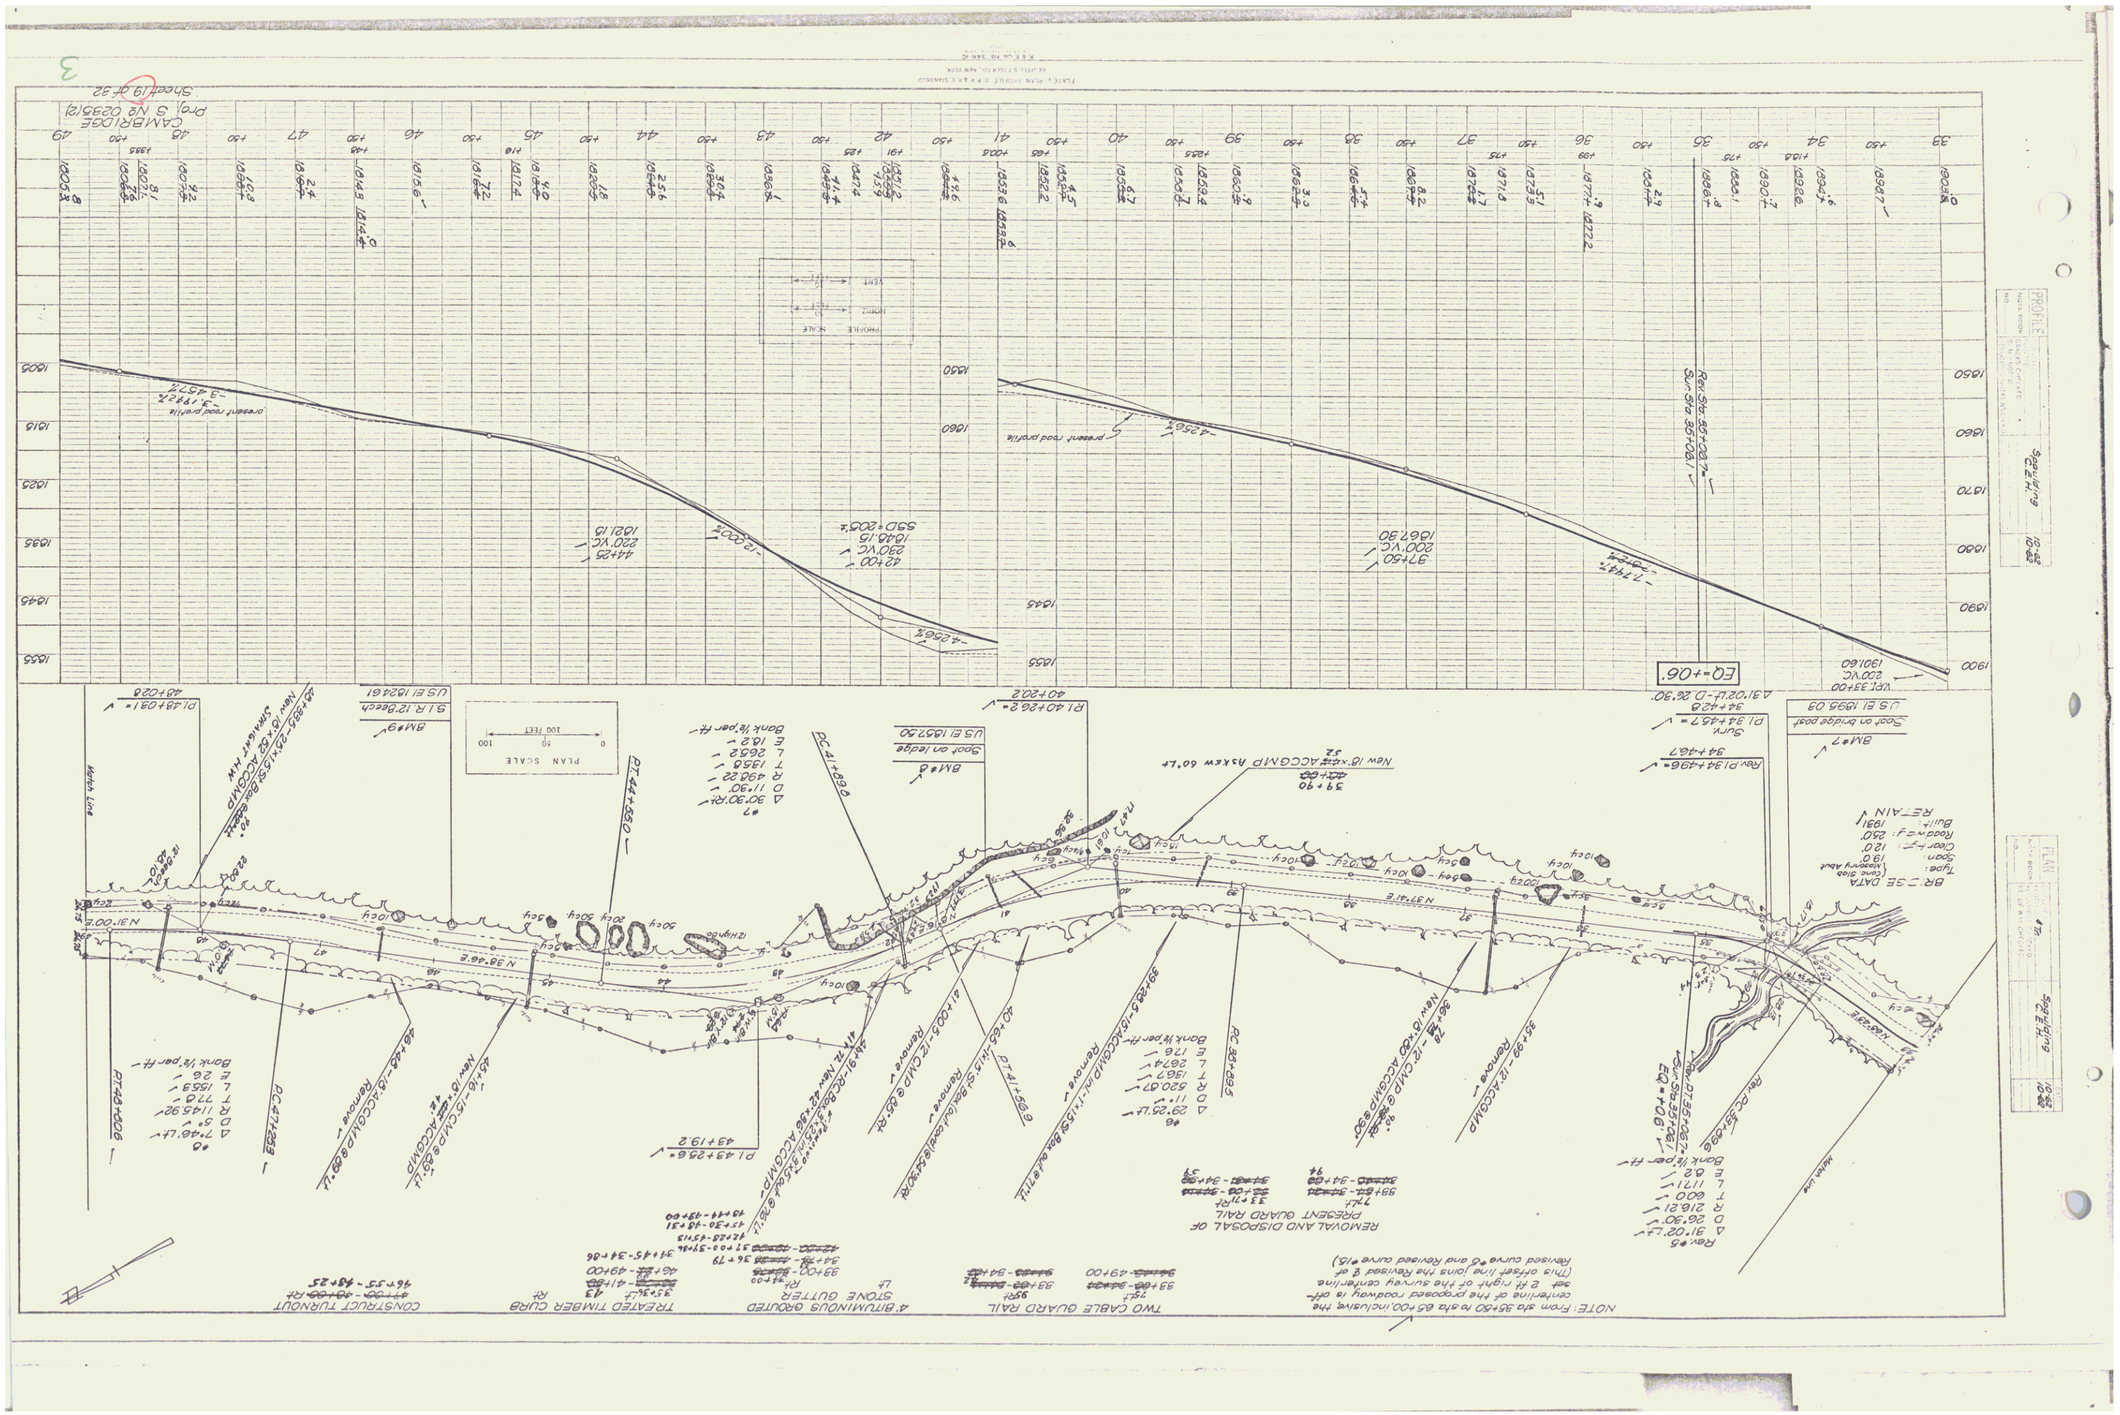
PROFILE
PLAN
NOTE: From sta 35+50 to sta 65+00 inclusive the centerline of the proposed roadway is offset 2 ft right of the survey centerline (This offset line joins the revised ℄ of revised curve #6 and revised curve #15.)
TWO CABLE GUARD RAIL
4" BITUMINOUS GROUTED STONE GUTTER
TREATED TIMBER CURB
CONSTRUCT TURNOUT
REMOVAL AND DISPOSAL OF PRESENT GUARD RAIL
PLAN SCALE
0 50 100
100 FEET
PROFILE SCALE
HORIZ
VERT
BR-SE DATA
Type: Concrete Slab
Span: 19.0'
Clear H: 12.0'
Roadway: 24: 26.0'
Built: 1931
RETAIN
Sheet 19 of 92
CAMBRIDGE
Proj. S No 0235(2)
3