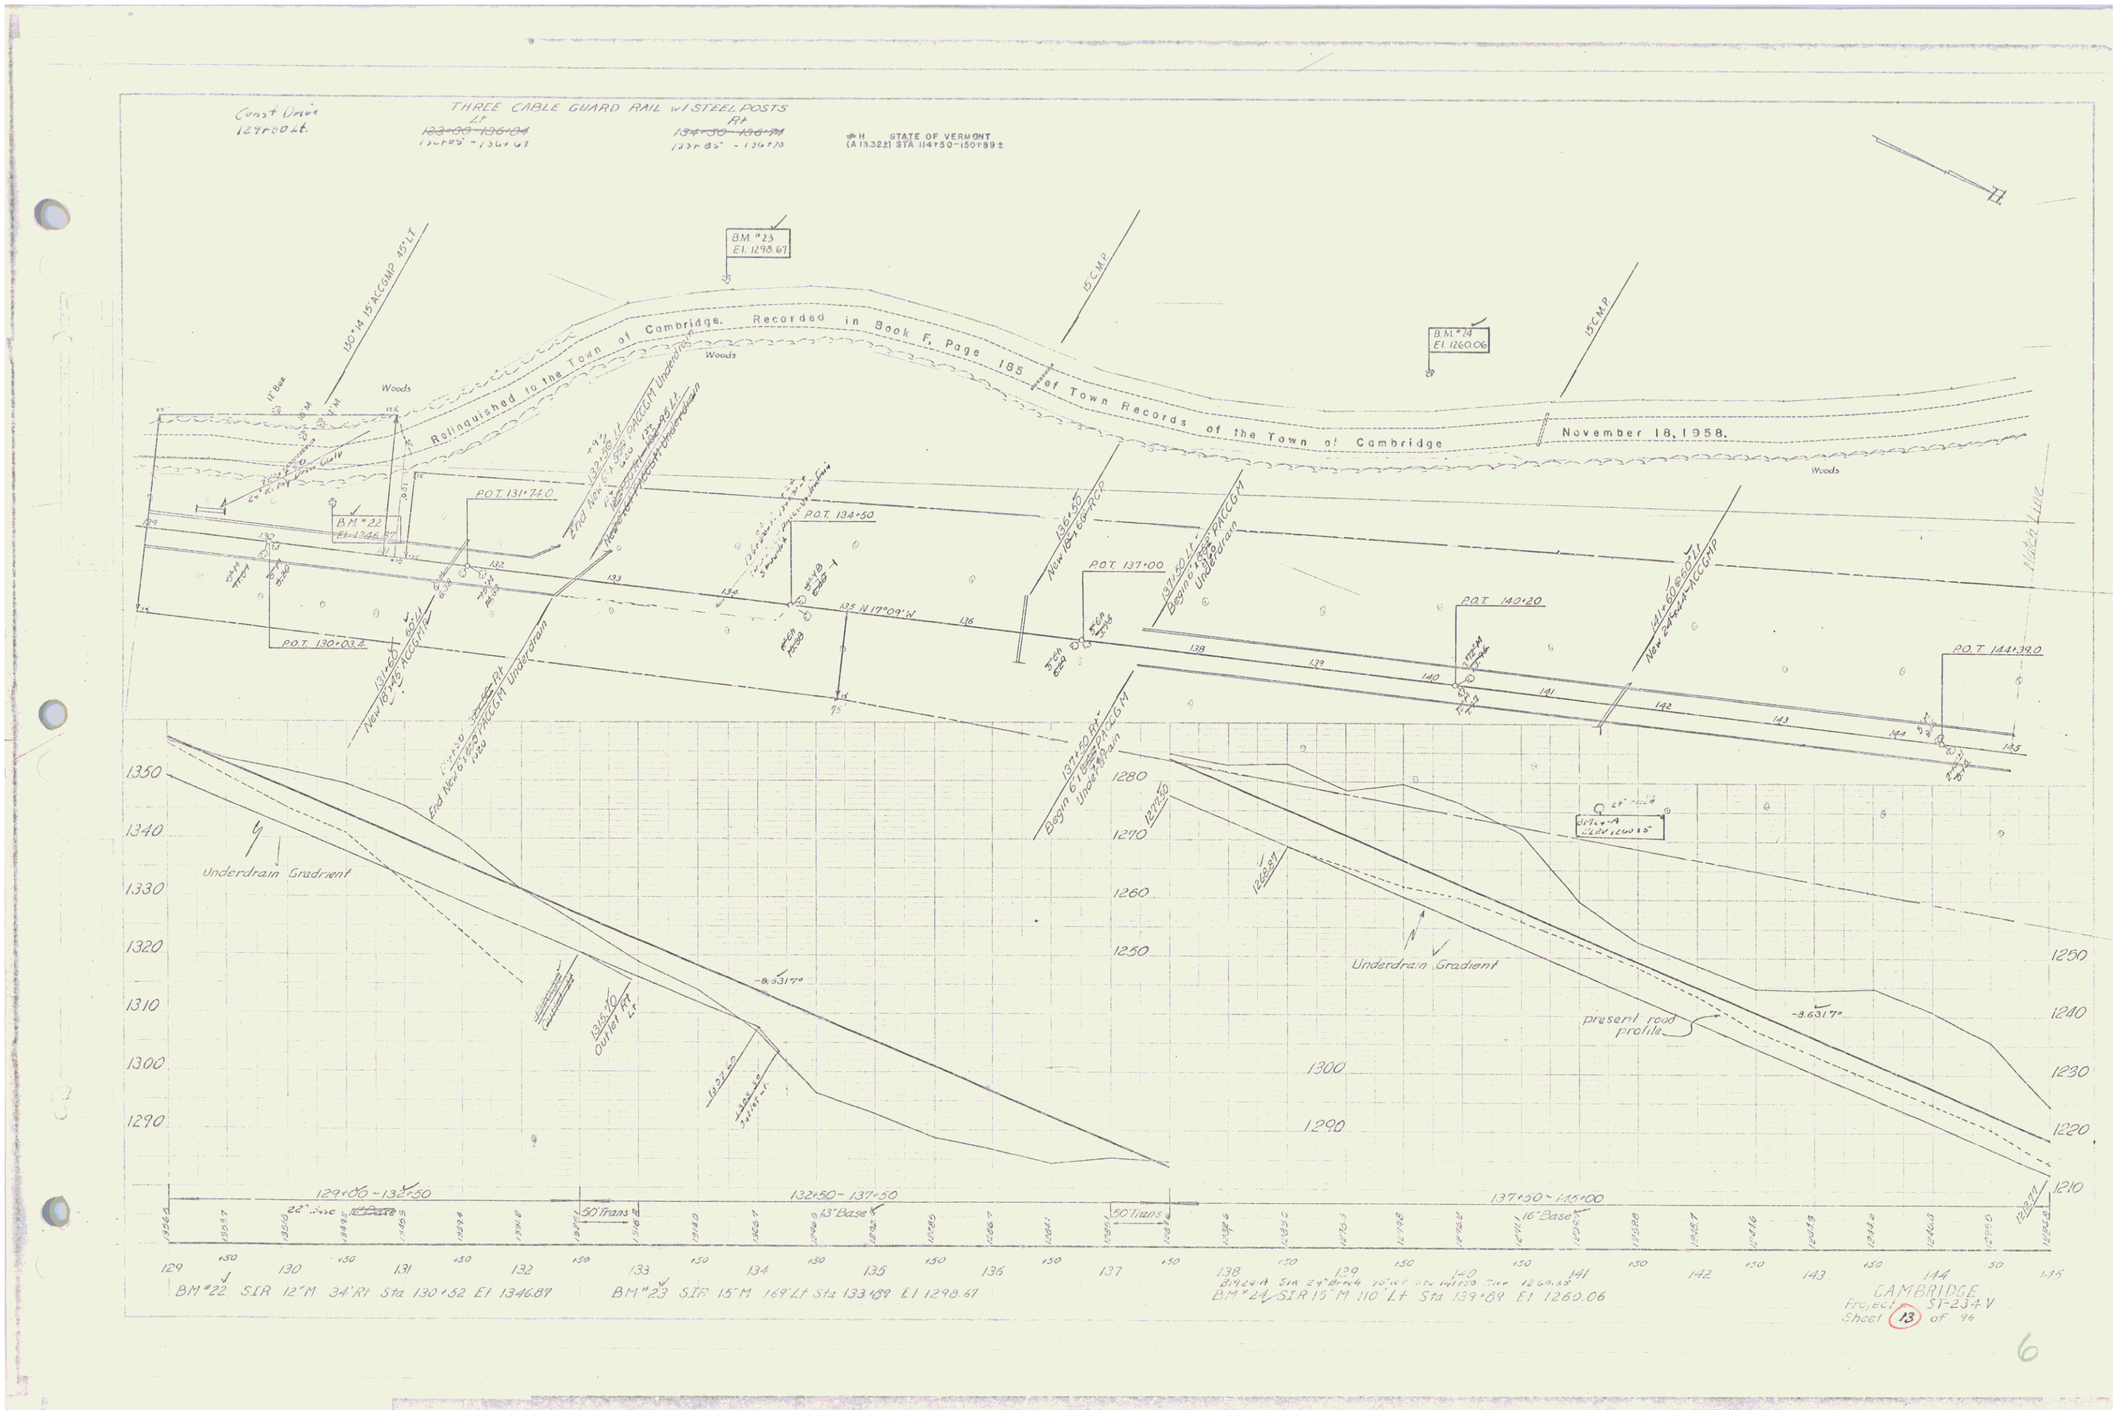
Const Drive
127+00 Lt.
THREE CABLE GUARD RAIL w/ STEEL POSTS
LT
~~129+00 - 136+04~~
130+09 - 136+41
RT
~~134+50 - 136+74~~
133+85 - 136+13
STATE OF VERMONT
(A 13.322) STA 114+50-150+89±
B.M. #23
El. 1298.67
B.M. #24
El. 1260.06
B.M. #22
~~El. 1346.87~~
Relinquished to the Town of Cambridge. Recorded in Book F, Page 185 of Town Records of the Town of Cambridge November 18, 1958.
Woods
15" C.M.P.
130+14 15" ACCGMP 45' LT.
P.O.T. 130+03.2
P.O.T. 131+74.0
P.O.T. 134+50
P.O.T. 137+00
P.O.T. 140+20
P.O.T. 144+39.0
135 N 17°09' W
Underdrain Gradient
present road profile
-8.63%
129+00 - 132+50
132+50 - 137+50
137+50 - 145+00
50' Trans
13" Base
16" Base
BM #22 SIR 12" M 34' Rt Sta 130+32 El 1346.87
BM #23 SIR 15" M 169' Lt Sta 133+89 El 1298.67
BM #24 SIR 15" M 110' Lt Sta 139+89 El 1260.06
CAMBRIDGE
Project ST-23+V
Sheet 13 of 96

6