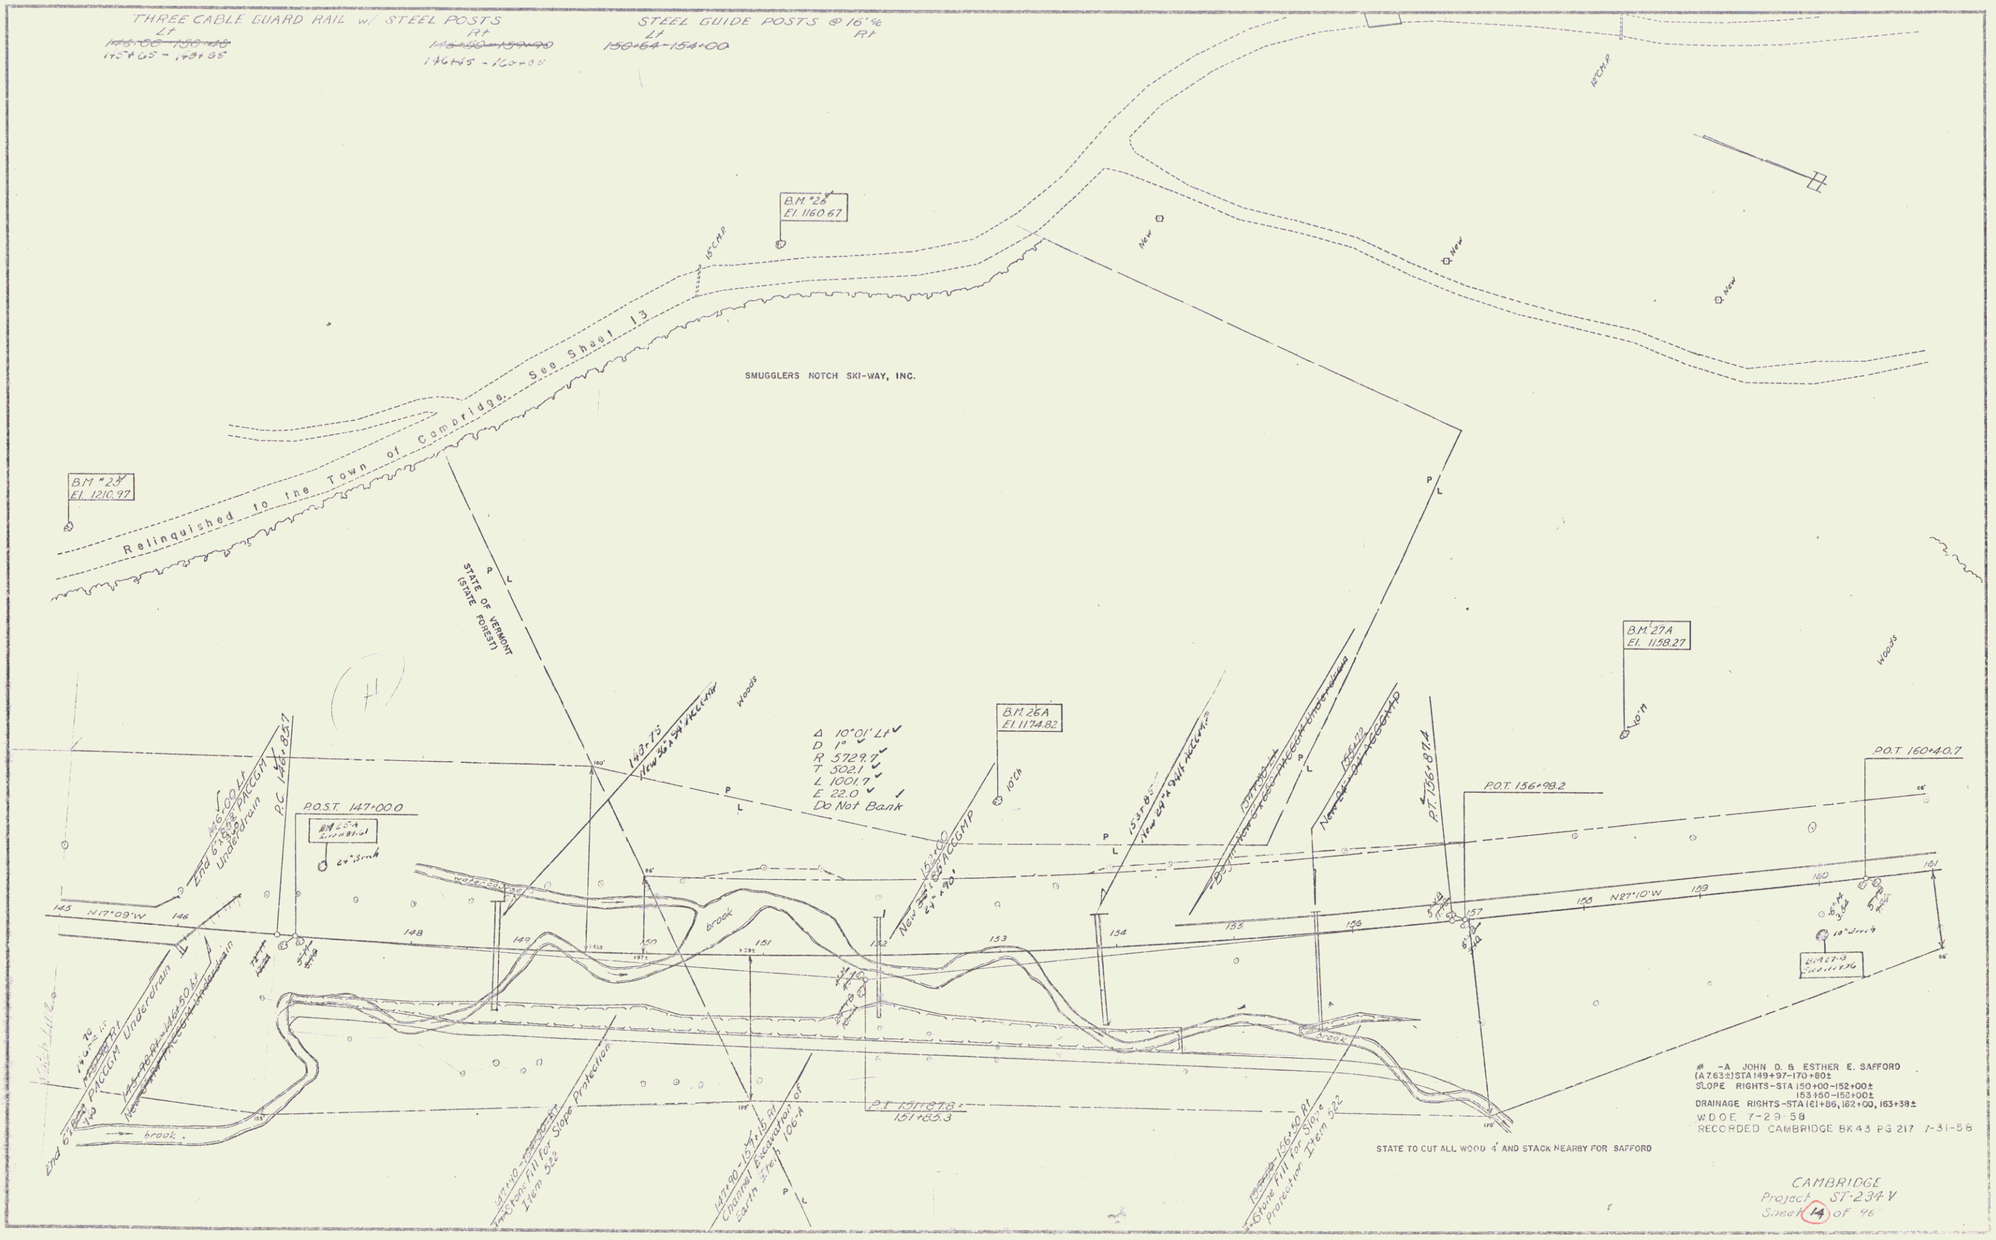
THREE CABLE GUARD RAIL w/ STEEL POSTS
Lt
~~145+05 - 150+05~~
145+05 - 148+05
Rt
~~145+05 - 150+05~~
146+45 - 150+05
STEEL GUIDE POSTS @ 16'%
Lt
150+64 - 154+00
Rt
BM #26
El. 1160.67
BM #25
El. 1210.97
Relinquished to the Town of Cambridge. See Sheet 13
SMUGGLERS NOTCH SKI-WAY, INC.
STATE OF VERMONT
(STATE FOREST)
BM 27A
El. 1158.27
BM 26A
El. 1174.82
Woods
Δ 10°01' Lt
D 1°
R 5729.7
T 502.1
L 1001.7
E 22.0
Do Not Bank
P.O.S.T. 147+00.0
P.O.T. 156+98.2
P.O.T. 160+40.7
P.T. 156+87.4
N17°09'W
N27°10'W
brook
P.T. 147+87.8
151+85.3
STATE TO CUT ALL WOOD 4' AND STACK NEARBY FOR SAFFORD
# -A JOHN D. & ESTHER E. SAFFORD
(A 7.63±) STA 149+97-170+80±
SLOPE RIGHTS-STA 150+00-152+00±
153+50-158+00±
DRAINAGE RIGHTS-STA 161+86, 162+00, 163+38±
WDOE 7-29-58
RECORDED CAMBRIDGE BK 43 PG 217 7-31-58
CAMBRIDGE
Project ST-234 V
Sheet 14 of 46

7