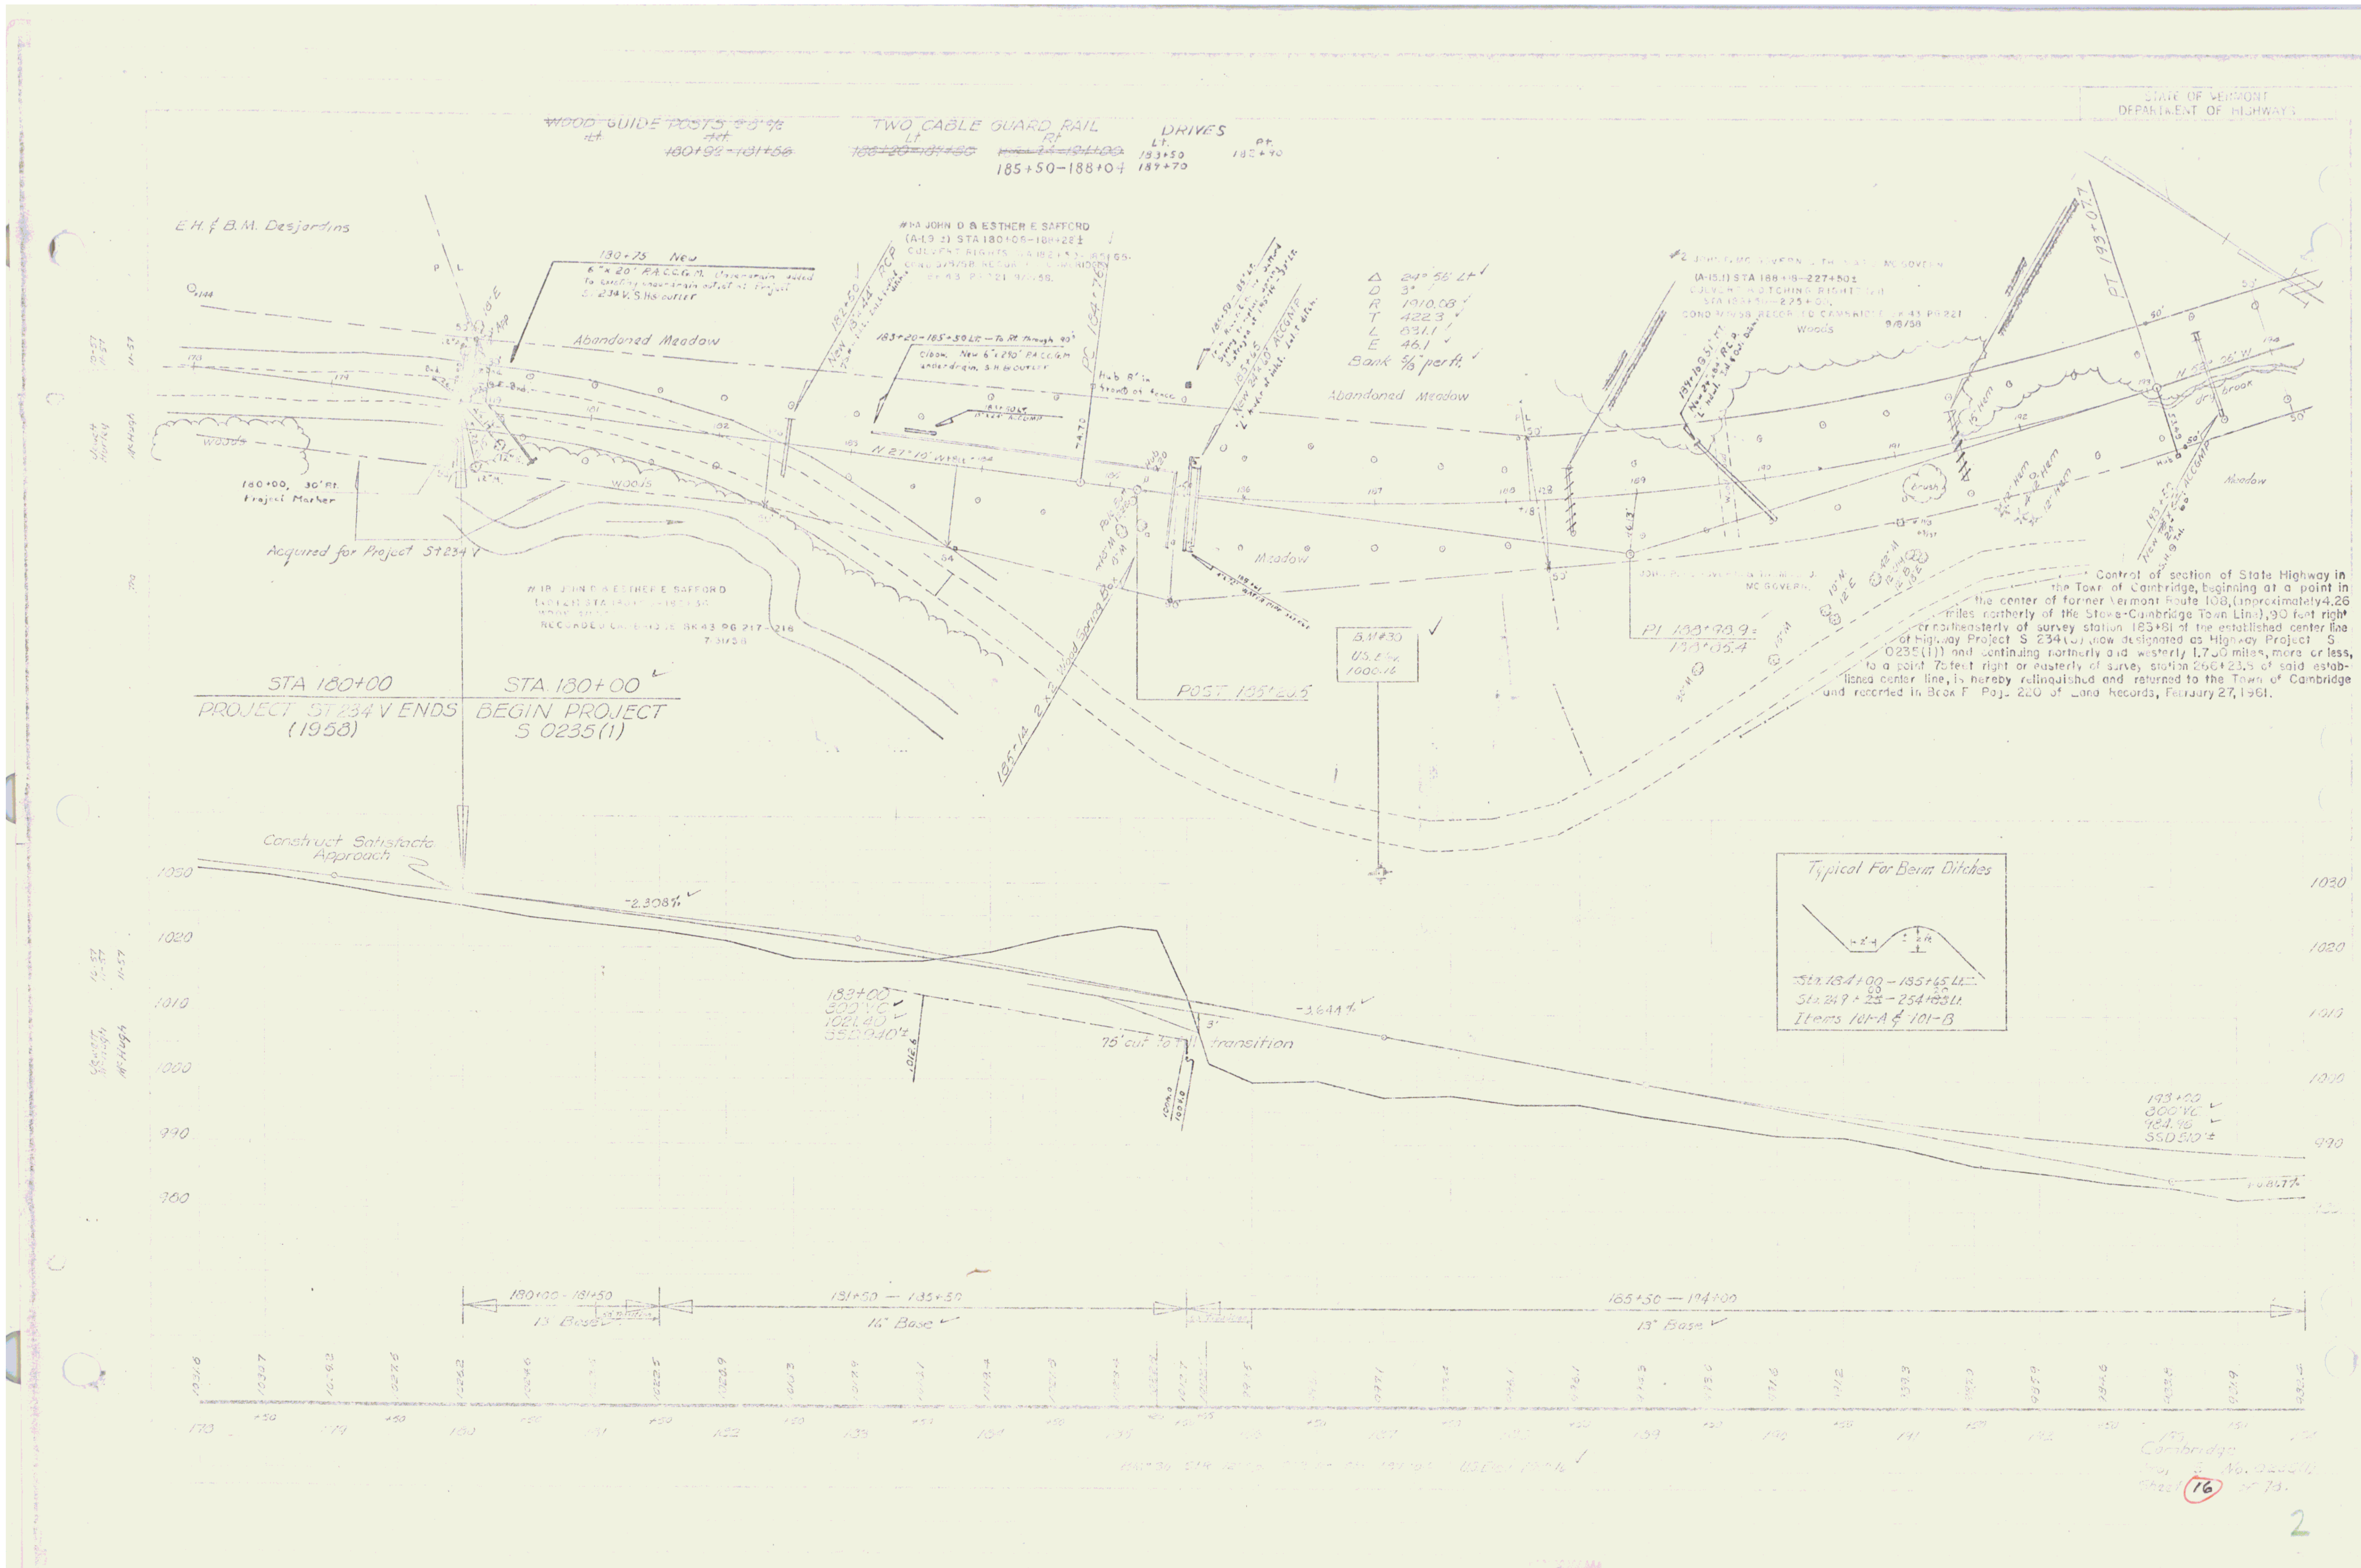
STATE OF VERMONT
DEPARTMENT OF HIGHWAYS
WOOD GUIDE POSTS
Lt.
Rt.
180+92–181+56
TWO CABLE GUARD RAIL
Lt.
Rt.
185+50–188+04
DRIVES
Lt.
183+50
189+70
Rt.
182+90
E.H. & B.M. Desjardins
180+75 New
6" x 20' P.A.C.C.G.M. Underdrain added
#1-A JOHN D & ESTHER E SAFFORD
(A-1.9 ±) STA 180+08–188+28 ±
Abandoned Meadow
Woods
Meadow
brush
180+00, 30' Rt.
Project Marker
Acquired for Project St 234 V
Δ 24° 56' Lt.
D 3°
R 1910.08
T 422.3
L 831.1
E 46.1
Bank 5/8" per ft.
STA 180+00
PROJECT ST 234 V ENDS
(1958)
STA 180+00
BEGIN PROJECT
S 0235(1)
POST 185+20.5
B.M. #30
U.S.G.S.
1000.16
PI 188+90.9
Control of section of State Highway in the Town of Cambridge, beginning at a point in the center of former Vermont Route 108, (approximately 4.26 miles northerly of the Stowe-Cambridge Town Line), 90 feet right or northeasterly of survey station 183+81 of the established center line of Highway Project S 234(3) (now designated as Highway Project S 0235(1)) and continuing northerly and westerly 1.750 miles, more or less, to a point 75 feet right or easterly of survey station 266+23.5 of said established center line, is hereby relinquished and returned to the Town of Cambridge and recorded in Book F Page 220 of Land Records, February 27, 1961.
Construct Satisfactory Approach
-2.308%
-1.841%
75' cut to fill transition
Typical For Berm Ditches
Items 101-A & 101-B
1030
1020
1010
1000
990
980
180+00 – 181+50
13" Base
181+50 – 185+50
16" Base
185+50 – 194+00
13" Base
Cambridge
Proj. S No. 0235(1)
Sheet 16 of 78.
2