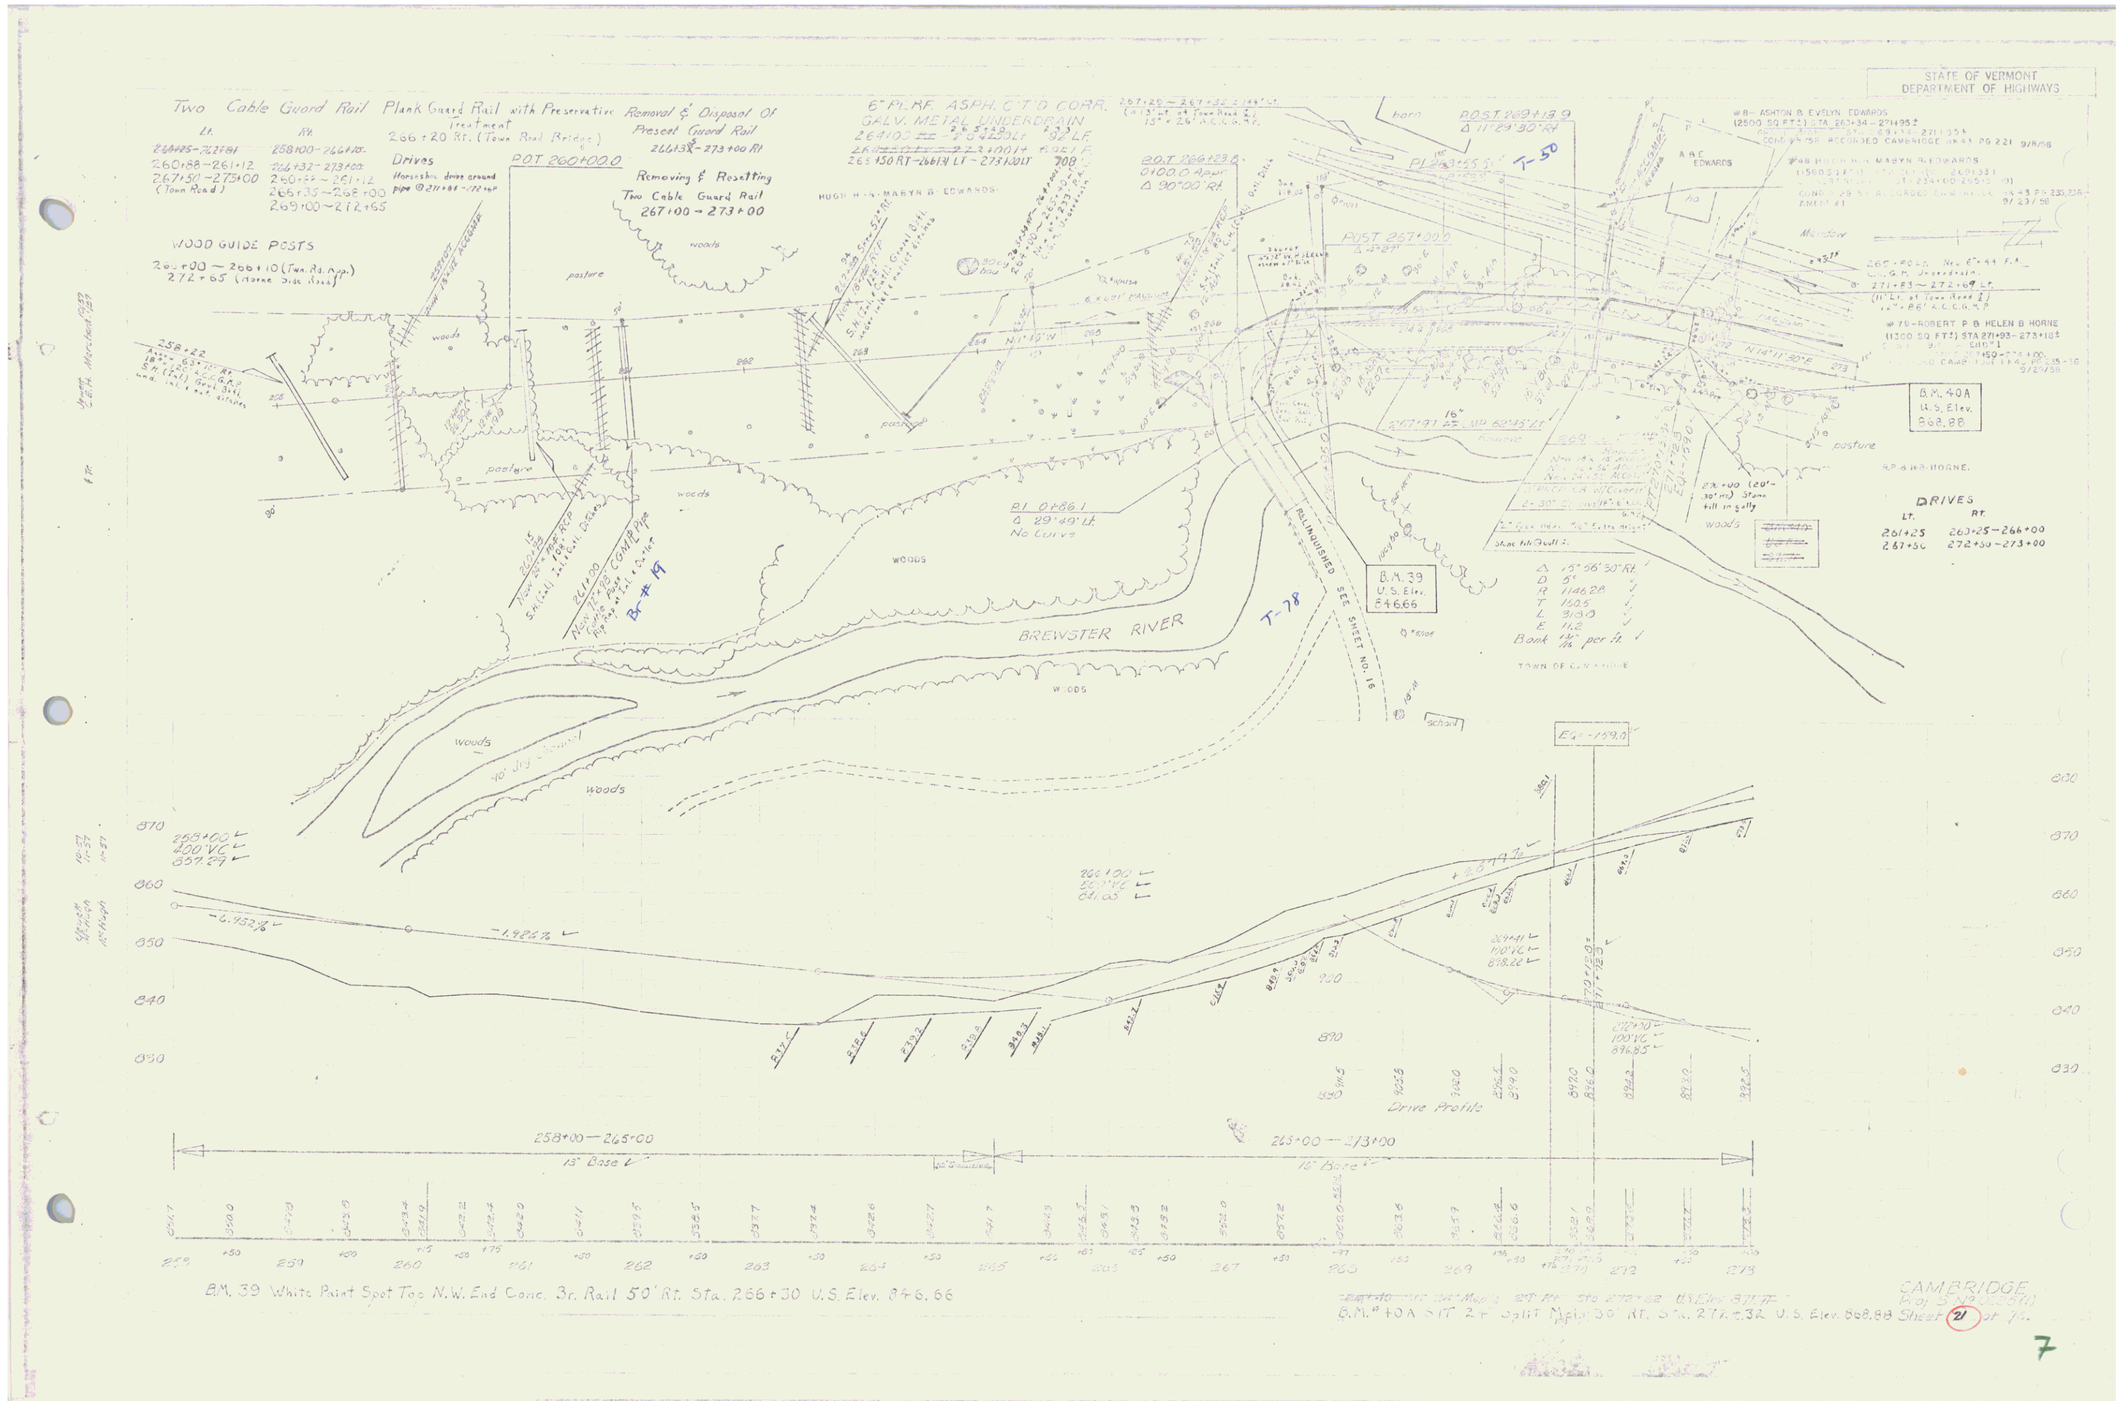
STATE OF VERMONT
DEPARTMENT OF HIGHWAYS
Two Cable Guard Rail
Plank Guard Rail with Preservative Treatment
Removal & Disposal Of Present Guard Rail
Lt.
Rt.
Drives
Horseshoe drive around pipe @ 271+88 - 272+40
WOOD GUIDE POSTS
P.O.T. 260+00.0
Removing & Resetting Two Cable Guard Rail 267+00 → 273+00
6" PLAIN ASPH. C.T.D. CORR. GALV. METAL UNDERDRAIN
HUGH H. & MARYN B. EDWARDS
POST 269+13.9
POST 267+00.0
B.M. 40A U.S. Elev. 868.88
B.M. 39 U.S. Elev. 846.66
BREWSTER RIVER
RELINQUISHED SEE SHEET NO. 16
T-50
T-78
BC #19
Drives
Lt.
Rt.
261+25
263+25 - 266+00
267+50
272+50 - 273+00
Drive Profile
258+00 — 265+00
15' Base
265+00 — 273+00
16' Base
B.M. 39 White Paint Spot Toe N.W. End Conc. Br. Rail 50' Rt. Sta. 266+30 U.S. Elev. 846.66
CAMBRIDGE
Sheet 21

7