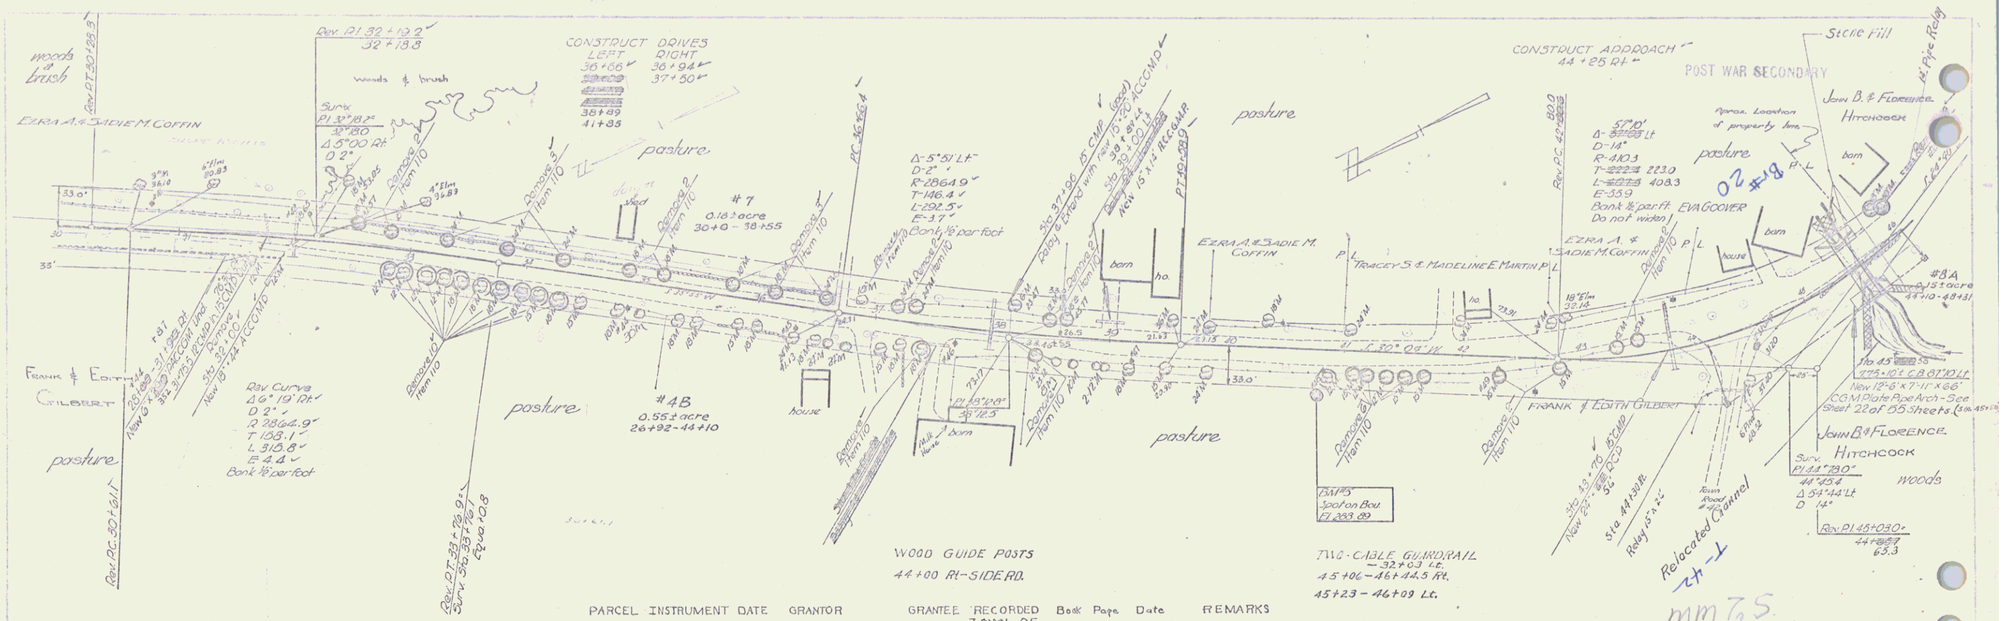

PARCEL	INSTRUMENT	DATE	GRANTOR	GRANTEE	RECORDED TOWN OF	Book	Page	Date	REMARKS
8A,B	W.D.O.E.	11-6-53	FLORENCE B. HITCHCOCK	ST. OF VT.	CAMBRIDGE	42	336-337	11-12-53	See also Sheet 17