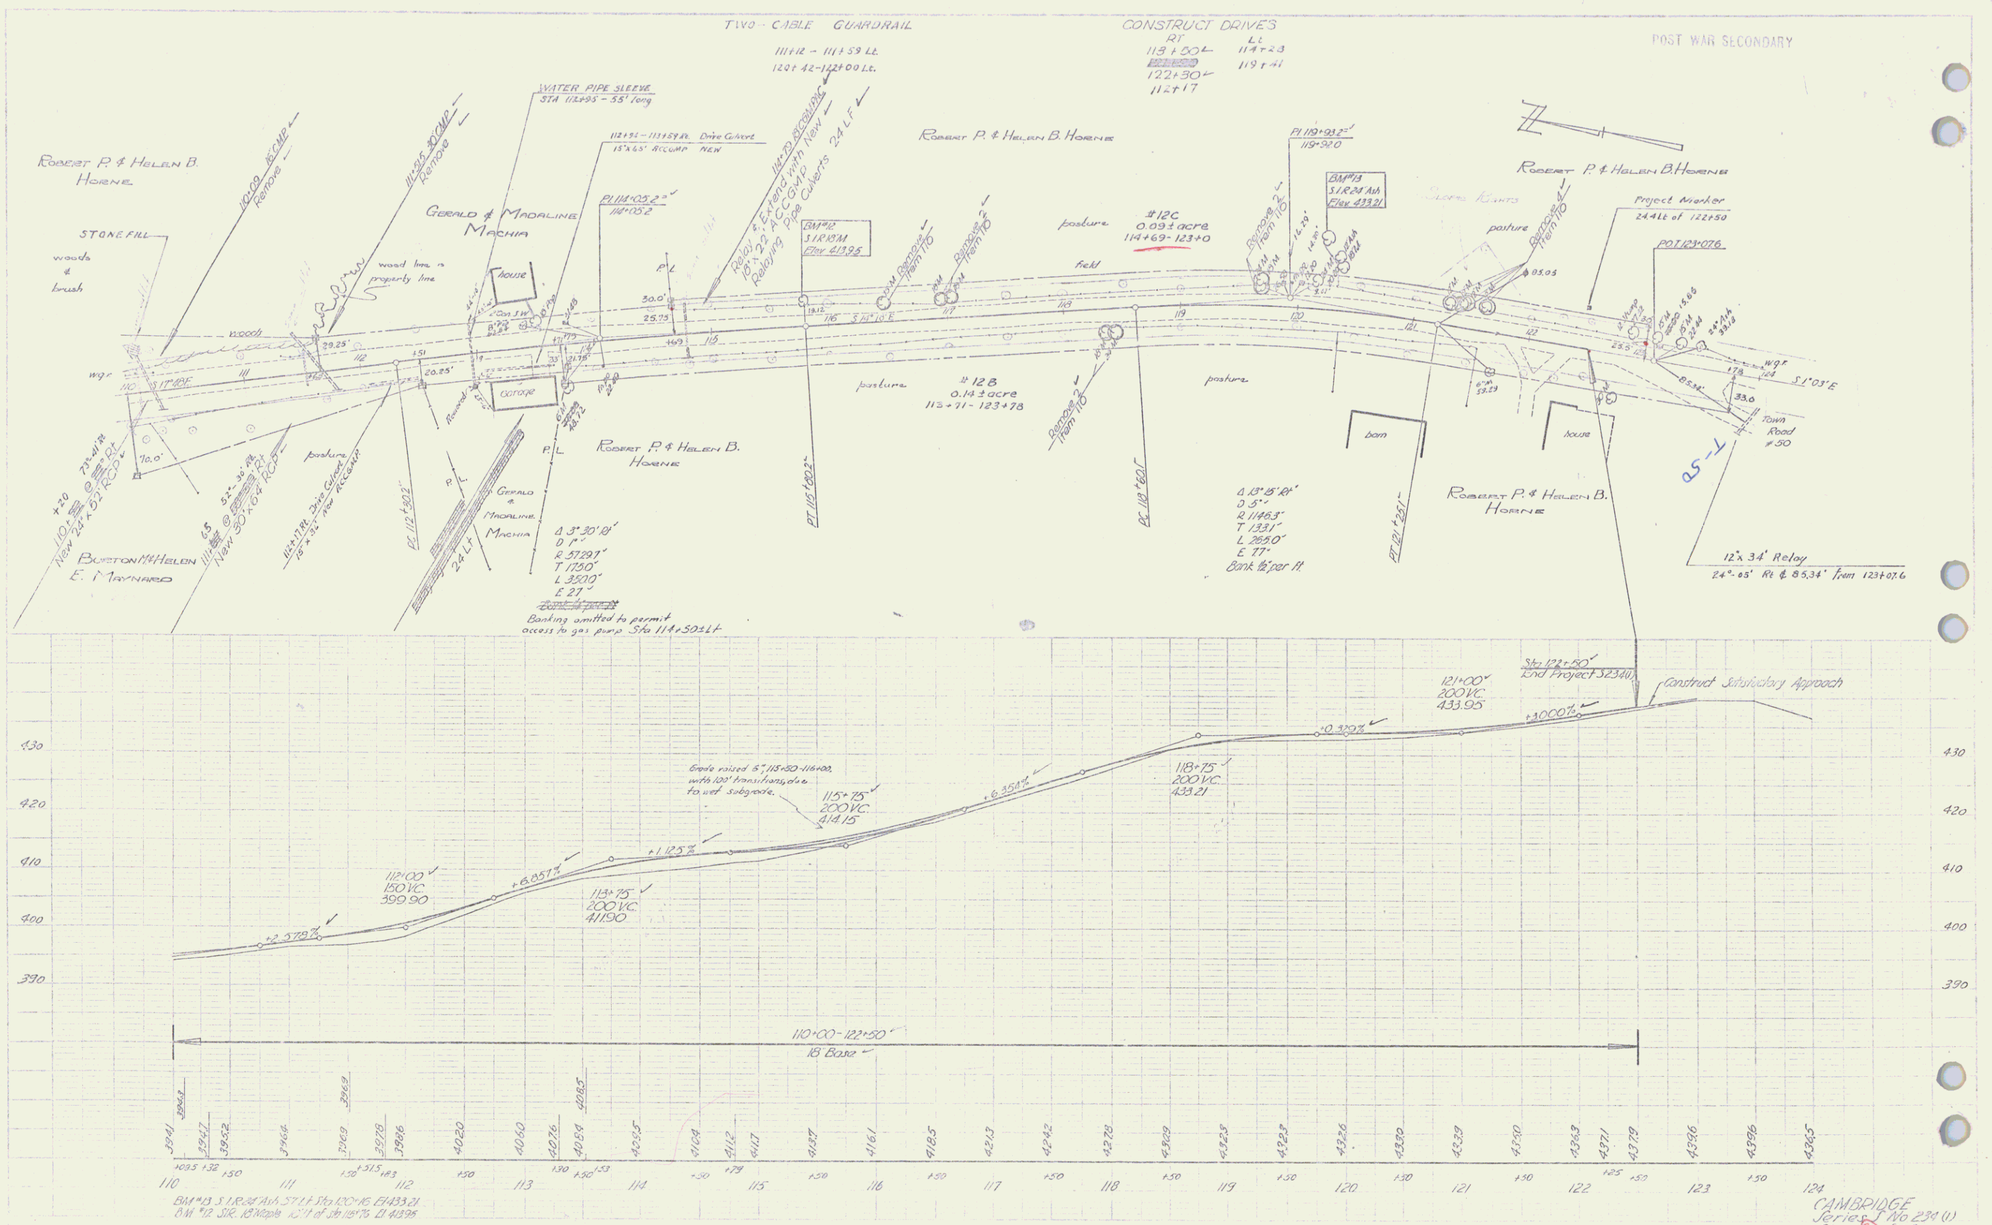
TWO - CABLE GUARDRAIL
111+12 - 111+59 Lt.
120+42-122+00 Lt.
CONSTRUCT DRIVES
Rt
113+00
122+30
112+17
Lt
114+23
119+41
POST WAR SECONDARY
WATER PIPE SLEEVE
STA 112+95 - 55' long
Robert P. & Helen B. Horne
Gerald & Madaline Machia
STONE FILL
woods & brush
wood line is property line
House
Garage
pasture
field
#12C
0.09 ± acre
114+69 - 123+0
#12B
0.14 ± acre
113+91 - 123+78
Banking omitted to permit access to gas pump Sta 114+50±Lt
Burton M. & Helen E. Maynard
Robert P. & Helen B. Horne
barn
house
Project Marker
24.4 Lt of 122+50
POT 123+076
Town Road #50
12" x 34' Relay
24°-05' Rt & 85.34' from 123+07.6
Construct Secondary Approach
Grade raised 5" 115+50-116+00, with 100' transitions, due to wet subgrade.
112+00 150 VC 399.90
113+75 200 VC 411.90
115+75 200 VC 414.15
118+75 200 VC 433.21
121+00 200 VC 433.95
110+00-122+50
18' Base
CAMBRIDGE
Series J No 234 (1)
Sheet 10 of 35 Sheets
10