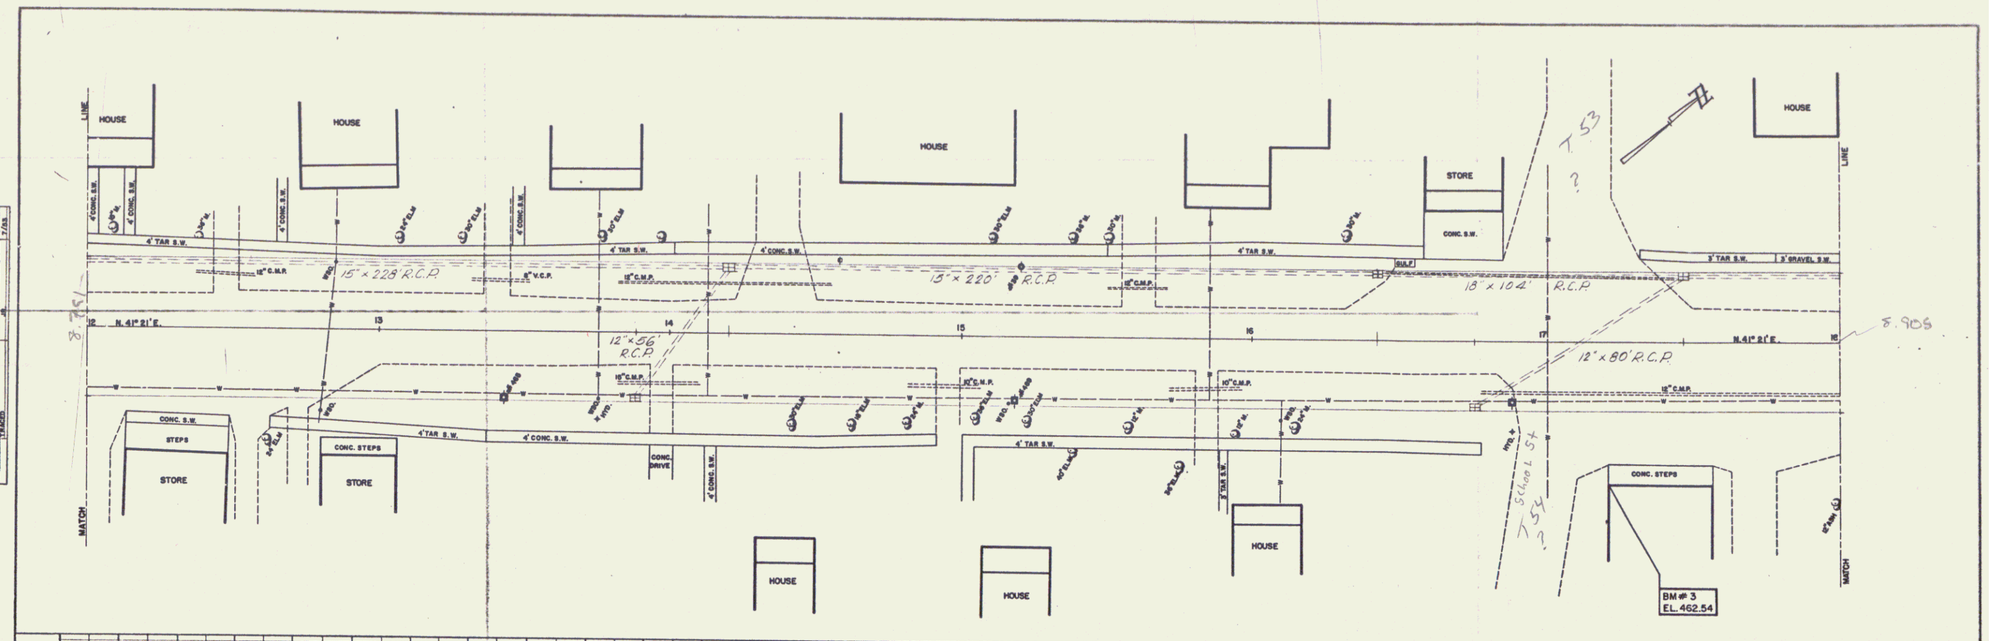

PLAN
SURVEYED
PLOTTED
NOTE BOOK
NO.
BY
DATE
CHECKED
CHECKED
TRACED
SMALLWOOD
JR.
JR.
8/61
7/62
7/62

PROFILE
SURVEYED
PLOTTED
CHECKED
CHECKED
NOTE BOOK
NO.
BY
DATE
SMALLWOOD
JR.
JR.
8/61
7/62
7/62
STRUCTURE NOTE NO. OF TO.

PLATE 1 - PLAN-PROFILE OF N.Y. & K.E. STANDARD
KEUFFEL & ESSER CO., NEW YORK
K & E Co. No. 34-8-10

5