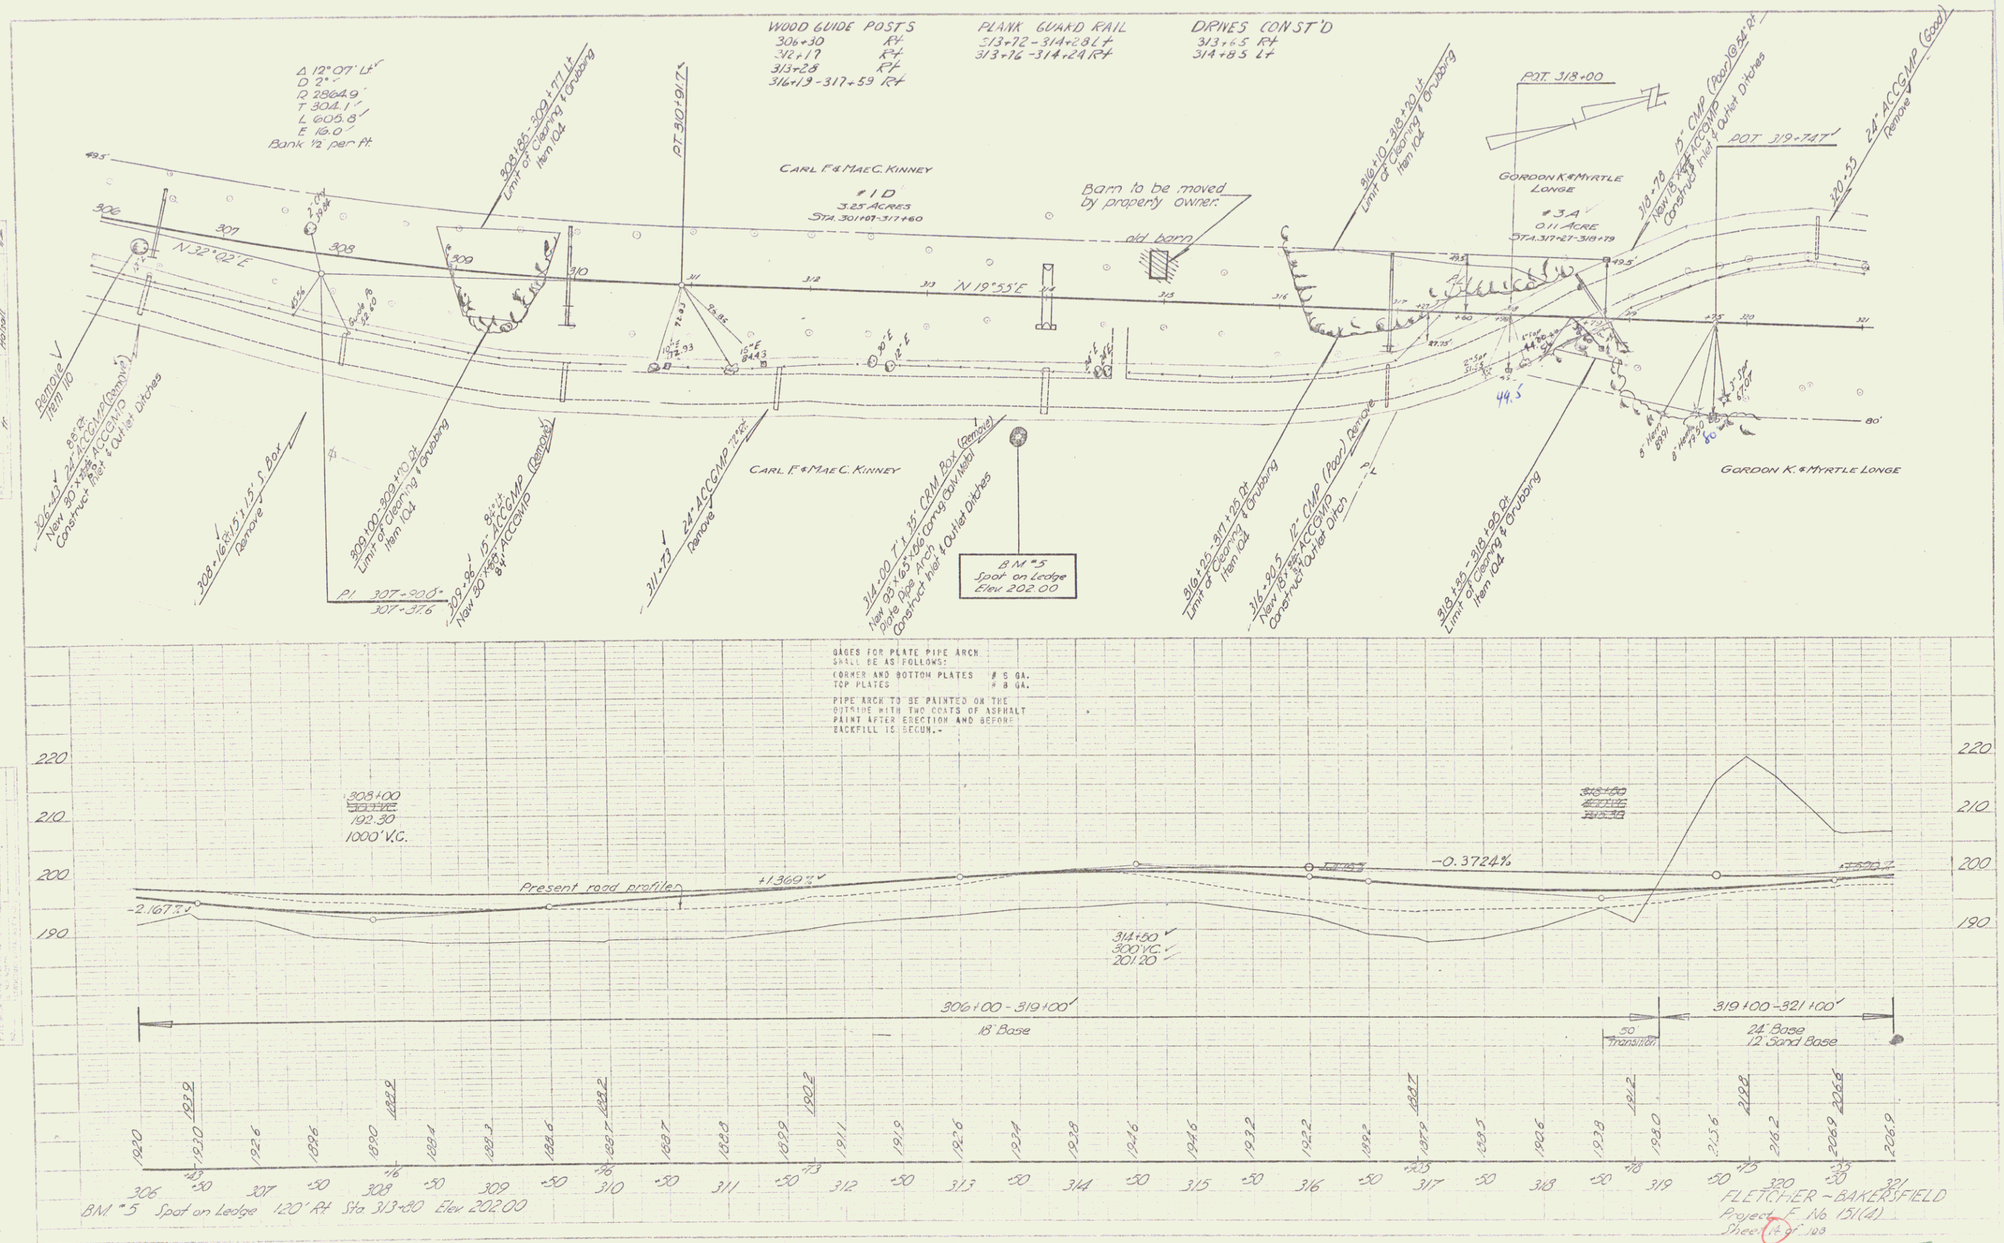
WOOD GUIDE POSTS
306+30 Rt
312+17 Rt
313+28 Rt
316+19 - 317+59 Rt
PLANK GUARD RAIL
313+72 - 314+28 Lt
313+76 - 314+24 Rt
DRIVES CONST'D
313+65 Rt
314+85 Lt
Δ 12°07' Lt
D 2°
R 2864.9'
T 304.1'
L 606.8'
E 19.0'
Bank 1/2 per ft.
CARL F. & MAE C. KINNEY
#1D
3.25 ACRES
STA. 301+87-317+60
Barn to be moved by property owner.
old barn
GORDON K. & MYRTLE LONGE
#3A
0.11 ACRE
STA. 317+27-318+79
P.O.T. 318+00
P.O.T. 319+74.7'
N 32°02' E
N 19°55' E
P.T. 310+91.7'
P.I. 307+90.5'
307+37.6
B.M. #5
Spot on Ledge
Elev. 202.00
Remove Item 110
306+41 New 90"x45" ACCGMP (Corrugated) Construct Inlet & Outlet Ditches
308+16 x 15' x 15' S Box Remove
308+85 - 309+77 Lt Limit of Clearing & Grubbing Item 104
309+00 - 309+10 Rt Limit of Clearing & Grubbing Item 104
309+96 15" x 8" Lt New 90" x 45" ACCGMP (Corrugated) 8'
311+73 24" ACCGMP 12'+2" Remove
314+00 7' x 35' CRM Box (Corrugated) New 93" x 65" x 106' Corrugated Metal Plate Pipe Arch Construct Inlet & Outlet Ditches
316+10 - 318+10 Lt Limit of Clearing & Grubbing Item 104
318+20 - 317+20 Rt Limit of Clearing & Grubbing Item 104
316+92.5 12" CMP (Poor) Remove New 15" x 32" ACCGMP Construct Inlet & Outlet Ditch
318+35 - 318+20 Rt Limit of Clearing & Grubbing Item 104
318+79 15" CMP (Poor) New 18" x 32" ACCGMP Construct Inlet & Outlet Ditches
319+53 24" ACCGMP (Good) Remove
GAGES FOR PLATE PIPE ARCH SHALL BE AS FOLLOWS:
CORNER AND BOTTOM PLATES # 5 GA.
TOP PLATES # 8 GA.
PIPE ARCH TO BE PAINTED ON THE OUTSIDE WITH TWO COATS OF ASPHALT PAINT AFTER ERECTION AND BEFORE BACKFILL IS BEGUN.-
308+00
192.30
1000' V.C.
Present road profile
-2.167%
+1.369%
-0.3724%
314+60
300' V.C.
201.20
306+00 - 319+00'
18' Base
50 Transition
319+00 - 321+00'
24' Base
12' Sand Base
BM #5 Spot on Ledge 120' Rt Sta 313+80 Elev 202.00
FLETCHER - BAKERSFIELD
Project F. No. 151(4)
Sheet 18 of 103
5