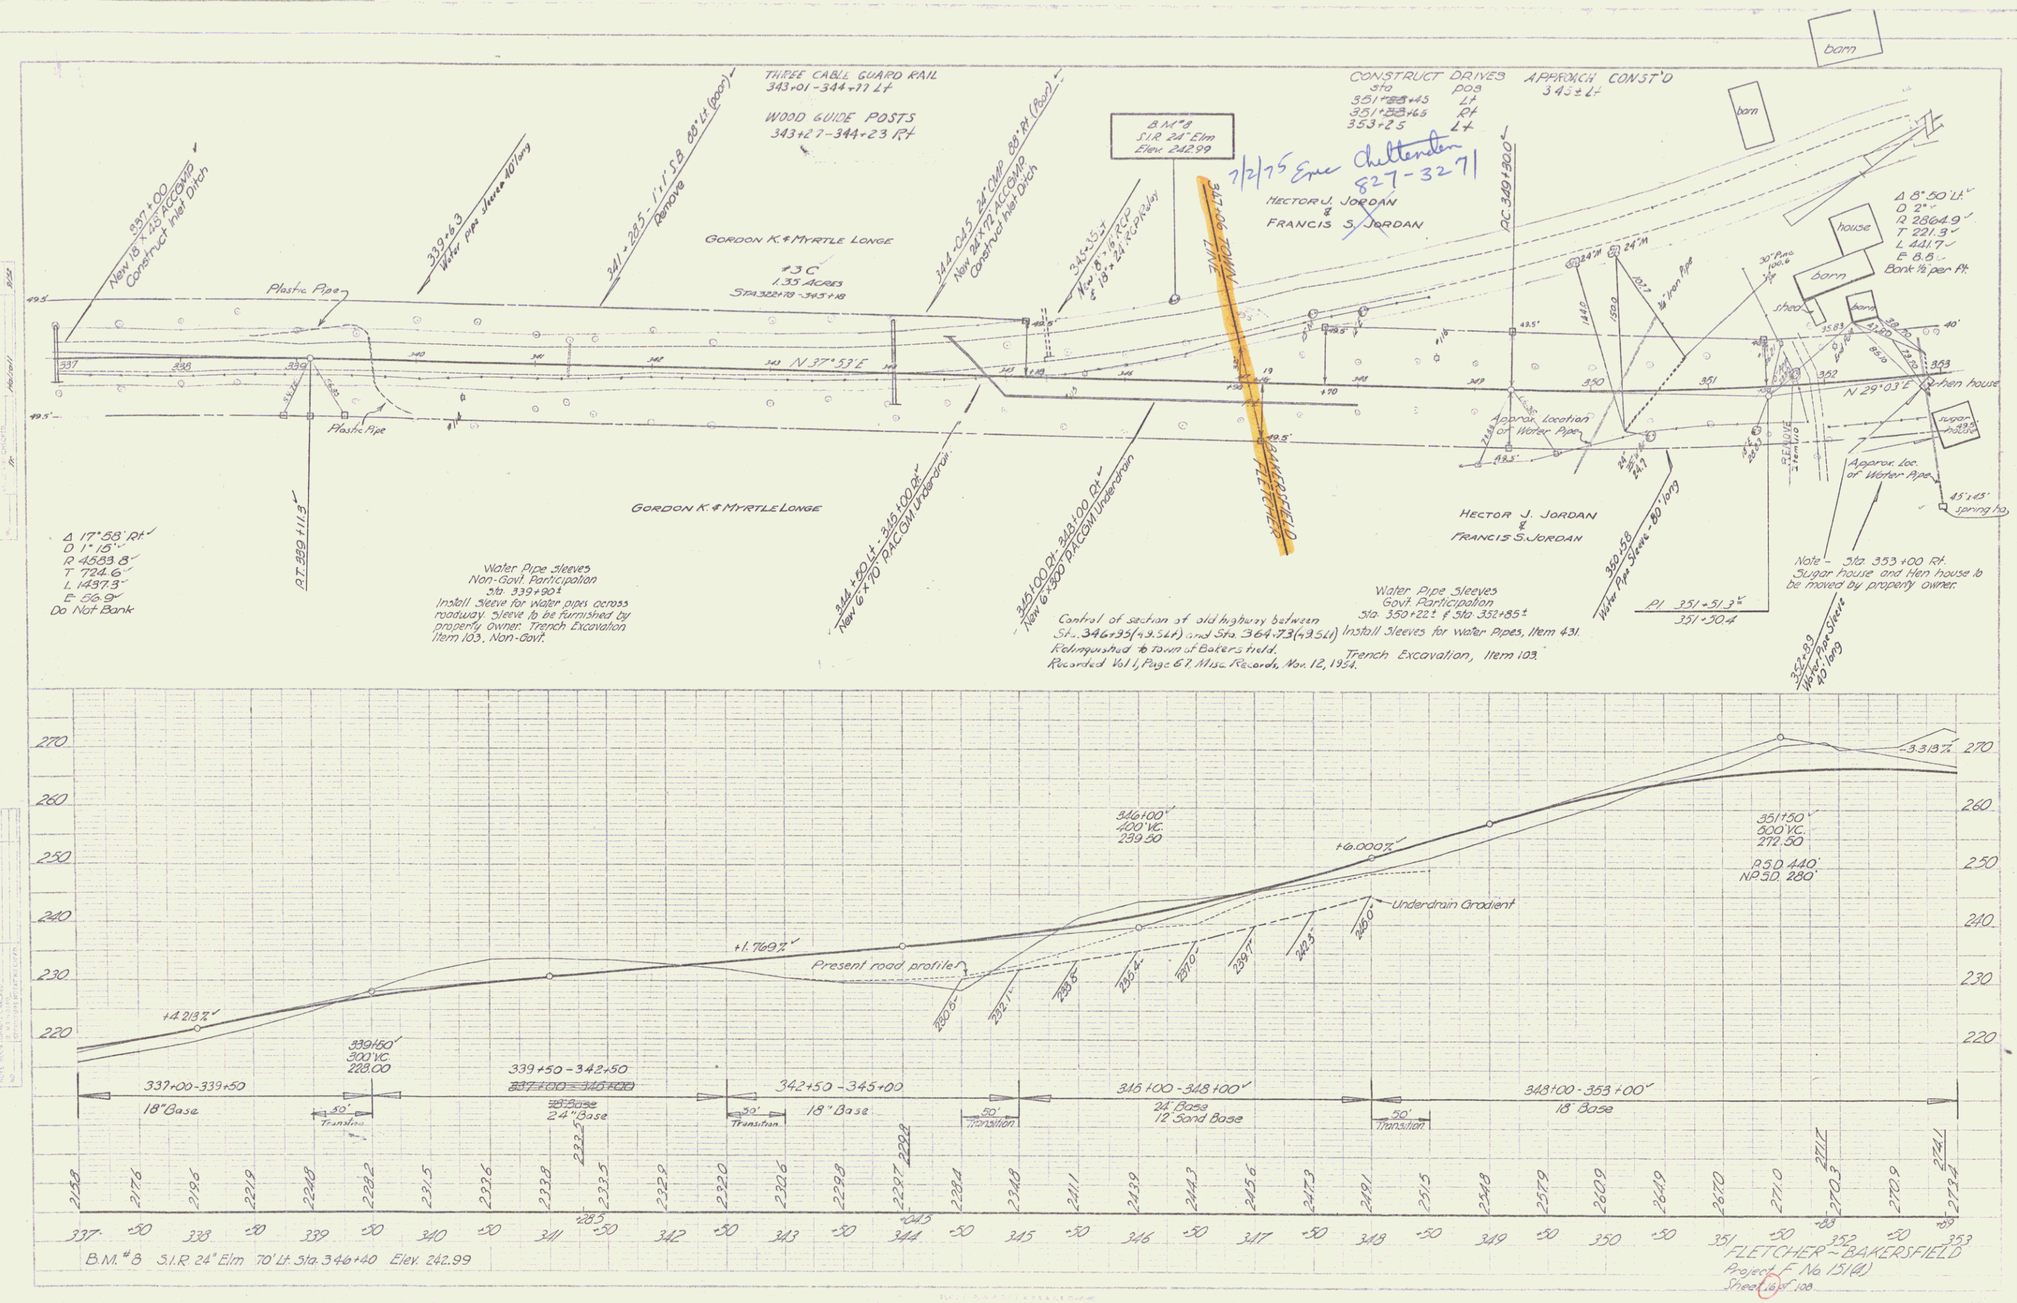
THREE CABLE GUARD RAIL
343+01 - 344+77 Lt
WOOD GUIDE POSTS
343+27 - 344+23 Rt
CONSTRUCT DRIVES APPROACH CONST'D
Sta Side
351+45 Lt
351+45 Rt
353+25 Lt
343 ± Lt
B.M. #8
S.I.R. 24" Elm
Elev. 242.99
7/2/75 Ernie Cheltenden 827-3271
HECTOR J. JORDAN & FRANCIS S. JORDAN
GORDON K. & MYRTLE LONGE
13C
1.35 ACRES
Sta 322+79 - 343+18
N 37°53'E
N 29°03'E
Plastic Pipe
Approx. Location of Water Pipe
Δ 17°58' Rt
D 1°18'
R 4583.8
T 724.6
L 1437.3
E 56.9
Do Not Bank
Δ 8°50' Lt
D 2°
R 2864.9
T 221.9
L 441.7
E 8.8
Bank ½ per ft.
Water Pipe Sleeves
Non-Govt. Participation
Sta. 339+90±
Install Sleeve for water pipes across roadway. Sleeve to be furnished by property owner. Trench Excavation Item 103, Non-Govt.
Control of section of old highway between Sta. 346+35(49.5Lt) and Sta. 364+73(49.5Lt) Relinquished to Town of Bakersfield. Recorded Vol 1, Page 67, Misc. Records, Nov. 12, 1954.
Water Pipe Sleeves
Govt. Participation
Sta. 350+22± & Sta. 352+85±
Install Sleeves for Water Pipes, Item 431.
Trench Excavation, Item 103.
Note - Sta. 353+00 Rt. Sugar house and Hen house to be moved by property owner.
Approx. loc. of Water Pipe
Spring ho.
Sugar house
Hen house
barn
house
shed
Underdrain Gradient
Present road profile
+4.213%
+1.769%
+6.000%
-3.318%
339+50 300' VC 228.00
346+00 400' VC 239.50
351+50 500' VC 272.50
P.S.D. 440'
N.P.S.D. 280'
337+00-339+50 18" Base
339+50 - 342+50 24" Base
342+50 - 345+00 18" Base
345+00 - 348+00 24" Base 12" Sand Base
348+00 - 353+00 18" Base
50' Transition
B.M. #8 S.I.R. 24" Elm 70' Lt. Sta. 346+40 Elev. 242.99
FLETCHER - BAKERSFIELD
Project F No. 151(4)
Sheet 6 of 100

7