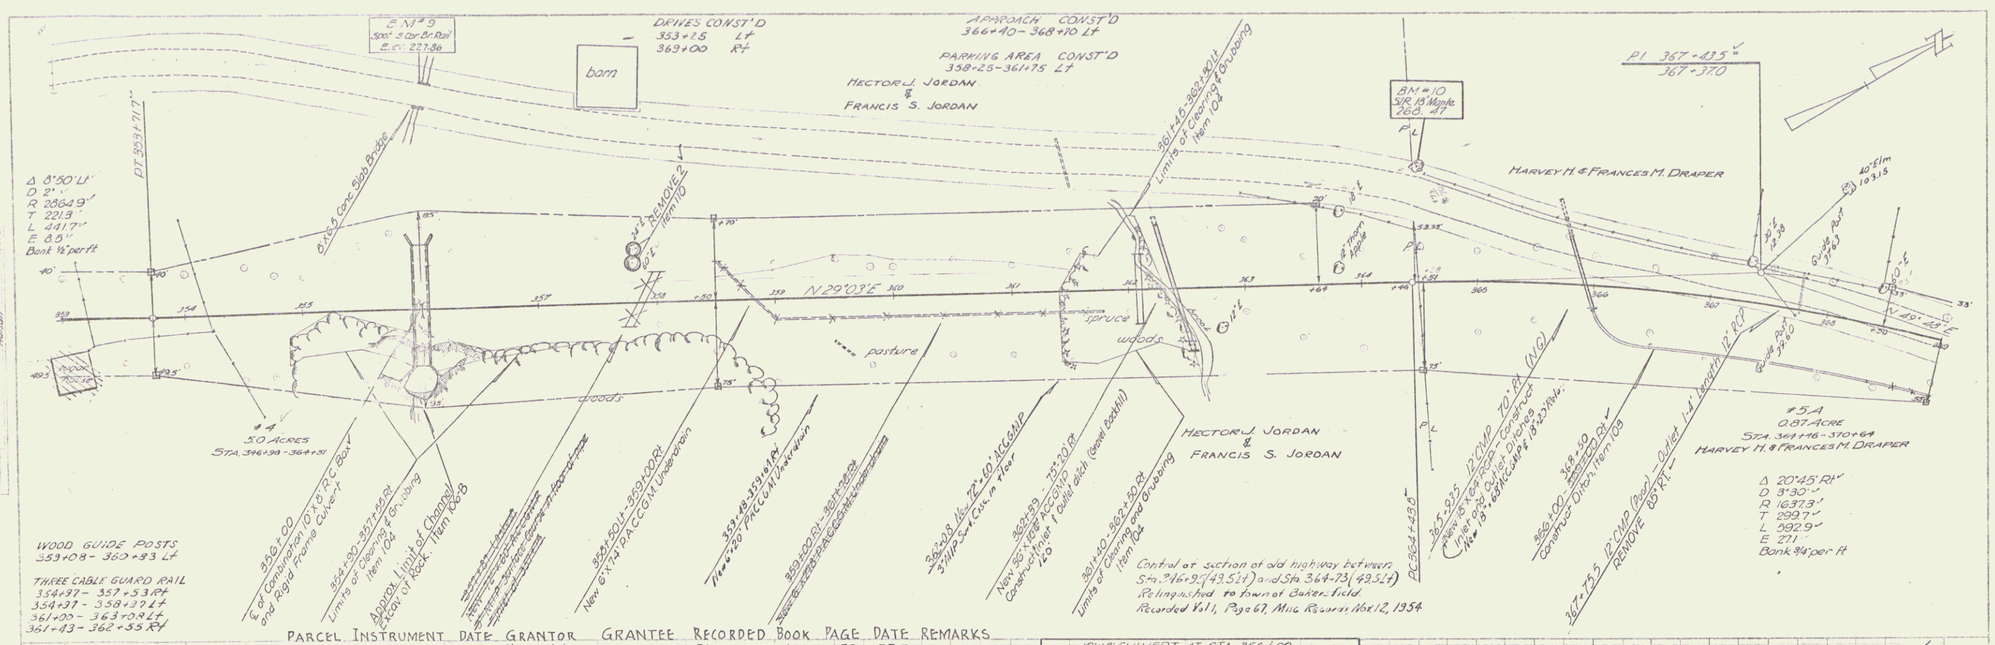

10'x8' CULVERT AT STA 356+00
(List of Culvert Sheets only)

Sheet 29 of 106		Layout of 10'x8' Combination R.C. Box and Rigid Frame Culvert
" 30	" 106	Construction Details - Rigid Frame Section
" 31	" 106	Construction Details - Box Section
" 32	" 106	Reinforcing Steel Schedule
" 33	" 106	Channel Sections
" 34	" 106	Standard Structure Sheet SB-20 Details C, D & E

ESTIMATED QUANTITIES (CULVERT ONLY)

ITEM NO.	ITEM	QUANT.	UNIT
106-A	Channel Excavation of Earth	25	CY
106-B	Channel Excavation of Rock	125	CY
107	Structure Excavation (Mod.)	160	CY
222	Gravel Backfill	50	CY
401-B	Concrete, Class B (Mod.)	250	CY
402	Reinforcing Steel	31200	LBS
526	Riprap for Bank Protection	30	CY

8