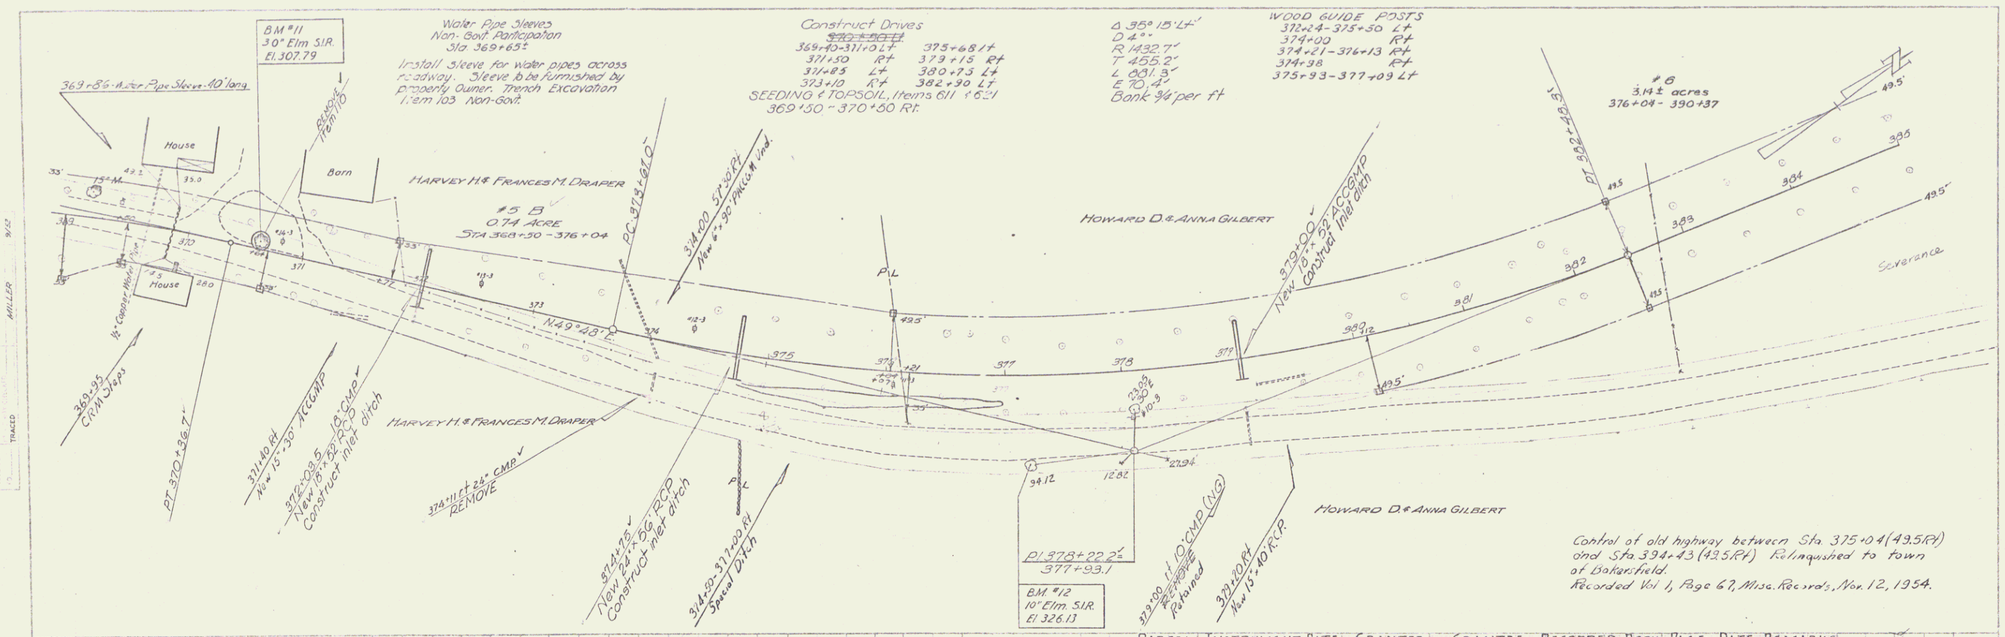

PARCEL	INSTRUMENT	DATE	GRANTOR	GRANTEE	RECORDED BOOK	PAGE	DATE	REMARKS
#5 A & B	W.D.O.E	6-24-53	HARVEY H. & FRANCES M. DRAPER	ST. of VT.	BAKERSFIELD	1	51	7-7-53
#6	CONDEMNATION	5-29-53	HOWARD D. & ANNA GILBERT	ST. of VT.	"	1	39-40	5-29-53

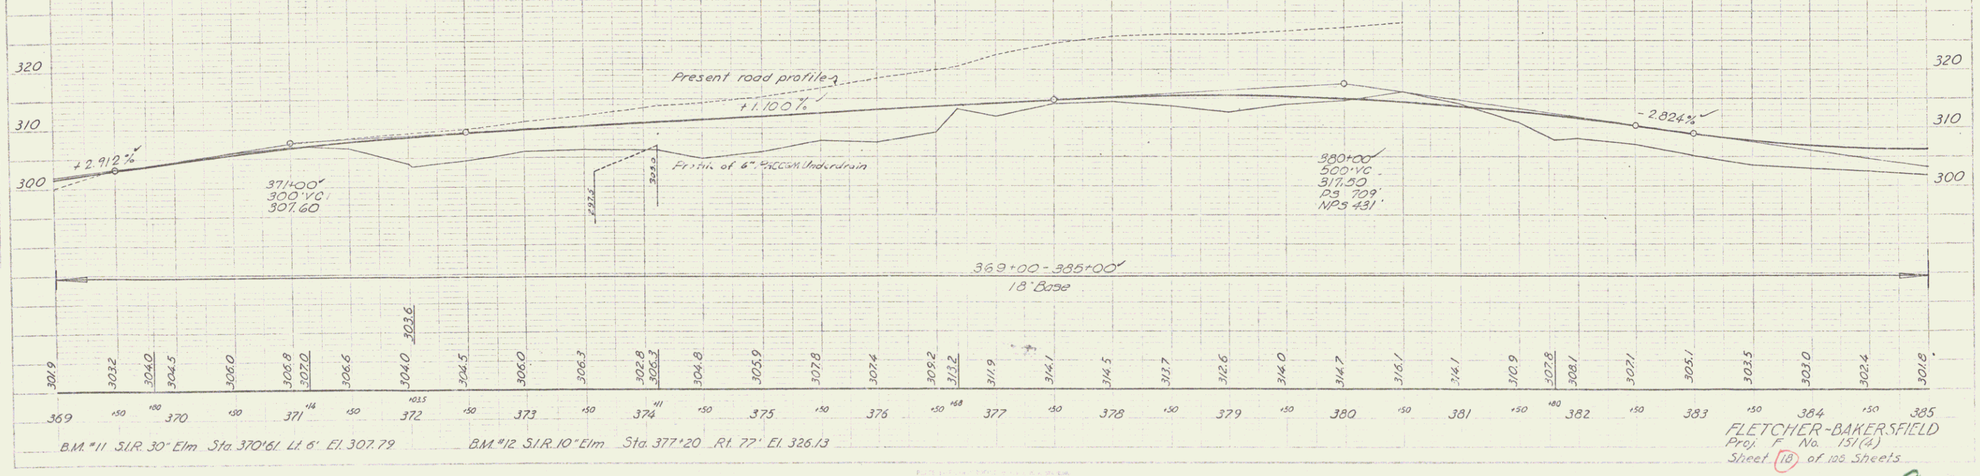

FLETCHER-BAKERSFIELD
Proj. F No. 151(4)
Sheet 18 of 108 Sheets

9