| PARCEL | INSTRUMENT | DATE | GRANTOR | GRANTEE | RECORDED BAKERSFIELD BOOK | PAGE | DATE | REMARKS |
|---|---|---|---|---|---|---|---|---|
| B.C. | W.D. O.E. | 6-14-62 | IVAN & RUTH STONE | ST. OF VT. | 25 | 26-27 | 6-29-62 | 1 NEW CULV. |

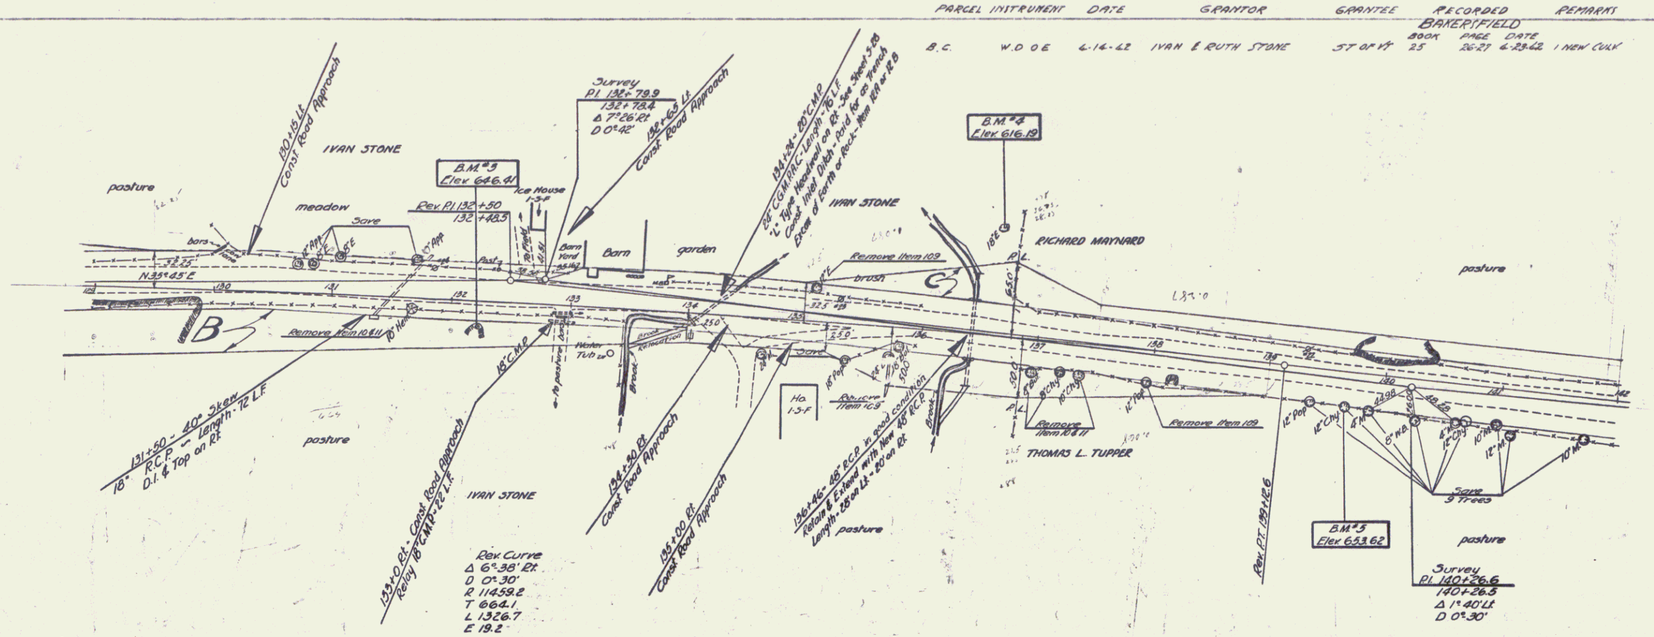


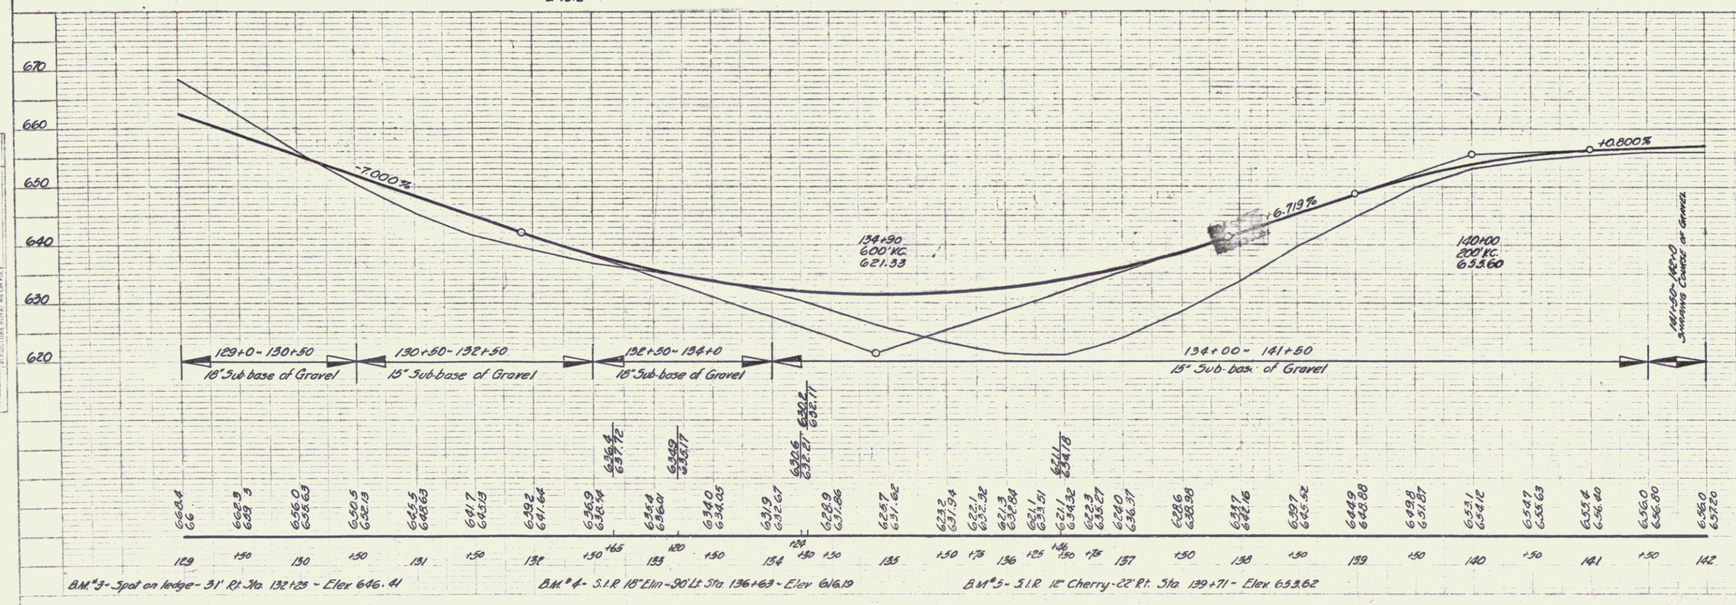


B.M. #3 - Spot on ledge - 31' Rt. Sta. 132+25 - Elev. 646.41

B.M. #4 - S.I.R. 18" Elm - 90' Lt. Sta. 136+63 - Elev. 616.19

B.M. #5 - S.I.R. 12" Cherry - 22' Rt. Sta. 139+71 - Elev. 653.62

BAKERSFIELD
SERIES - STATE No. 151-M
SHEET 2 OF

2