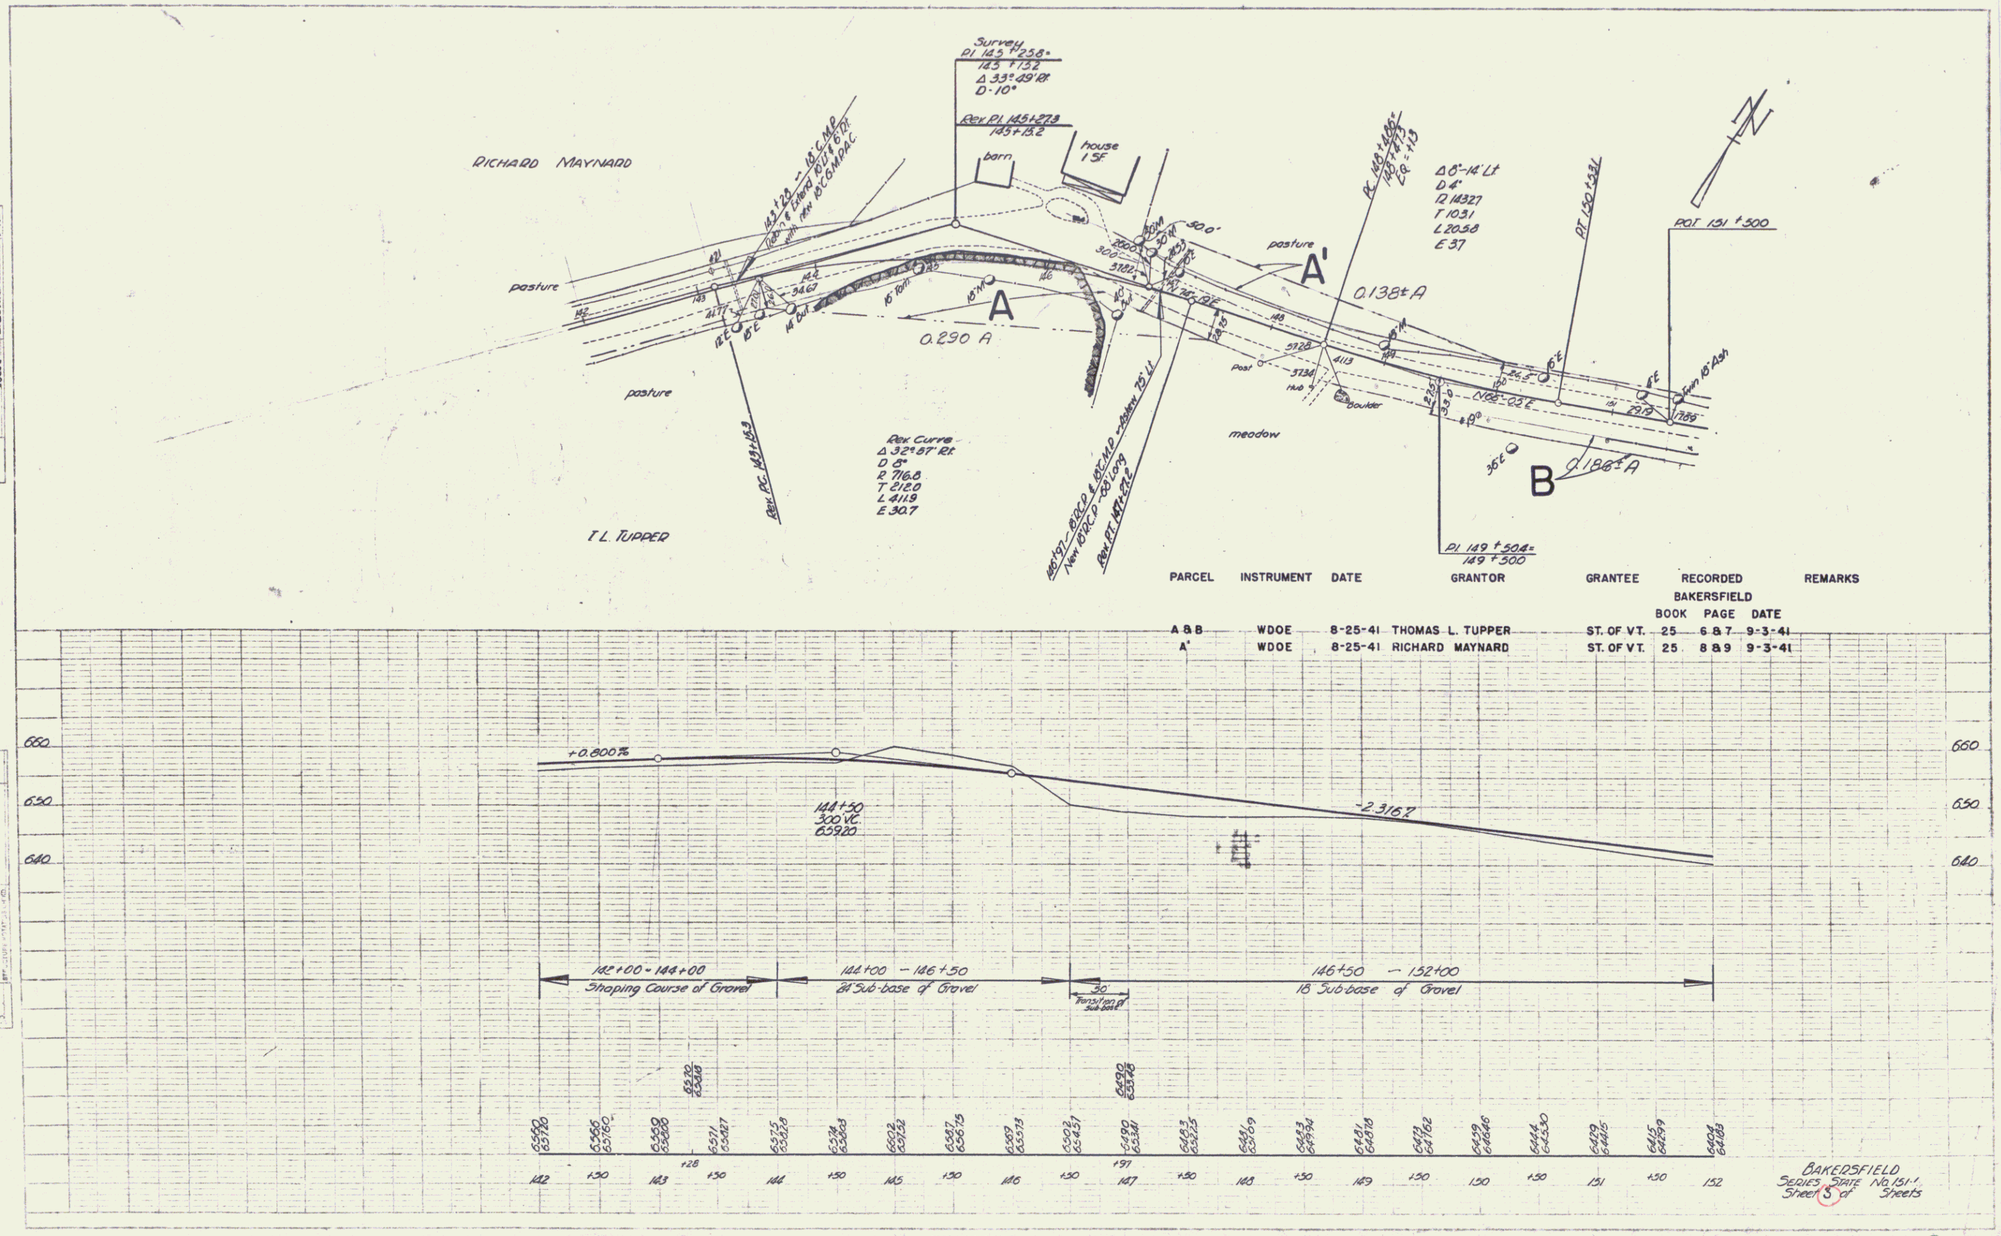

PARCEL	INSTRUMENT	DATE	GRANTOR	GRANTEE	RECORDED BAKERSFIELD BOOK	PAGE	DATE	REMARKS
A & B	WDOE	8-25-41	THOMAS L. TUPPER	ST. OF VT.	25	6 & 7	9-3-41	
A'	WDOE	8-25-41	RICHARD MAYNARD	ST. OF VT.	25	8 & 9	9-3-41	

BAKERSFIELD
SERIES STATE No. 151-1
Sheet 3 of Sheets

3