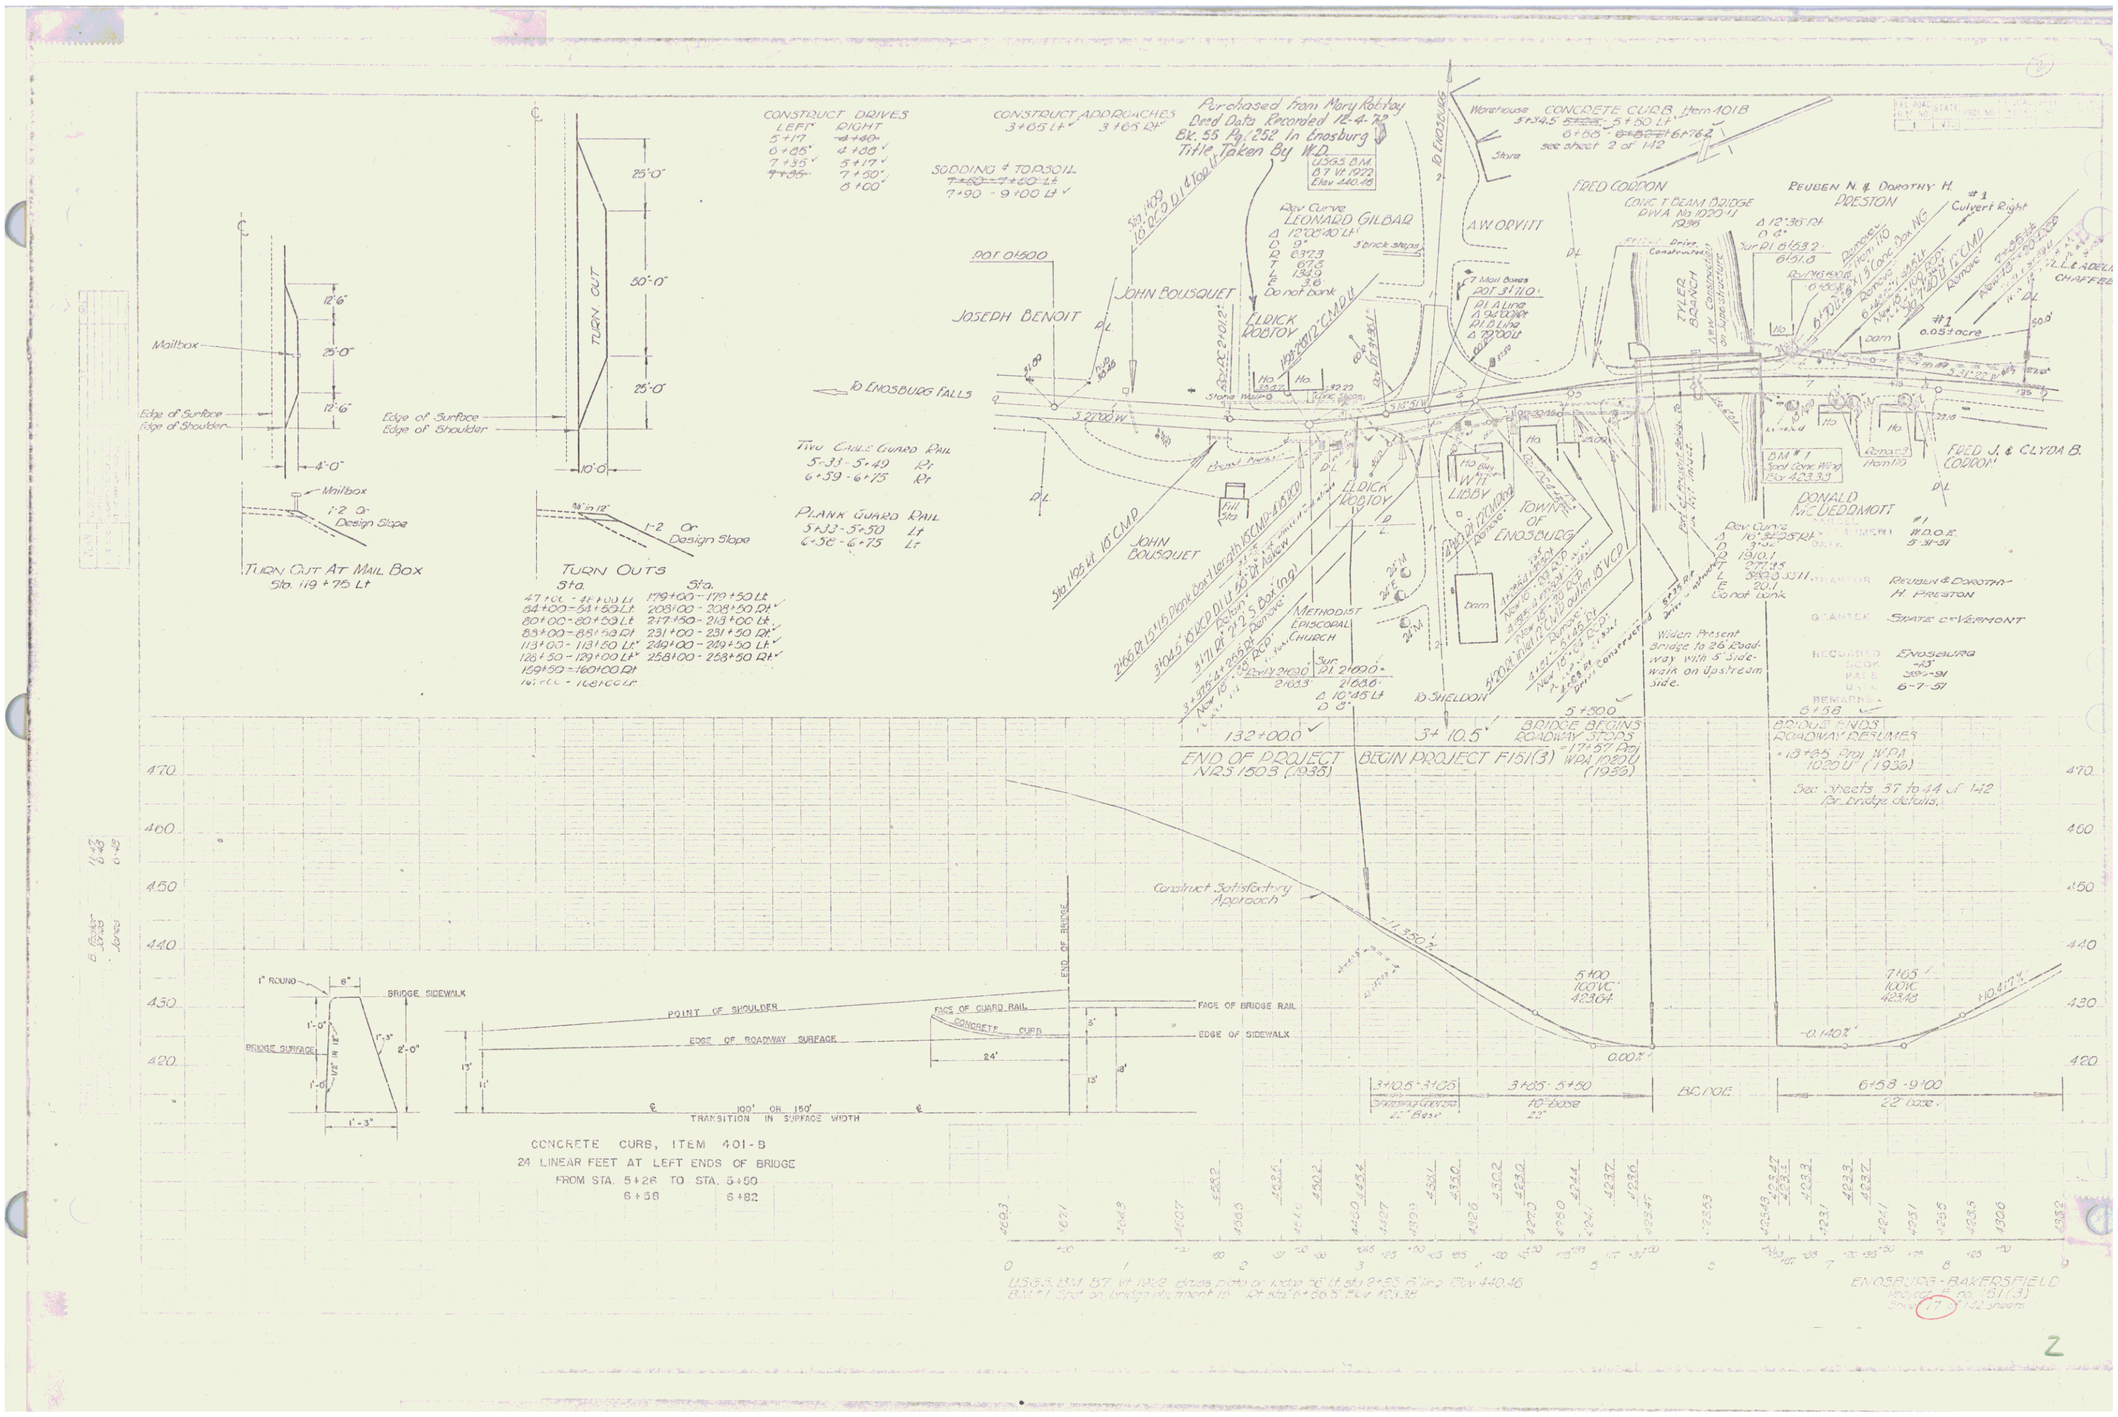
TURN OUT AT MAIL BOX
Sta. 119 + 75 Lt
TURN OUTS
CONSTRUCT DRIVES
LEFT RIGHT
CONSTRUCT APPROACHES
SODDING & TOPSOIL
Purchased from Mary Robtoy
Deed Data Recorded 12-4-79
Bk. 55 Pg. 252 in Enosburg
Title Taken By W.D.
LEONARD GILBAR
JOHN BOUSQUET
JOSEPH BENOIT
ELDICK VOBTOY
A.W. ORVITT
FRED COBDON
REUBEN N. & DOROTHY H. PRESTON
TYLER BRANCH
WM. LIBBY
TOWN OF ENOSBURG
METHODIST EPISCOPAL CHURCH
DONALD McCUEDDMOTT
FRED J. & CLYDA B. COBDON
TO ENOSBURG FALLS
TO ENOSBURG
TO SHELDON
Two Cable Guard Rail
Plank Guard Rail
Widen Present Bridge to 26 Roadway with 5' Sidewalk on Upstream Side.
Reuben & Dorothy H. Preston
State of Vermont
Enosburg
END OF PROJECT N25 1503 (1938)
BEGIN PROJECT F151(3)
BRIDGE BEGINS ROADWAY ENDS
BRIDGE ENDS ROADWAY RESUMES
Construct Satisfactory Approach
BRIDGE
CONCRETE CURB, ITEM 401-B
24 LINEAR FEET AT LEFT ENDS OF BRIDGE
FROM STA. 5+26 TO STA. 5+50
6+58 6+82
POINT OF SHOULDER
EDGE OF ROADWAY SURFACE
FACE OF GUARD RAIL
FACE OF BRIDGE RAIL
EDGE OF SIDEWALK
BRIDGE SIDEWALK
BRIDGE SURFACE
TRANSITION IN SURFACE WIDTH
ENOSBURG - BAKERSFIELD