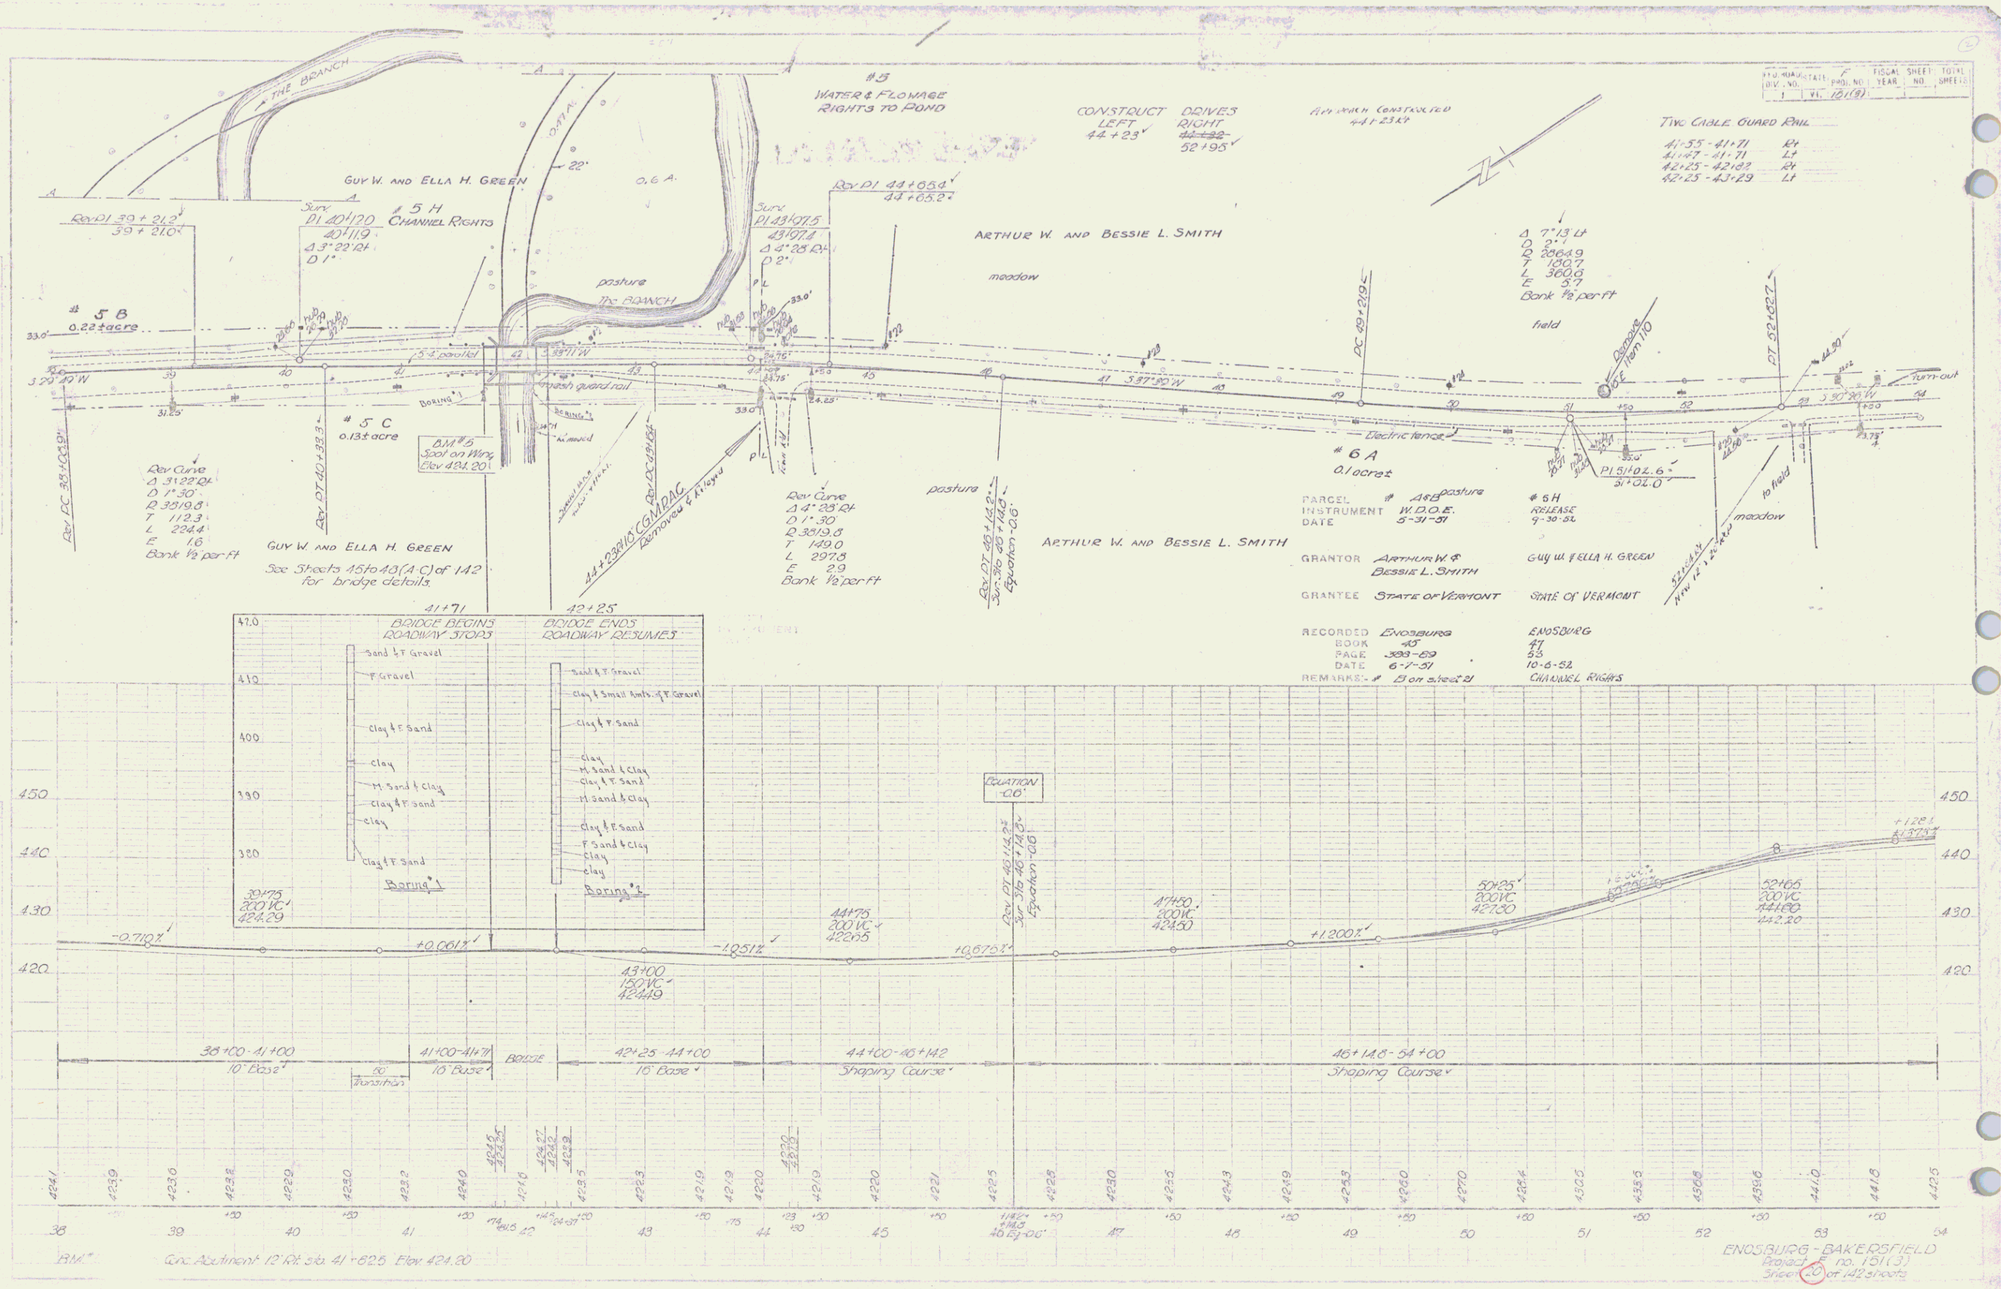
THE BRANCH
GUY W. AND ELLA H. GREEN
#5 WATER & FLOWAGE RIGHTS TO POND
CONSTRUCT LEFT 44+23 RIGHT 52+95
AN OFFSETTING CONSTRUCTED 44+23 Rt
TWO CABLE GUARD RAIL
41+55 - 41+71 Rt
41+67 - 41+71 Lt
42+25 - 42+82 Rt
42+25 - 43+29 Lt
Rev PI 39+21.2 / 39+21.0
Surv PI 40+17.0 / 40+11.9
Δ 3°22' Rt
D 1°
5 H CHANNEL RIGHTS
Surv PI 43+07.5 / 43+07.4
Δ 4°28 Rt
D 2°
Rev PI 44+05.8 / 44+05.2
ARTHUR W. AND BESSIE L. SMITH
meadow
pasture
field
Δ 7°13' Lt
D 2°
R 2864.9
T 180.7
L 360.0
E 5.7
Bank 1½ per ft
5 B
0.22± acre
5± parallel
Boring #1
Boring #2
trash guard rail
BM #5 Spot on Way Elev 424.201
5 C
0.13± acre
Rev Curve
Δ 31°22' Rt
D 1°30'
R 3819.8
T 1123
L 2244
E 16
Bank 1½ per ft
Rev PC 38+42.29
Rev PT 40+93.3
GUY W. AND ELLA H. GREEN
See Sheets 45 to 48 (A-C) of 142 for bridge details.
44+23 RIGHT COMPAC Removed & replaced
Rev Curve
Δ 4°28 Rt
D 1°30'
R 3819.8
T 149.0
L 297.8
E 2.9
Bank 1½ per ft
Rev PT 48+14.2 / Sur 46+05 / Equation -0.6
ARTHUR W. AND BESSIE L. SMITH
Rev PC 49+29.6
Rev PT 52+82.7
Remove Item 110
Electric fence
6 A
0.10 acre±
PI 51+02.6 / 51+02.0
Tell-tale
to field
meadow
PARCEL # 4 & 8 pasture # 6 H
INSTRUMENT W.D.O.E. RELEASE
DATE 5-31-51 9-30-52
GRANTOR ARTHUR W. & BESSIE L. SMITH GUY W. & ELLA H. GREEN
GRANTEE STATE OF VERMONT STATE OF VERMONT
RECORDED ENOSBURG ENOSBURG
BOOK 45 47
PAGE 383-89 53
DATE 6-1-51 10-6-52
REMARKS - # 8 on sheet 21 CHANNEL RIGHTS
41+71
42+25
BRIDGE BEGINS ROADWAY STOPS
BRIDGE ENDS ROADWAY RESUMES
Sand & F Gravel
F Gravel
Clay & F Sand
Clay
M Sand & Clay
Clay & F Sand
Clay
Clay & F Sand
Boring #1
Sand & F Gravel
Clay & Small Amts. of F Gravel
Clay & F Sand
Clay
M Sand & Clay
Clay & F Sand
M Sand & Clay
Clay & F Sand
F Sand & Clay
Clay
Clay
Boring #2
38+75 200 VC 424.29
-0.710%
+0.061%
-1.051%
43+00 150 VC 424.49
44+75 200 VC 422.05
EQUATION -0.6'
Rev PT 48+14.2 / Sur 46+05 / Equation -0.6
+0.675%
47+50 200 VC 424.50
+1.200%
50+25 200 VC 427.30
52+66 200 VC 429.80 442.20
+1.28%
38+00 - 41+00 10' Base
50' Transition
41+00 - 41+71 10' Base
BRIDGE
42+25 - 44+00 16' Base
44+00 - 46+14.2 Shaping Course
46+14.8 - 54+00 Shaping Course
BM# Conc. Abutment 12' Rt. Sta. 41+62.5 Elev. 424.20
ENOSBURG - BAKERSFIELD
Project F no. 151(3)
Sheet 20 of 142 sheets

6