F.A.D. ROAD D.M. NO.	STATE	PROJ. NO.	FISCAL YEAR	SHEET NO.	TOTAL SHEETS
1	VT.	181(3)			

CONSTRUCT DRIVES
LEFT 118 + 20, 117 + 50, 123 + 00, 124 + 00, 124 + 50, 124 + 75, 125 + 00, 118 + 00, 120 + 00
RIGHT 125+05

CONSTRUCT APPROACH 119 + 50 Rt

CLEARING AND GRUBBING 119+52 - 120 + 64 LT

TWO CABLE GUARD RAIL
119+95 120+50 Rt
119+95 120+79 Lt

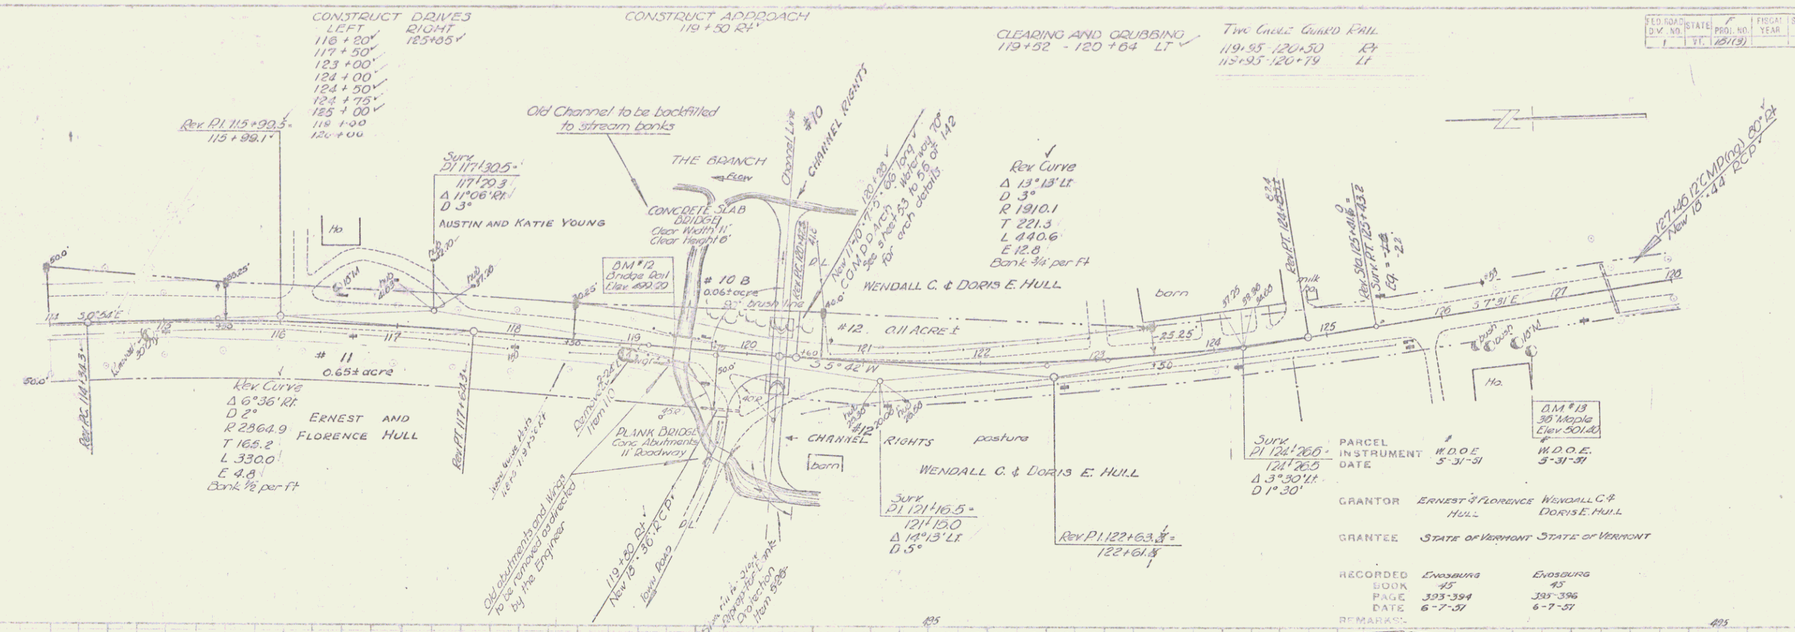

PARCEL		
INSTRUMENT	W.D.O.E.	W.D.O.E.
DATE	5-31-51	5-31-51
GRANTOR	ERNEST & FLORENCE HULL	WENDALL C. & DORIS E. HULL
GRANTEE	STATE OF VERMONT	STATE OF VERMONT
RECORDED BOOK	ENOSBURG 45	ENOSBURG 45
PAGE	393-394	395-396
DATE	6-7-51	6-7-51
REMARKS		

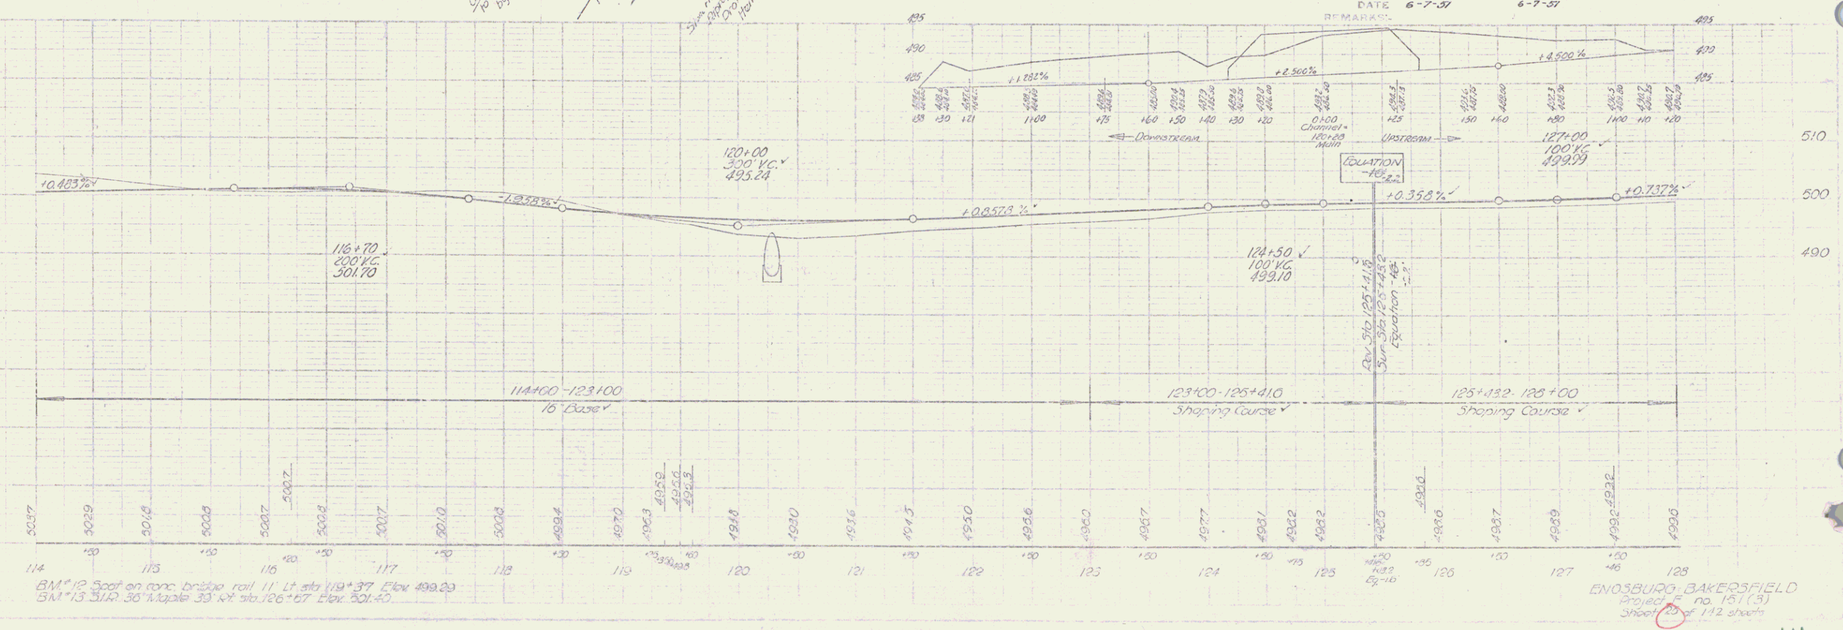

BM #12 Spot on conc. bridge rail 11' Lt. sta. 119+37 Elev. 499.29
BM #13 31" Maple 33' Lt. sta. 126+57 Elev. 501.40

ENOSBURG - BAKERSFIELD
Project F no. 181(3)
Sheet 14 of 112 sheets

14