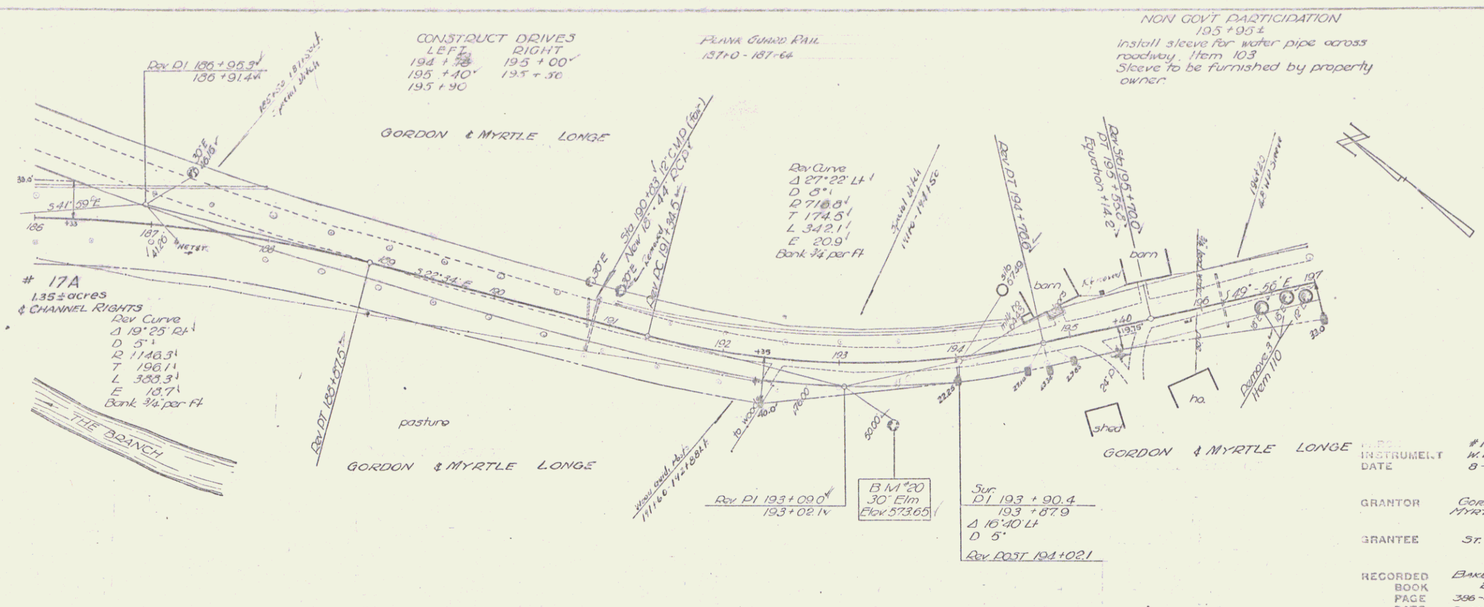

INSTRUMENT	#17 A&B
	M.D.O.E.
DATE	8-28-51
GRANTOR	Gordon K. & Myrtle Longe
GRANTEE	St. of Vt.
RECORDED	Bakersfield
BOOK	26
PAGE	386-87
DATE	9-14-51
REMARKS:-	

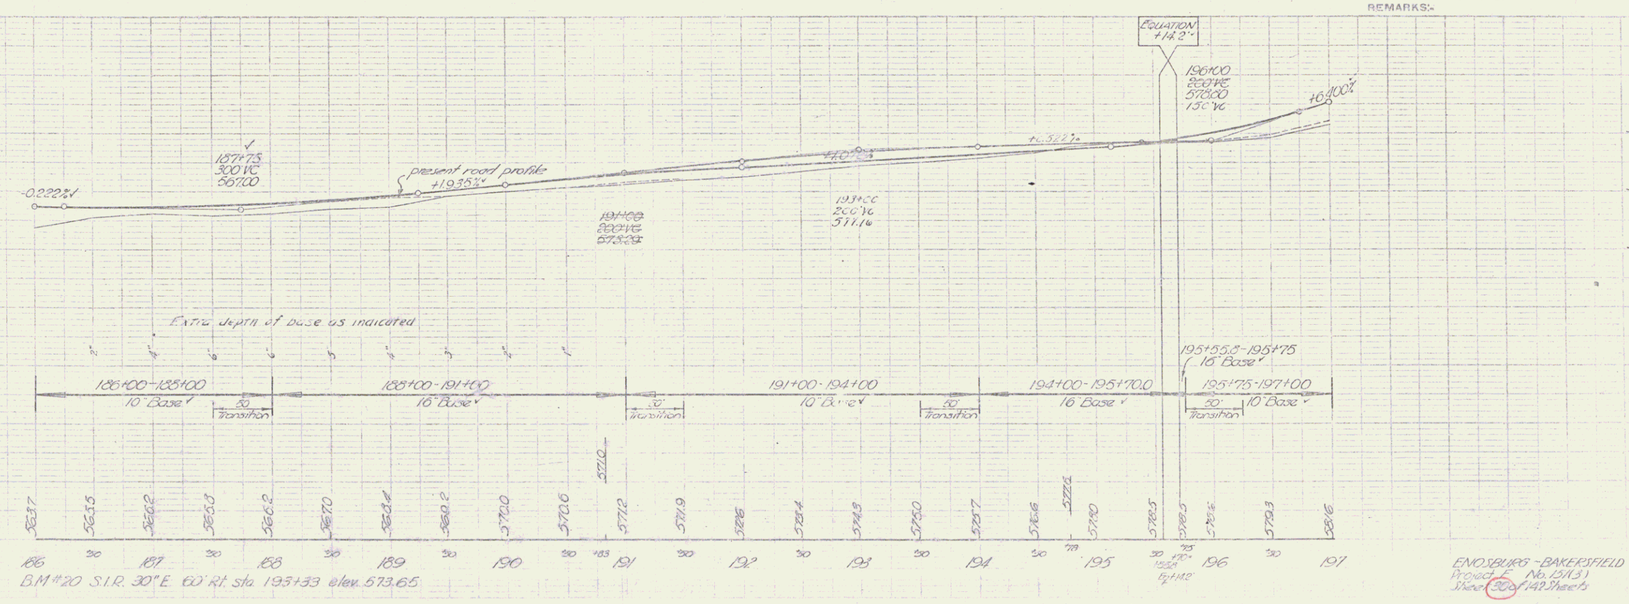

ENOSBURG - BAKERSFIELD
Project No. 1513
Sheet 30 of 149 Sheets

21