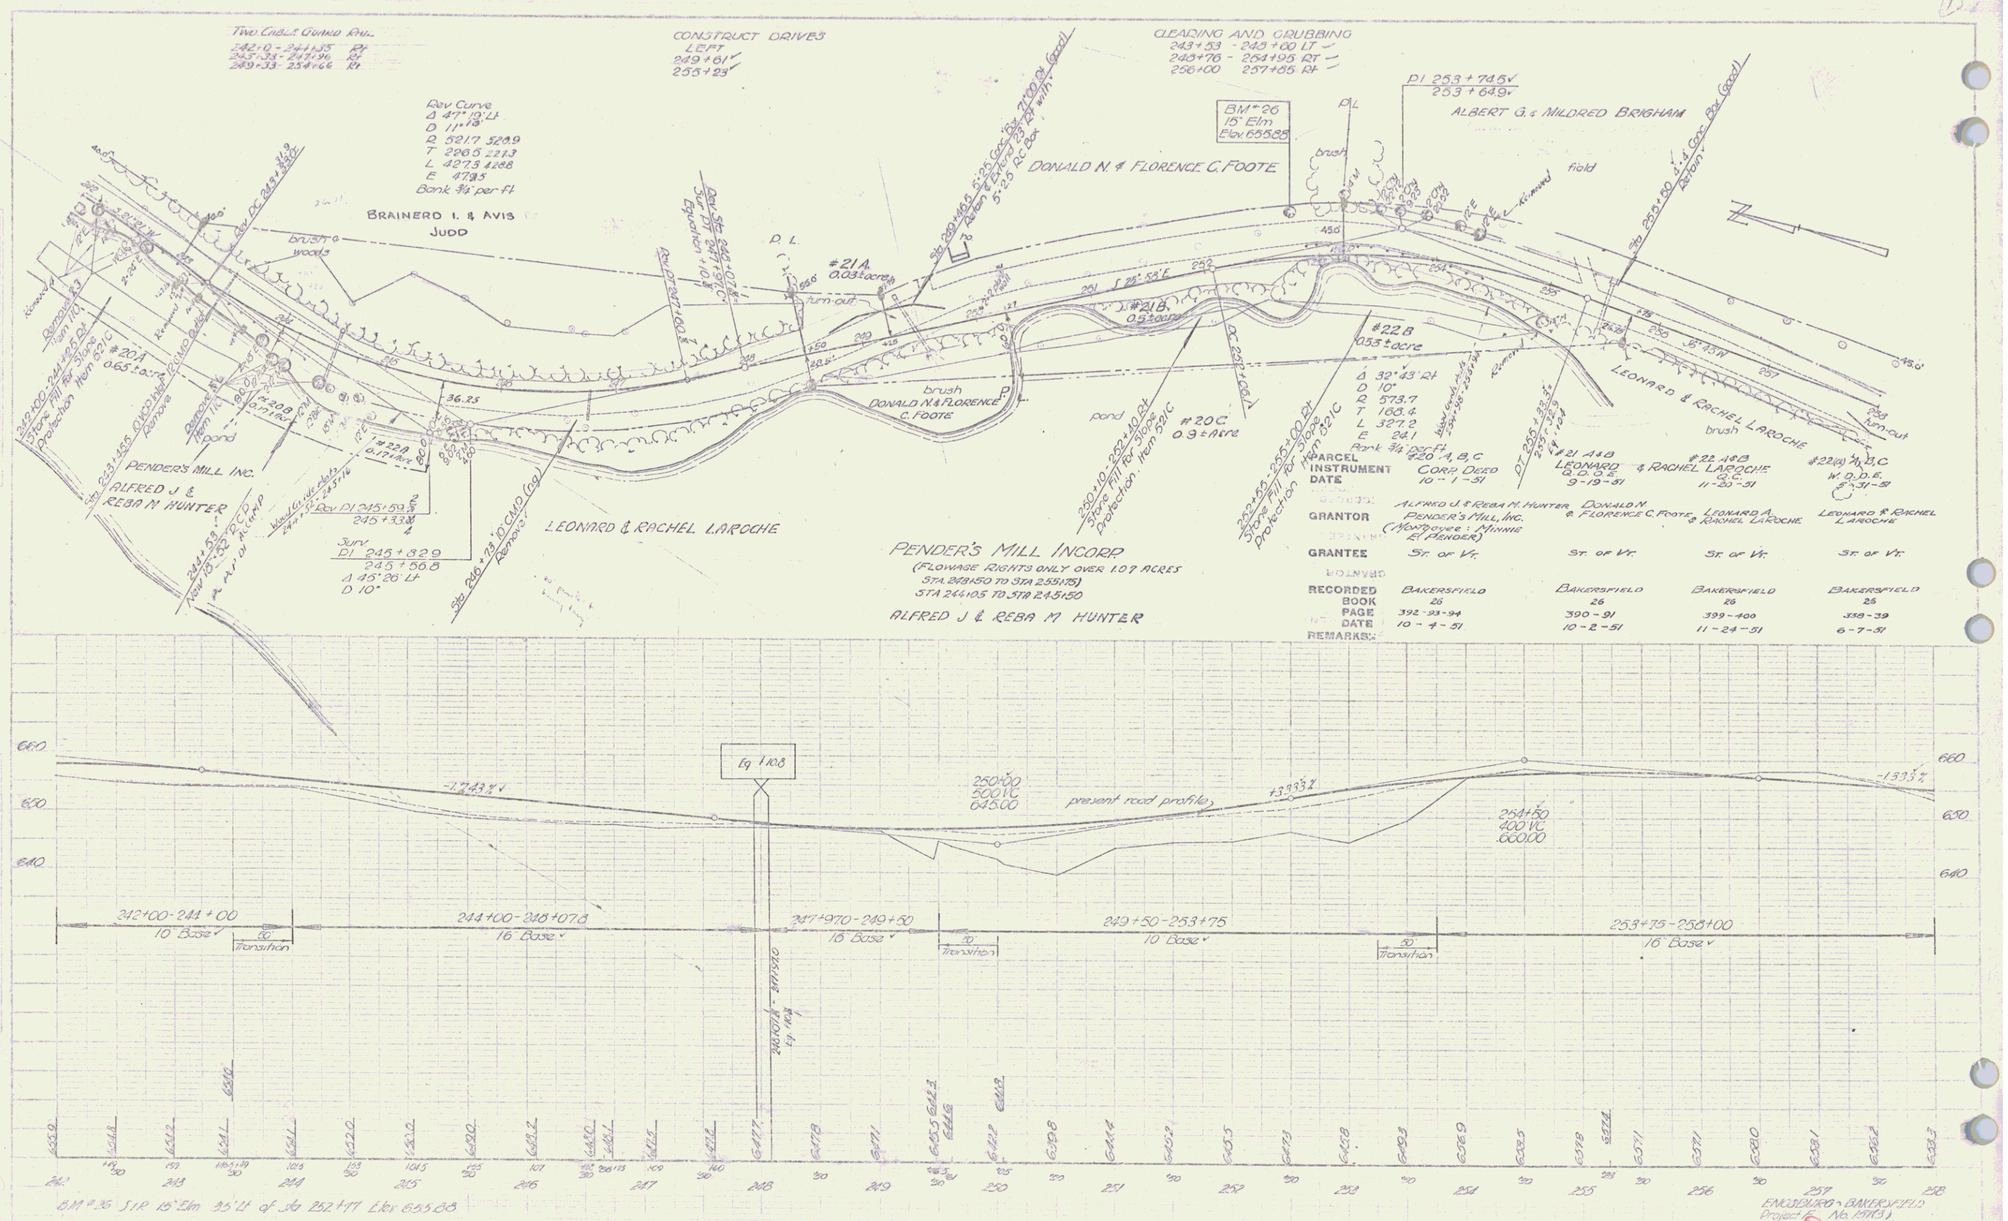
Two Cable Guard Rail
242+10 - 244+35 Rt
245+33 - 247+96 Rt
249+33 - 254+66 Rt
CONSTRUCT DRIVES
LEFT
249+61
255+29
CLEARING AND GRUBBING
243+53 - 249+00 LT
249+76 - 254+95 RT
256+00 - 257+85 Rt
Rev Curve
Δ 47° 19' Lt
D 11° 13'
R 521.7 524.9
T 226.5 221.3
L 427.3 428.8
E 47.95
Bank 3/4" per ft
BRAINERD I. & AVIS JUDD
DONALD N. & FLORENCE C. FOOTE
BM #26
15" Elm
Elev 655.88
P.I. 253+74.5
253+64.9
ALBERT G. & MILDRED BRIGHAM
#21A
0.03 ± acre
#21B
0.5 ± acre
#22B
0.55 ± acre
Δ 32° 43' Rt
D 10°
R 573.7
T 168.4
L 327.2
E 24.1
Bank 3/4" per ft
#20A
0.65 ± acre
#20B
0.14 ± acre
#20C
0.9 ± acre
PENDER'S MILL INC.
ALFRED J. & REBA M. HUNTER
LEONARD & RACHEL LAROCHE
PENDER'S MILL INCORP.
(FLOWAGE RIGHTS ONLY OVER 1.09 ACRES
STA 243+50 TO STA 255+75)
STA 244+05 TO STA 245+50
ALFRED J. & REBA M. HUNTER
PARCEL
INSTRUMENT
DATE
GRANTOR
GRANTEE
RECORDED
BOOK
PAGE
DATE
REMARKS:
#20 A, B, C
CORR DEED
10 - 1 - 51
ALFRED J. & REBA M. HUNTER
PENDER'S MILL, INC.
(MONTAGUE I. MINNIE E. PENDER)
St. of Vt.
BAKERSFIELD
26
392 - 93 - 94
10 - 4 - 51
#21 A & B
LEONARD
Q.D.D.E.
9 - 19 - 51
DONALD N. & FLORENCE C. FOOTE
St. of Vt.
BAKERSFIELD
26
390 - 91
10 - 2 - 51
#22 A & B
& RACHEL LAROCHE
Q.C.
11 - 20 - 51
LEONARD A. & RACHEL LAROCHE
St. of Vt.
BAKERSFIELD
26
399 - 400
11 - 24 - 51
#22(a) 1/2 Int. C
W.D.D.E.
8 - 31 - 51
LEONARD & RACHEL LAROCHE
St. of Vt.
BAKERSFIELD
26
338 - 39
6 - 7 - 51
Eq 1108
-1.743%
+3.333%
-1.335%
250+00
500 VC
645.00
254+50
400 VC
660.00
present road profile
242+00 - 244+00
10' Base
50 Transition
244+00 - 248+07.8
16' Base
247+97.0 - 249+50
16' Base
50 Transition
249+50 - 253+75
10' Base
50 Transition
253+75 - 256+00
16' Base
BM #26 S.I.R. 15" Elm 35' Lt of Sta 252+77 Elev 655.88
Sheet 26 of 142 Sheets

26