NRS
150 1933 6 28

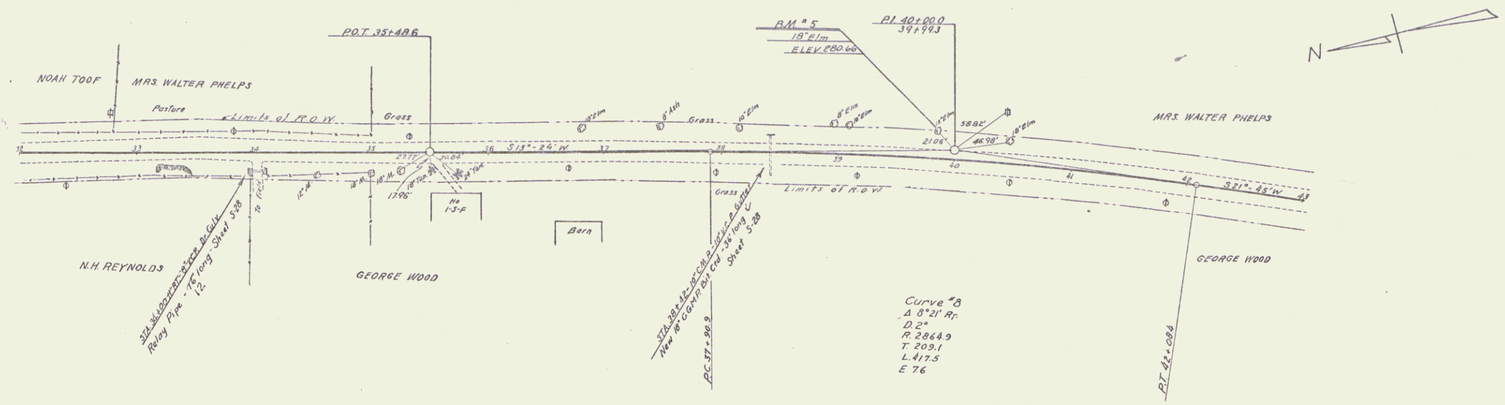

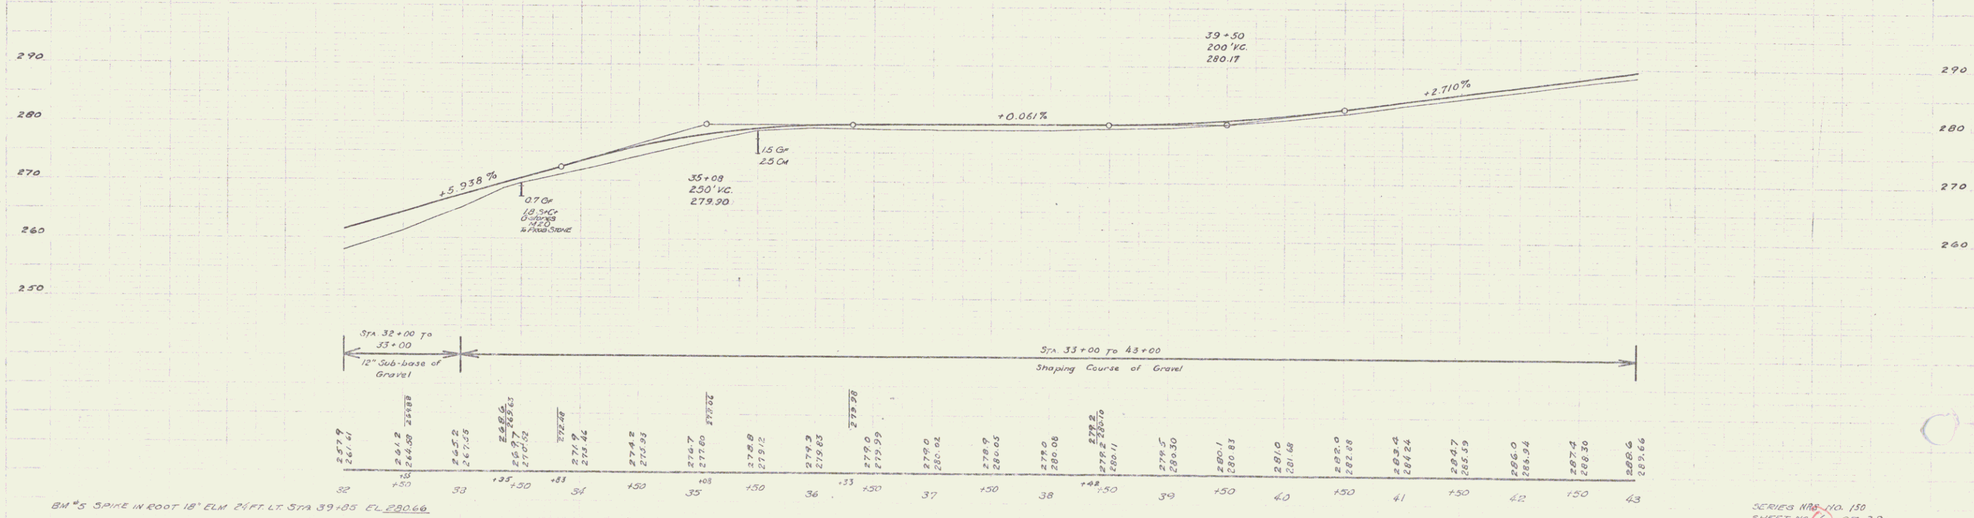

BM #5 SPIKE IN ROOT 18" ELM 26 FT. LT. STA 39+85 EL. 280.66

SERIES NRS NO. 150
SHEET NO. 6 OF 28

4