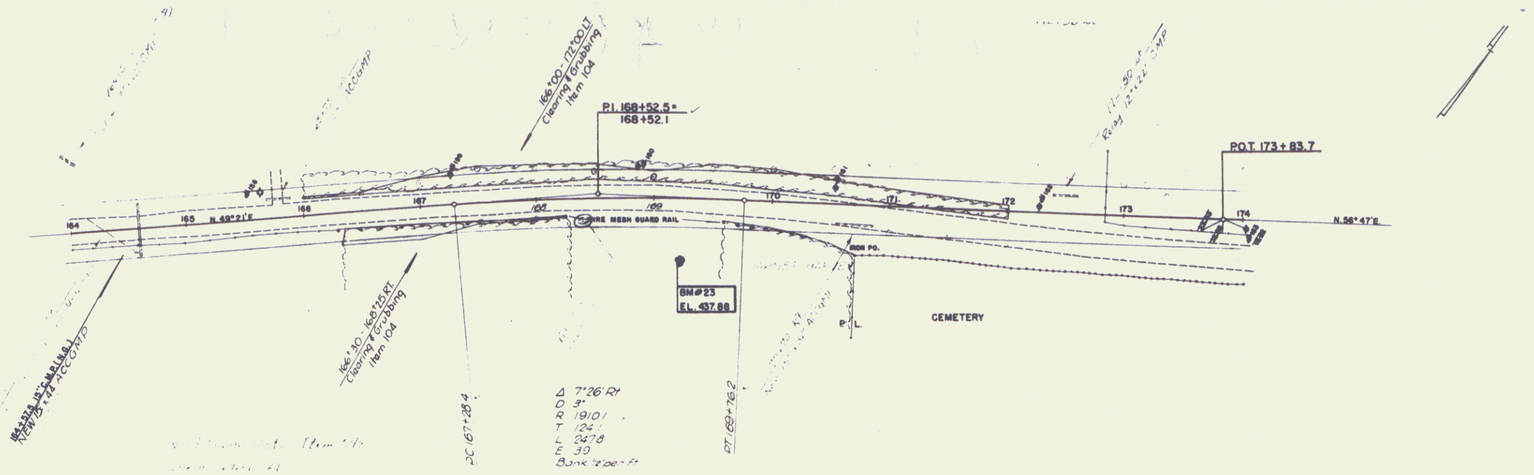

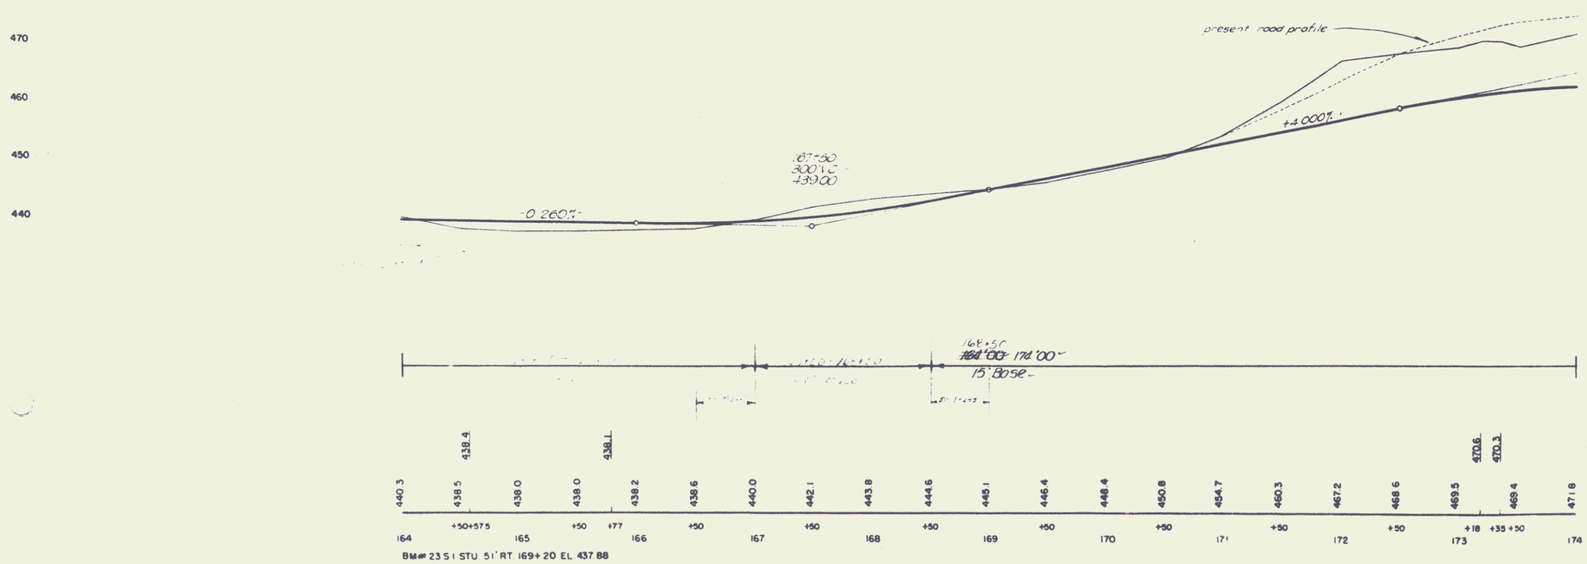

BERKSHIRE
PROJECT S. NO. 2
SHEET 16 OF

10

TRACED JR 9/53