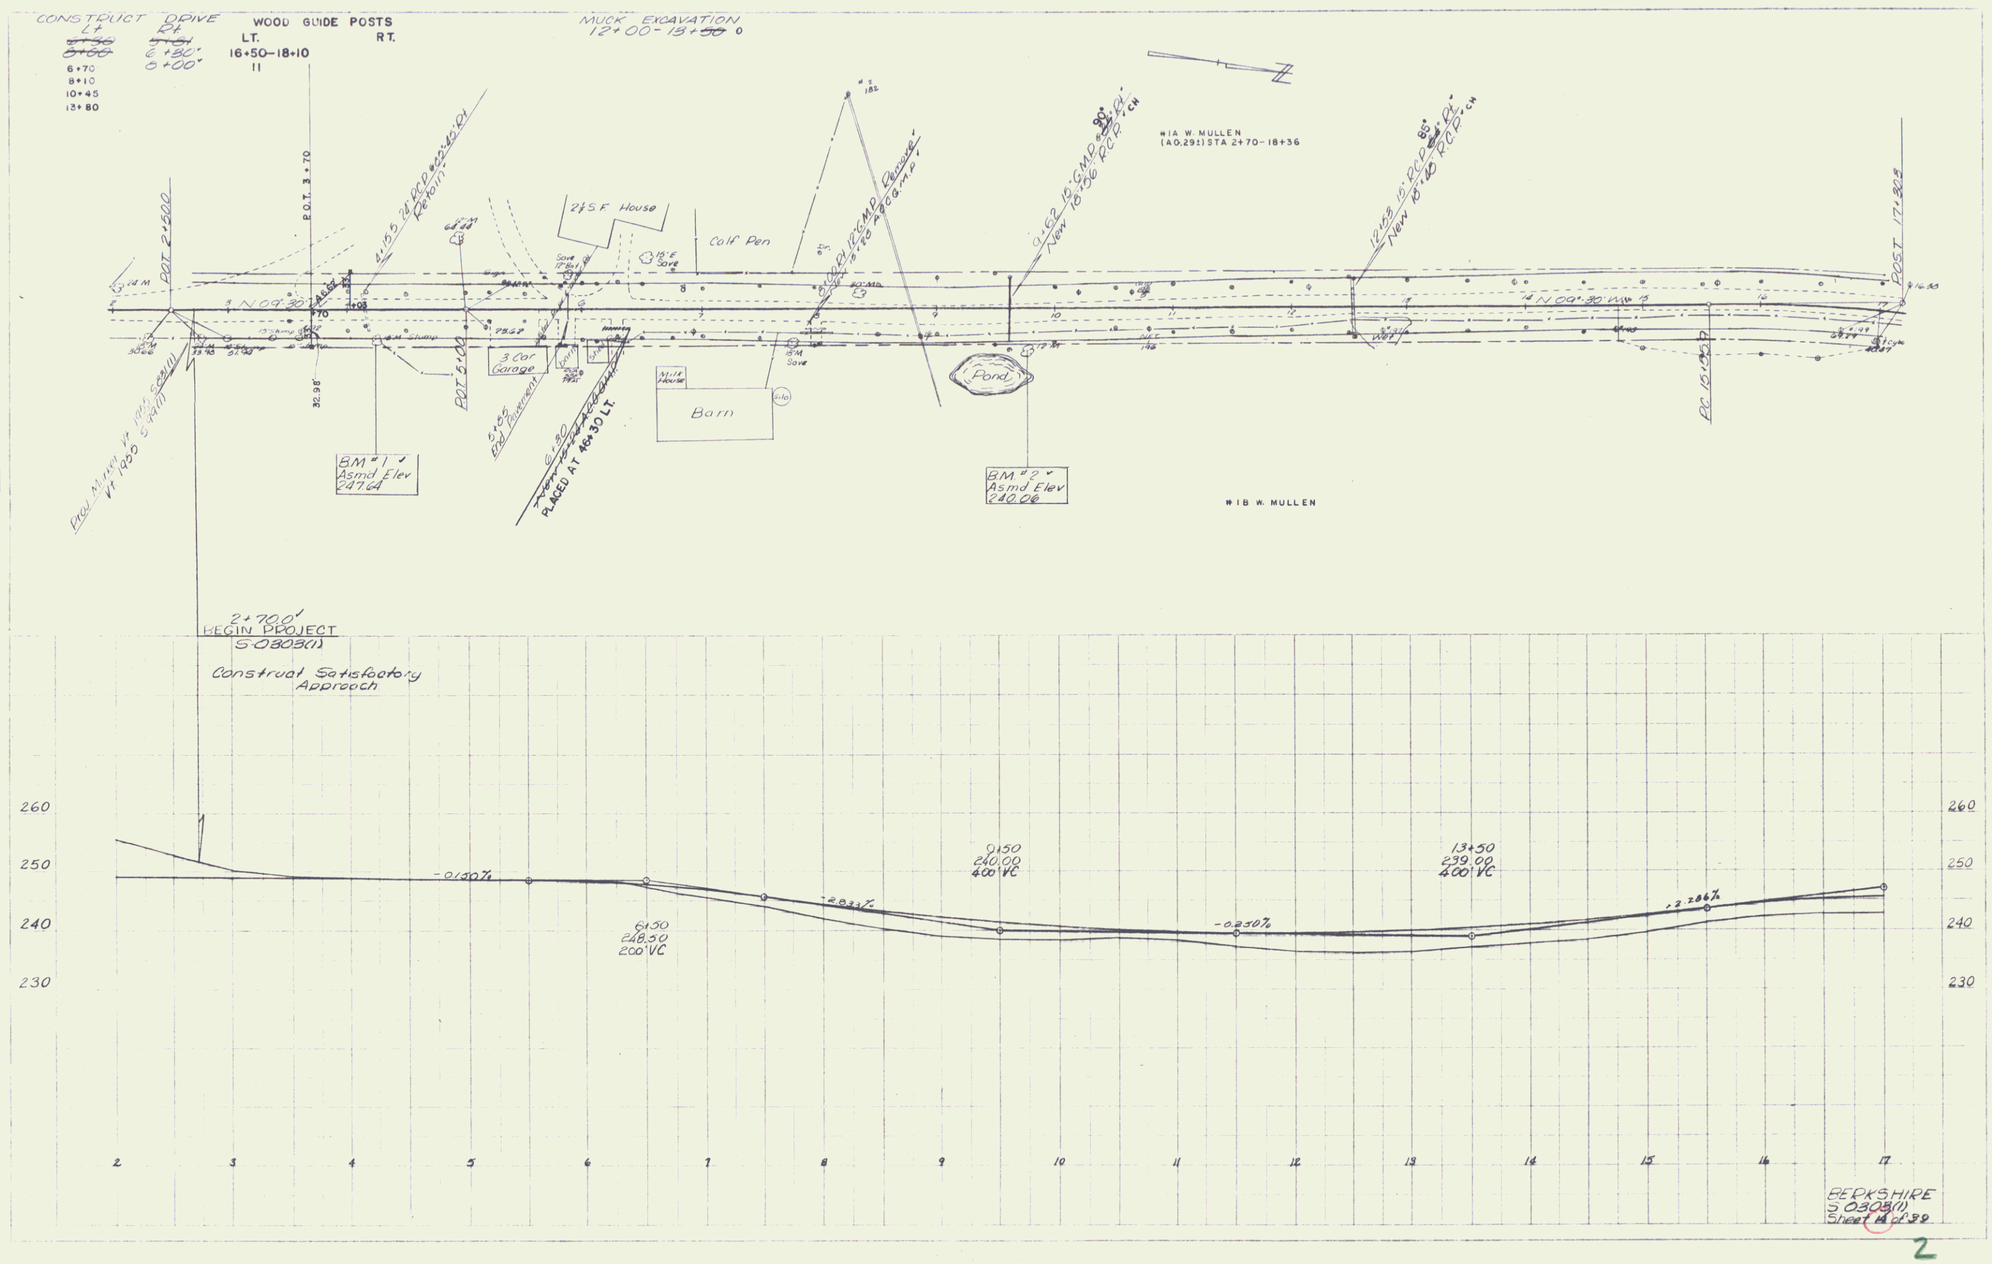
CONSTRUCT DRIVE
Lt. Rt.
6+70 6+80'
8+10 5+00'
10+45
13+80
WOOD GUIDE POSTS
LT. RT.
16+50-18+10
11
MUCK EXCAVATION
12+00-13+50
#1A W. MULLEN
(A0.29±) STA 2+70-18+36
2½ S.F. House
Calf Pen
3 Car Garage
Milk House
Barn
Pond
BM #1
Asmd Elev
247.64
BM #2
Asmd Elev
240.06
PLACED AT 46+30 LT.
#1B W. MULLEN
2+700'
BEGIN PROJECT
S-0303(1)
Construct Satisfactory Approach
-0.130%
6+50
248.50
200' VC
-2.833%
9+50
240.00
400' VC
-0.230%
13+50
239.00
400' VC
-2.286%
BERKSHIRE
S-0303(1)
Sheet 14 of 39
2