TWO CABLE GUARD RAIL

LEFT	RIGHT
28+83–32+00	28+42–32+00

~~Lt~~ Rt
19 + 35 — 19+~~50~~20
22+70±

WOOD GUIDE POSTS
Lt — Rt
~~28+96–32+0~~ — ~~28+96–32+0~~

MUCK EXCAVATION
18+~~50~~–19+~~50~~ 25
0

DRILLING AND BLASTING OF SOLID ROCK SUBGRADE
19+50–20+00

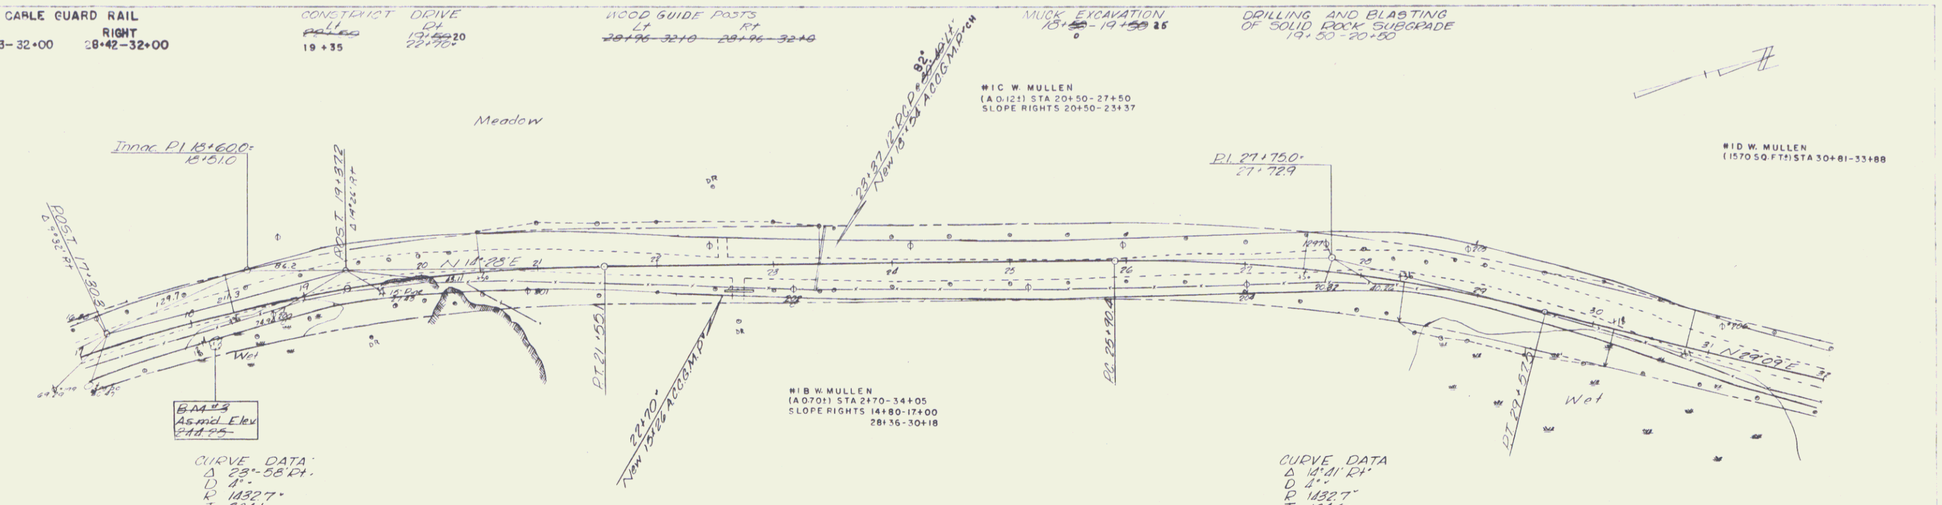

CURVE DATA:
Δ 23°-58' Rt.
D 4°-
R 1432.7'
T 304.1'
L 599.2'
E 31.9'
Bank 9/16" per ft.

CURVE DATA
D 4°-
R 1432.7'
T 184.6'
L 367.1'
E 11.8'
Bank 9/16" per ft.

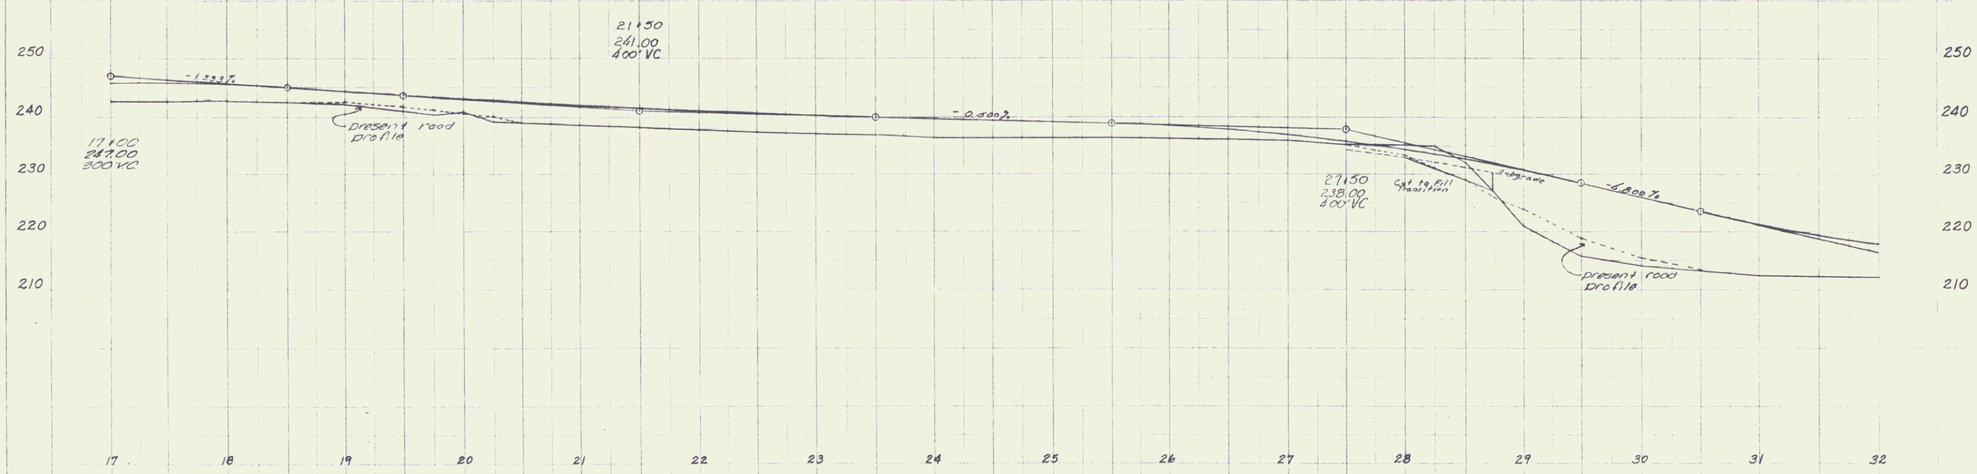

BERKSHIRE
50B02(1)
Sheet 15 of 39

3