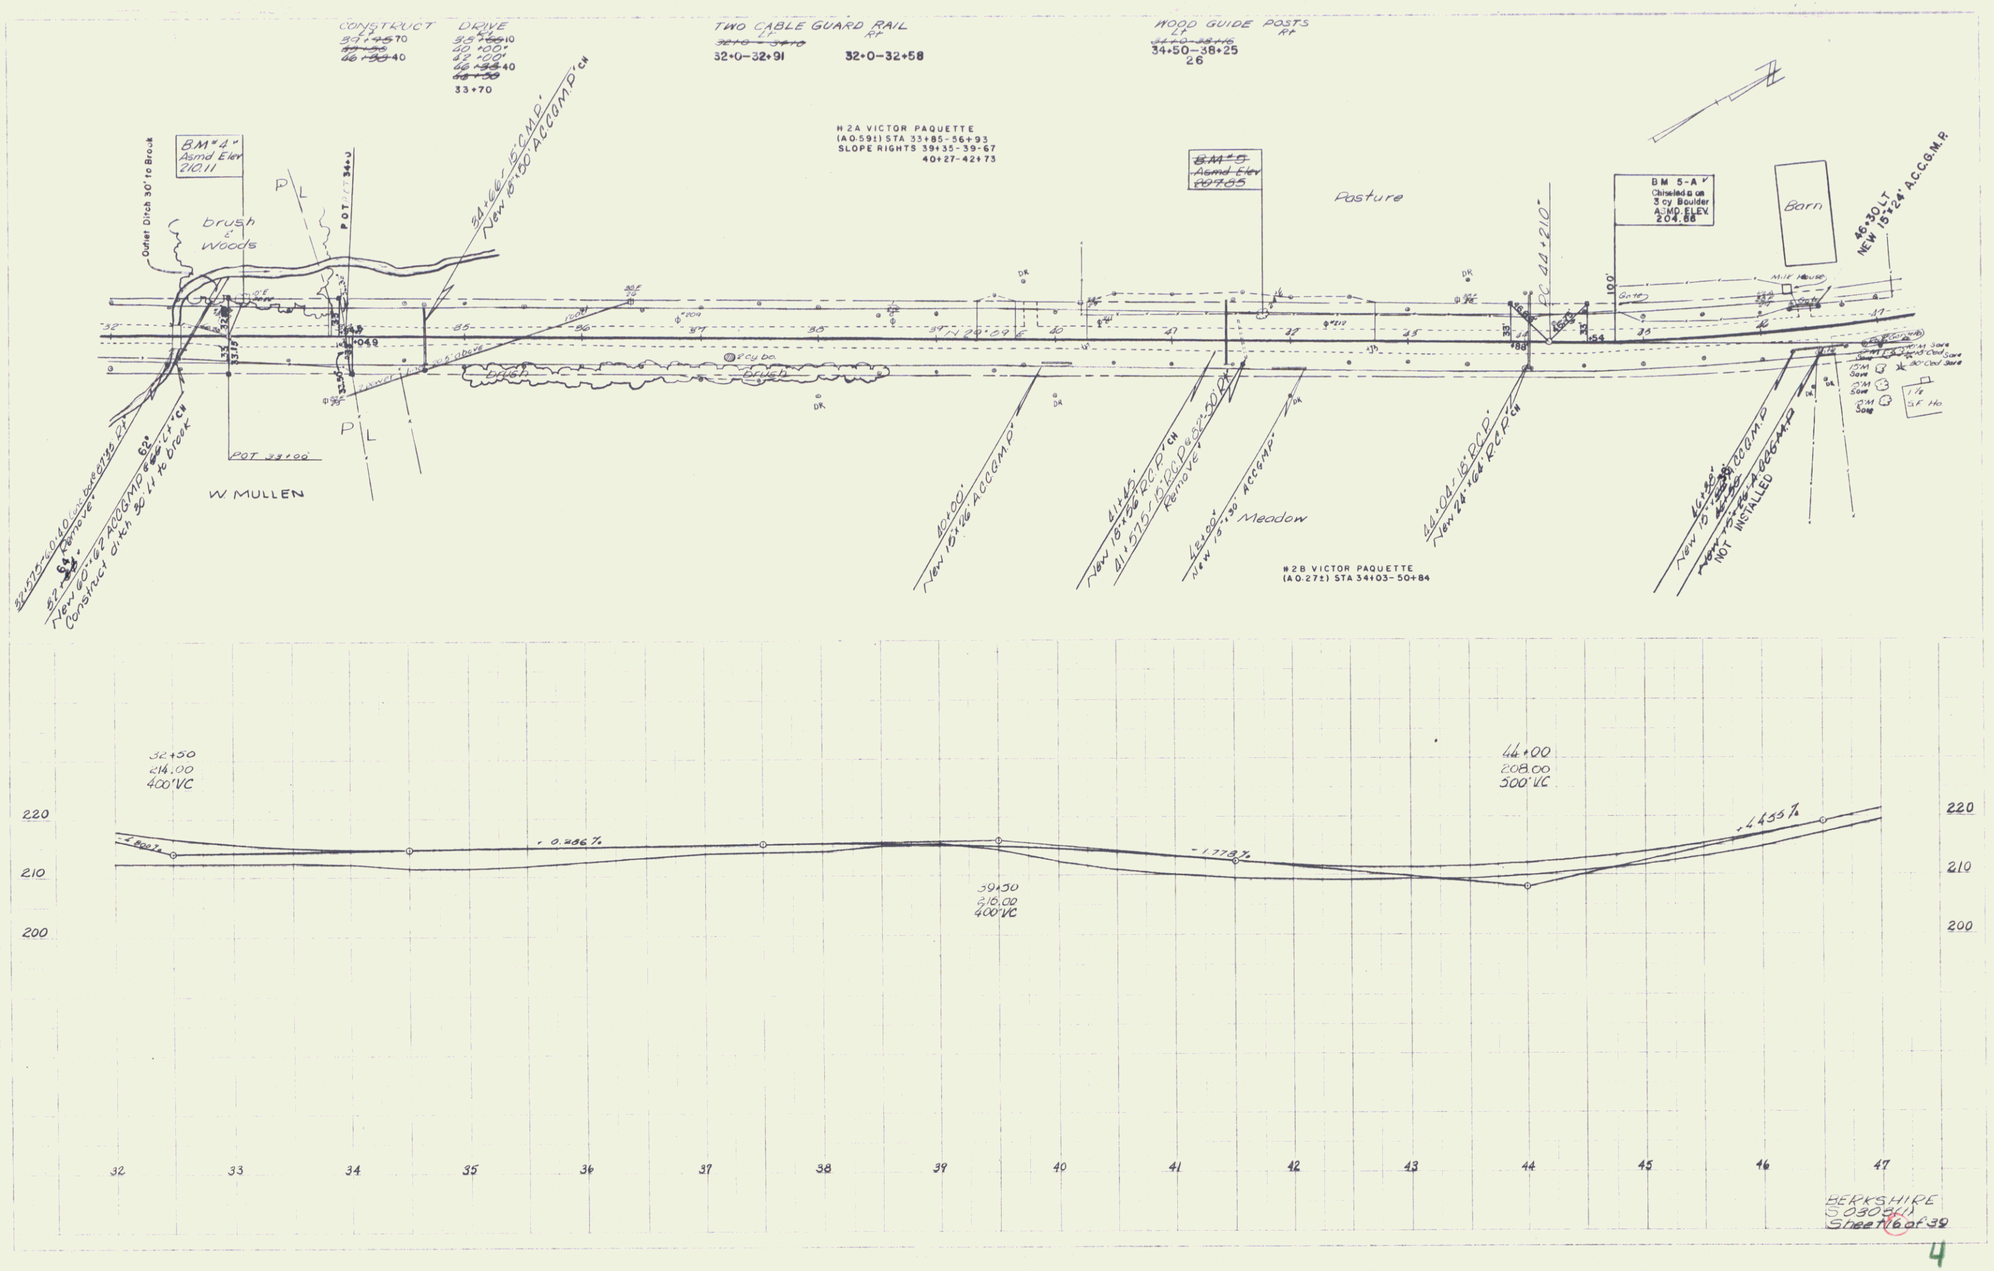
CONSTRUCT DRIVE
TWO CABLE GUARD RAIL
32+0-32+91
32+0-32+58
WOOD GUIDE POSTS
34+50-38+25
26
33+70
H 2A VICTOR PAQUETTE
(A0.591) STA 33+85-56+93
SLOPE RIGHTS 39+35-39-67
40+27-42+73
BM "4"
Asmd Elev
210.11
Outlet Ditch 30' to Brook
brush & Woods
P L
POT 33+00
W MULLEN
Pasture
BM 5-A
Chiseled cross
3 cy Boulder
ASMD ELEV.
204.68
Barn
Meadow
H 2B VICTOR PAQUETTE
(A0.271) STA 34+03-50+84
NOT INSTALLED
32+50
214.00
400' VC
39+50
210.00
400' VC
44+00
208.00
300' VC
-1.800%
+0.286%
-1.778%
+1.455%
220
210
200
32
33
34
35
36
37
38
39
40
41
42
43
44
45
46
47
BERKSHIRE
S0305(1)
Sheet 16 of 39
4