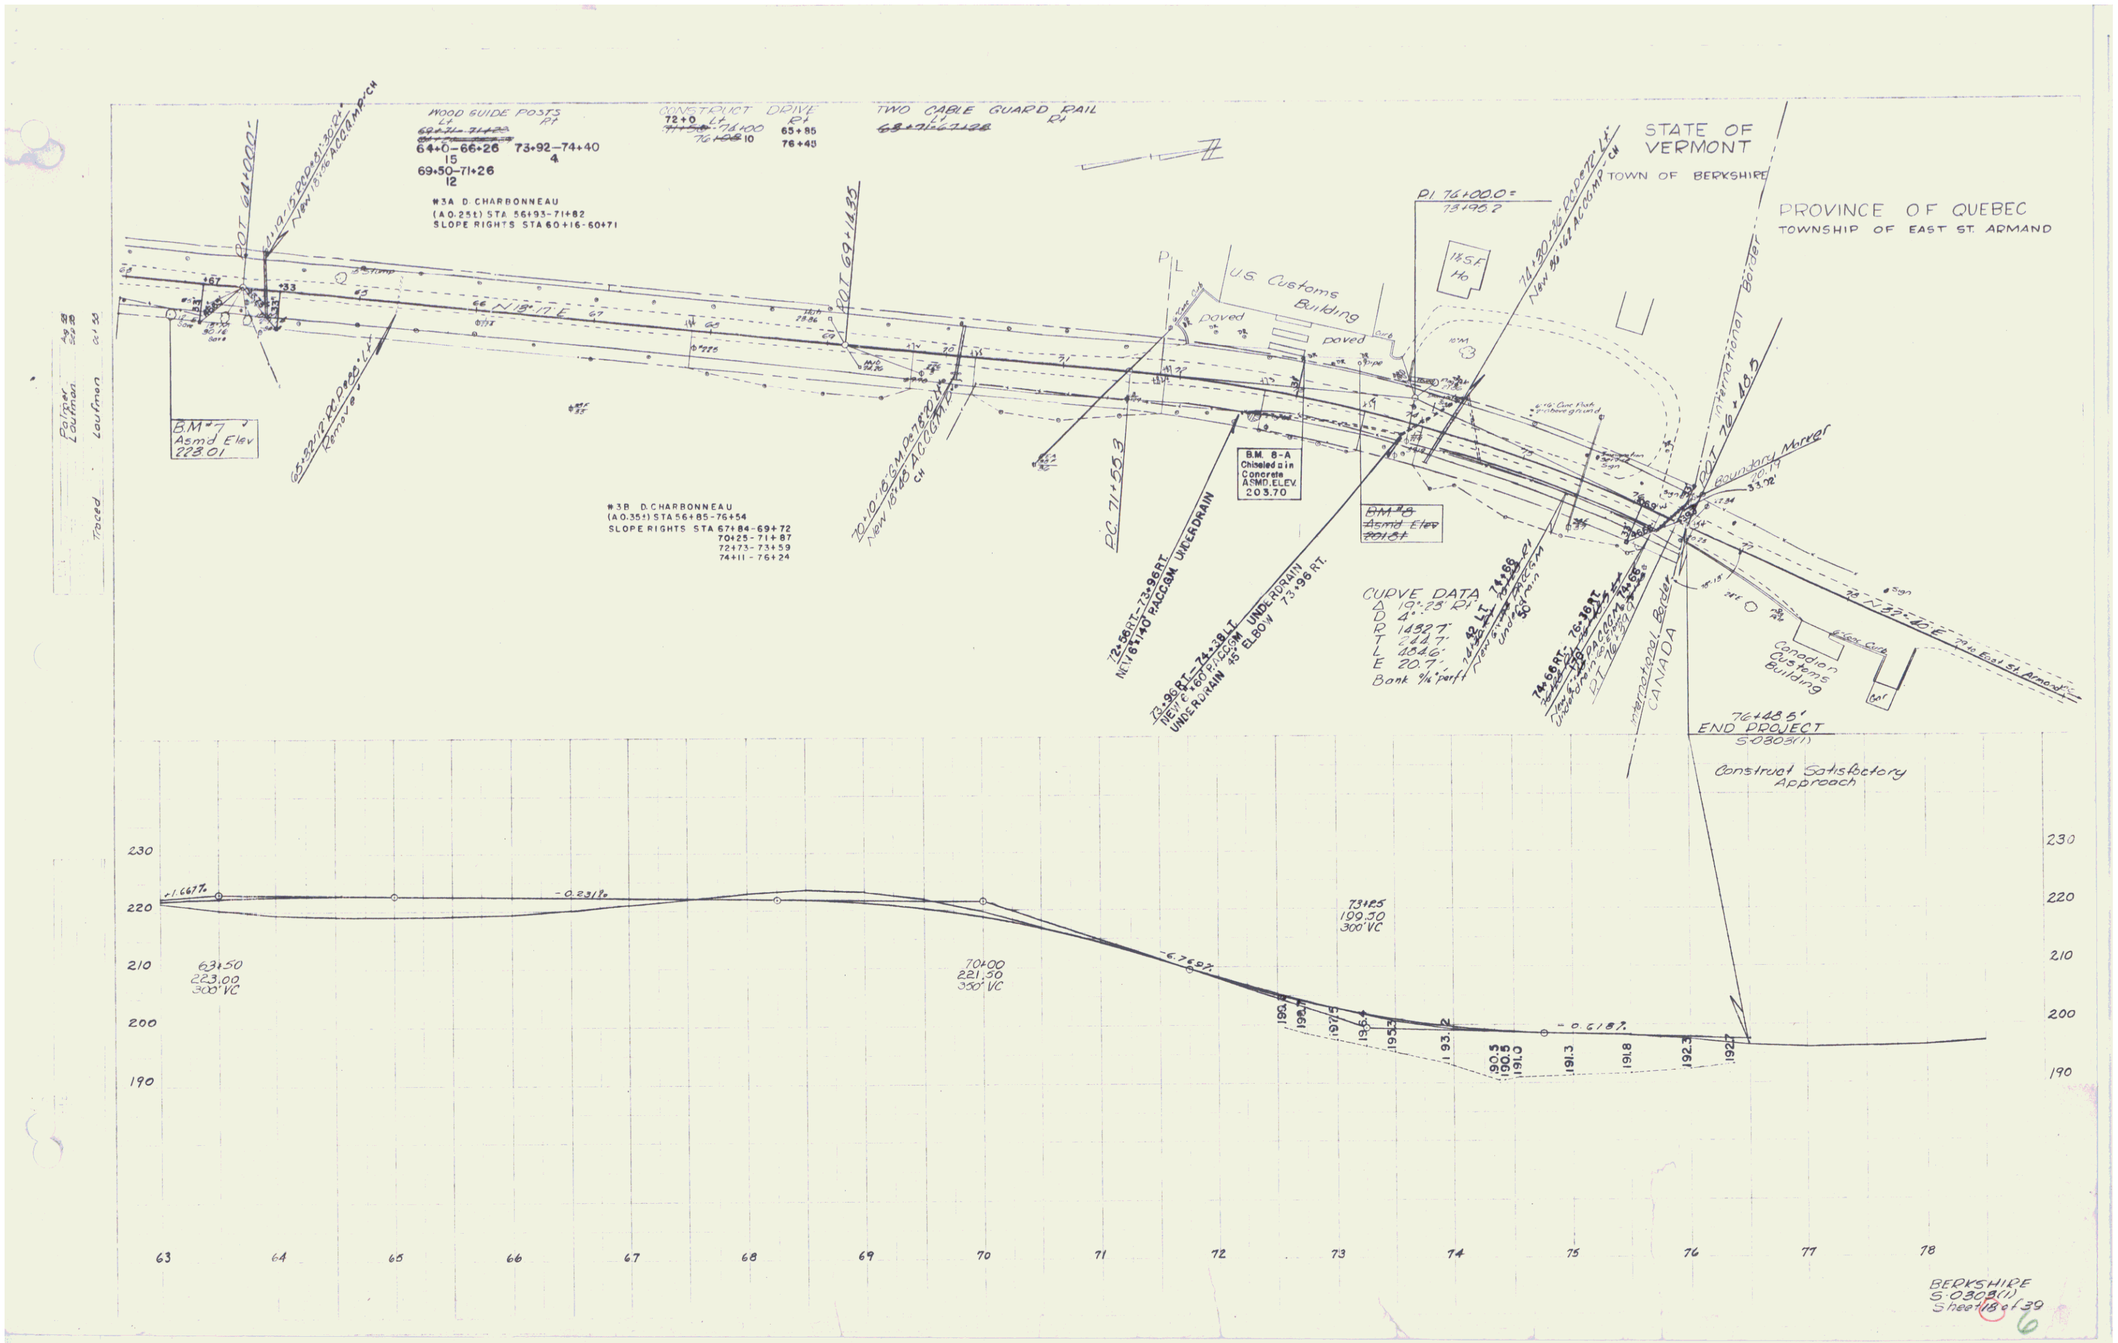
WOOD GUIDE POSTS
64+0-66+26 73+92-74+40
69+50-71+26
#3A D. CHARBONNEAU
(A 0.25±) STA 56+93-71+82
SLOPE RIGHTS STA 60+16-60+71
CONSTRUCT DRIVE
72+0 LT. 74+00 65+85
76+45
TWO CABLE GUARD RAIL
STATE OF VERMONT
TOWN OF BERKSHIRE
PROVINCE OF QUEBEC
TOWNSHIP OF EAST ST. ARMAND
U.S. Customs Building
paved
BM #7
Asmd Elev
223.01
#3B D. CHARBONNEAU
(A 0.35±) STA 56+85-76+54
SLOPE RIGHTS STA 67+84-69+72
70+25-71+87
72+73-73+59
74+11-76+24
B.M. 8-A
Chiseled x in
Concrete
ASMD. ELEV.
203.70
PC 71+55.3
CURVE DATA
Δ 19°23' Rt
D 4°
R 1432.7'
T 244.7'
L 484.6'
E 20.7'
Bank 4% Perf
Boundary Marker
Canadian Customs Building
CANADA
76+48.5'
END PROJECT
S-0303(1)
Construct Satisfactory Approach
73+25
100.50
300' VC
63+50
223.00
300' VC
70+00
221.50
300' VC
-1.667%
-0.231%
-6.76%
-0.618%
230
220
210
200
190
63
64
65
66
67
68
69
70
71
72
73
74
75
76
77
78
BERKSHIRE
S-0303(1)
Sheet 18 of 39