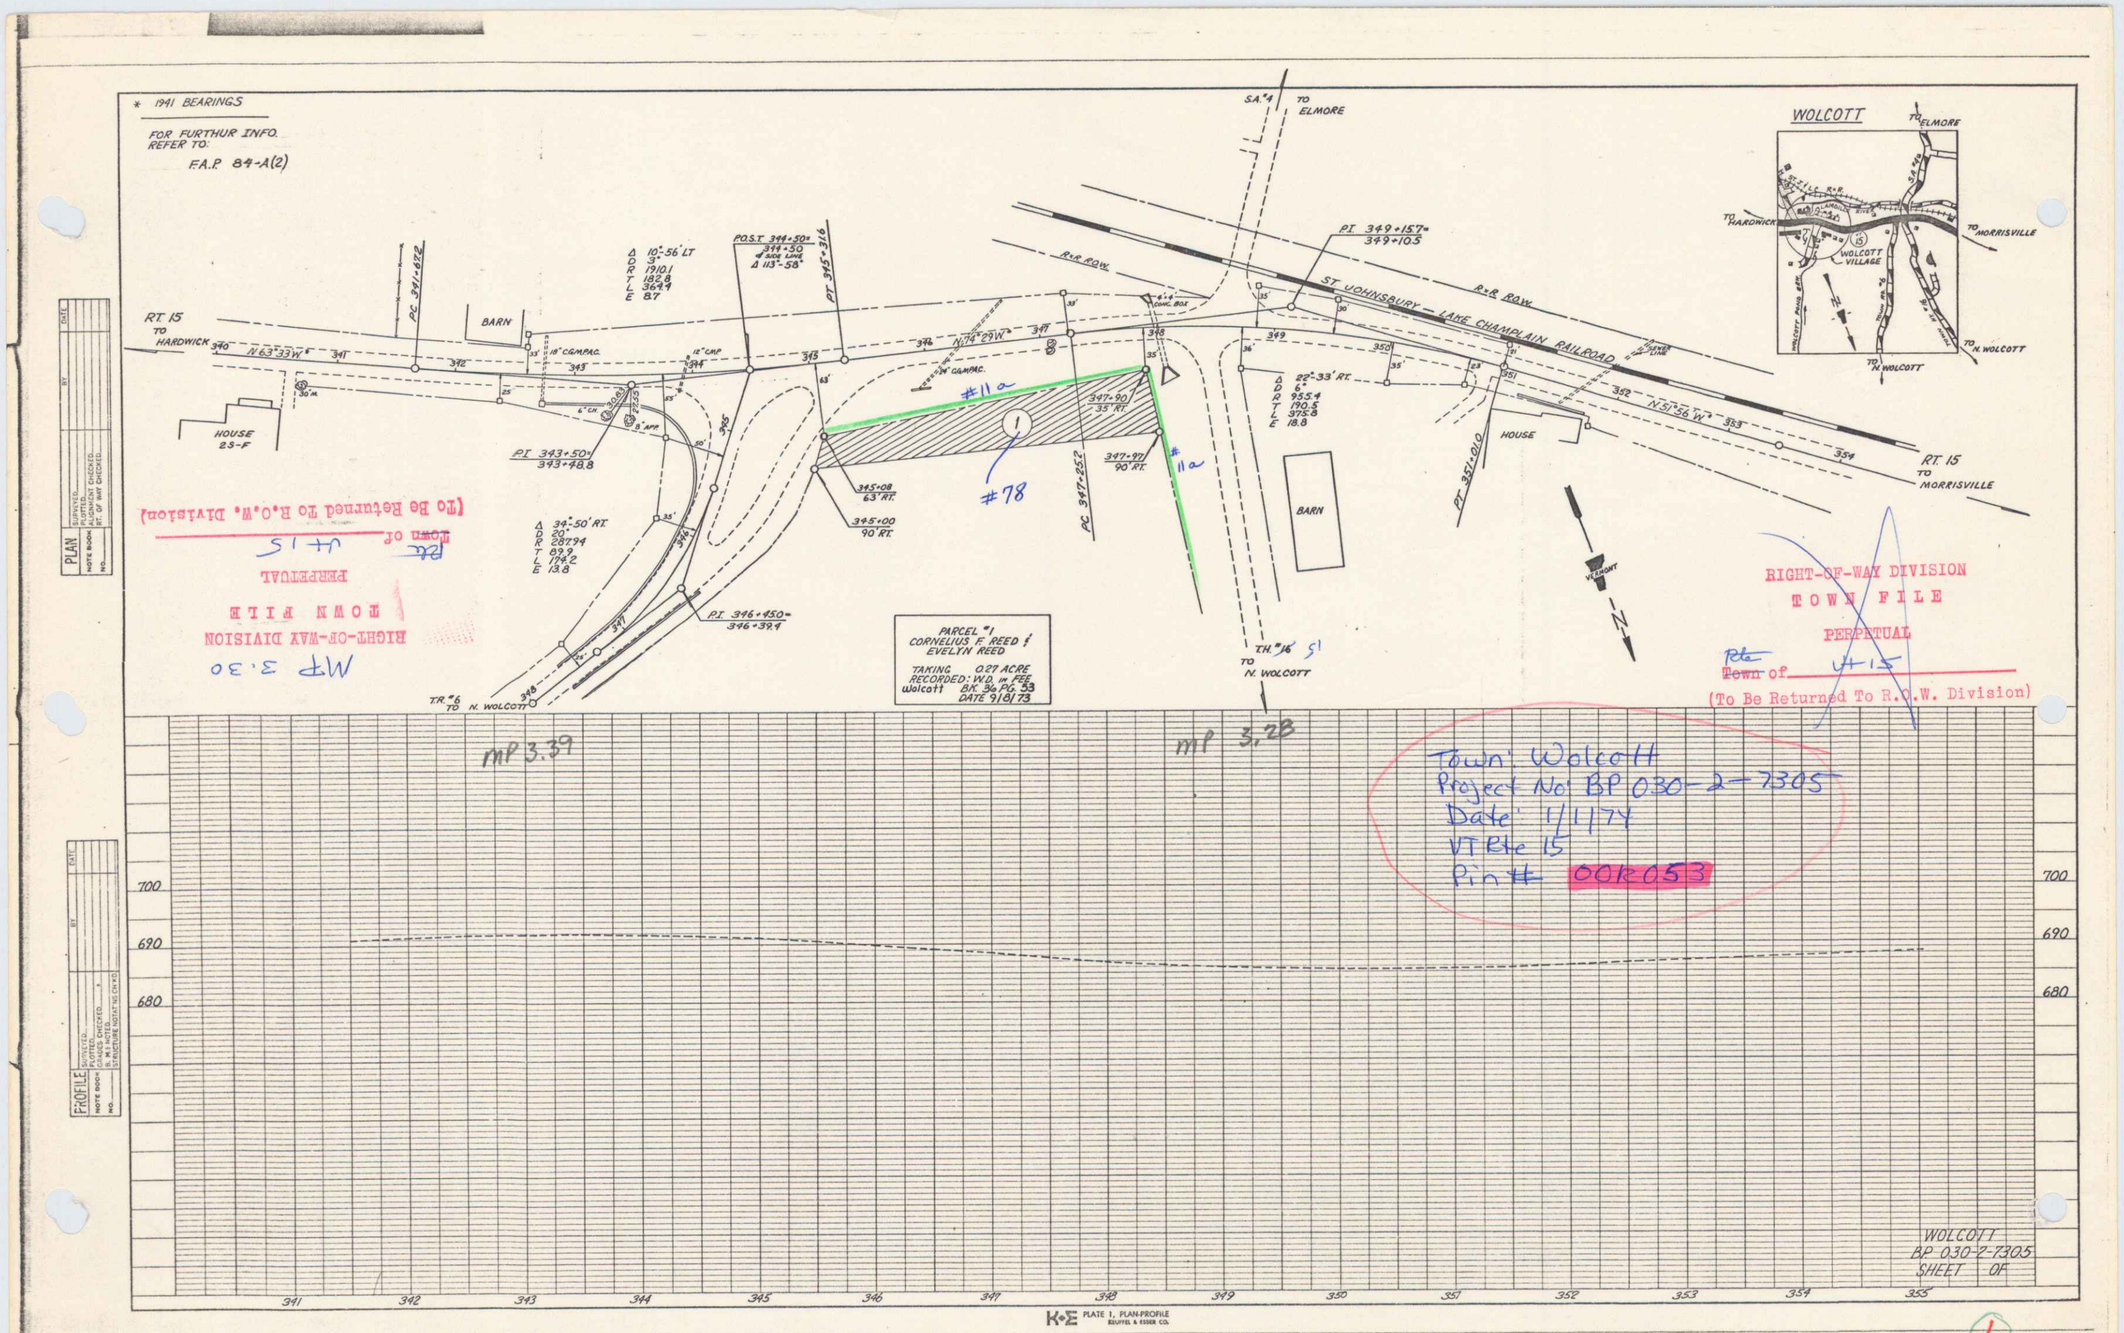
* 1941 BEARINGS
FOR FURTHUR INFO. REFER TO:
F.A.P. 84-A(2)
WOLCOTT
TO ELMORE
TO HARDWICK
TO MORRISVILLE
WOLCOTT VILLAGE
TO N. WOLCOTT
S.A. #4 TO ELMORE
R.R. ROW
ST JOHNSBURY — LAKE CHAMPLAIN RAILROAD
RT. 15 TO HARDWICK
RT. 15 TO MORRISVILLE
BARN
HOUSE 25-F
HOUSE
PC 341+87.2
PT 345+31.6
P.O.S.T. 344+50= 344+30 ∢ 30.0 LINE Δ 113°-58'
Δ 10°-56' LT
D 3°
R 1910.1
T 182.8
L 364.4
E 8.7
PI 349+15.7= 349+10.5
N 63°-33' W
N 74°-29' W
N 51°-56' W
PI 343+50= 343+48.8
Δ 34°-50' RT.
D 20°
R 287.94
T 89.9
L 174.2
E 13.8
P.I. 346+45.0= 346+39.4
T.R. #6 TO N. WOLCOTT
#11a
#78
347+90 - 35' RT.
347+97 90' RT.
345+08 63' RT.
345+00 90' RT.
PC 347+25.2
Δ 22°-33' RT.
D 6°
R 955.4
T 190.5
L 375.8
E 18.8
PT 351+01.0
TH #16 TO N. WOLCOTT
VERMONT
N
PARCEL #1
CORNELIUS F. REED & EVELYN REED
TAKING 0.27 ACRE
RECORDED: W.D. or FEE
Wolcott BK. 36 PG. 53
DATE 9/8/73
MP 3.39
MP 3.28
MP 3.30
RIGHT-OF-WAY DIVISION
TOWN FILE
PERPETUAL
Rte 15
Town of
(To Be Returned To R.O.W. Division)
Town: Wolcott
Project No: BP 030-2-7305
Date: 1/1/74
VT Rte 15
Pin # 00R053
PLAN
PROFILE
700
690
680
341
342
343
344
345
346
347
348
349
350
351
352
353
354
355
WOLCOTT
BP 030-2-7305
SHEET OF
K+E PLATE 1, PLAN-PROFILE
KEUFFEL & ESSER CO.
46 7012 IMPERIAL TRACING CLOTH